


40°22'30"

Latitude

Longitude

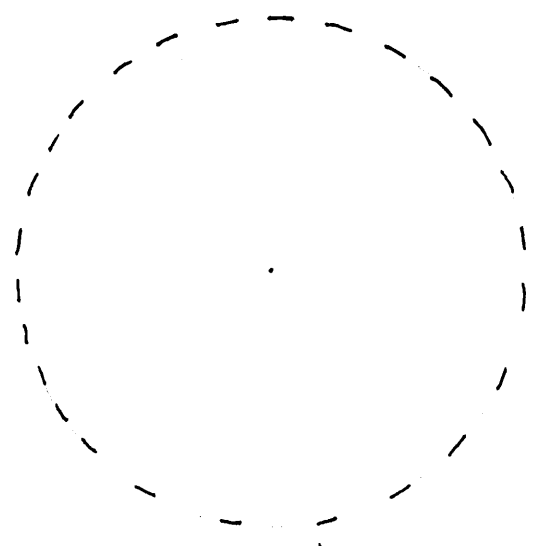

General Loc.
Not Entered in data base

Topo Location

7.5' Loc. _____ 15' Loc. _____
(calc.) _____

Company Laballo IW
Farm Laballo Iron Works # 3
15' Quad _____
(sec.)
7.5' Quad Steuernullo East
District Cross Creek

WELL LOCATION PLAT

County 009 **Permit** 70059

LA BELLE IRON WORKS
FERGUSON FIELD.
POLLANSBEE.

Not located.

Cross Creek District, Brooke County, W. Va.

All 50 wells completed in 1908-09.

No. 4 was a gas well; all others were oil producers, from Berea Sand.

Well No.	Date of Completion.	Date of Abandonment.	Depth.	Thickness of Pay Sand.
1	Feb. 12, 1908	Feb. 19, 1919	1274	15
2	Mar. 17, 1908		1326	17
70059 3	Mar. 28, 1908	
4	Apr. 23, 1908	Sept. 1919	1355	10
5	Apr. 21, 1908	June 20, 1919	1335	17
6	Apr. 29, 1908	July 26, 1920	1310	11
7	May 15, 1908	Aug. 6, 1921	1318	20
8	May 8, 1908		1317	12
9	May 2, 1908	Nov. 1918	1350	13
10	May 2, 1908	1916	1343	19
11	June 1908	Dec. 1918	1323	20
12	June 10, 1908	Nov. 11, 1918	1338	12
13	June 13, 1908	Oct. 1918	1332	18
14	May 27, 1908	June 6, 1919	1330	16
15	June 3, 1908	Dec. 10, 1918	1316	19
16	June 12, 1908	July 26, 1913	1314	19
17	June 8, 1908		1343	15
18	June 5, 1908	Dec. 1, 1909	1345	19
19	June 15, 1908		1328	17
20	June 24, 1908	1913	1313	19
21	June 16, 1908	1918	1352	23
22	June 23, 1908	Dec. 1919	1342	17
23	June 20, 1908	Nov. 5, 1919	1332	18
24	July 1, 1908	Nov. 28, 1919	1337	18
25	July 6, 1908	Nov. 21, 1918	1343	20
26	July 8, 1908	Jan. 28, 1919	1314	22
27	July 9, 1908	Jan. 25, 1919	1363	26
28	July 10, 1908	Nov. 16, 1918	1341	17
29	July 16, 1908	1909	1346	20
30	July 30, 1908		1346	24
31	Aug. 14, 1908	Nov. 20, 1919	1312	18
32	Sept. 14, 1908	1913	1366	23
33	Aug. 8, 1908		1332	18
34	Aug. 19, 1908		1331	20
35	Aug. 14, 1908	1915	1329	14
36	Aug. 29, 1908	1912	1360	26
37	Oct. 2, 1908		1388	19
38	Oct. 28, 1908	May 18, 1920	1587	20
39	Oct. 30, 1908		1669	20
40	June 16, 1909	July 1919	1475	21
41	Nov. 1909		1334	18
42	Dec. 1908	Oct. 1919	1477	22
43	Nov. 27, 1908		1641	21
44	Dec. 30, 1908		1337	23
45	Jan. 27, 1909	Feb. 28, 1920	1375	22
46	June 5, 1909	July 5, 1919	1346	21
47	1908	Jan. 20, 1919	1389	20
48	1908	July 1919	1580	18
49	Nov. 18, 1909		1375	20
50	Nov. 19, 1909	Jan. 22, 1920	1434	20

ID: COUNTY: (009) PERMIT: 70059 SUFFIX: Ø REASSIGNED COUNTY/PERMIT #: CROSS CUBE

COMPLETION INFO: ELEVATION: ELEVATION TYPE: COMP FLAG: LOCATION INFO: TAX DISTRICT: ()

CLASSIFICATION: DATES: MM/DD /YYYY RIG TYPE: 7.5' LATITUDE (DDMM.M Miles South)

INITIAL: SPUD: 7 / 7 WELL TYPE: LONGITUDE (DDMM.M Miles West)

FINAL: COMP: 3/28/1908 COMP METH: QUADRANGLE: ()

FIELD: () BATCH: YEAR RPTD: ++++++

OPEN GAS-BEFORE TREATMENT (MGFPD): OIL-BEFORE TREATMENT (BOPD): 15' LATITUDE (DDMM Miles South)

FLOW: GAS-AFTER TREATMENT (MGFPD): OIL-AFTER TREATMENT (BOPD): LONGITUDE (DDMM Miles West)

ROCK NATURAL (PSI): TIME (NATURAL, IN HOURS): QUADRANGLE: ()

PRESSURE: TREATED (PSI): TIME (TREATED, IN HOURS): 5' SECTION: ()

DEPTHS: TOTAL FOOTAGE: NEW FOOTAGE: EXPLORATORY FOOTAGE:

DEEPEST FORMATION: AT TOTAL DEPTH: () DEEPEST FORMATION TESTED: ()

OWNERS: INFO: STATUS: (C) DATE: (MM/DD/YYYY): 3/28/1908 SURFACE OWNER: La Belle Iron Works 3

OPERATOR CODE: () -NAME: OIL&GAS OWNER: COMPANY NUMBER: ()

OGWATER (INCLUDE QUALITY, DEPTH, QUANTITY) if available:

PAYS INFO: ACTIVITY PRODUCT TOP FORMATION TOP DEPTH BOTTOM DEPTH BOTTOM FORMATION BEFORE AFTER

STRAT INFO: FORMATION FM Q DEPTH (depth for thick) DEPTH QUALITY THICKNESS THICKNESS QUALITY ELEVATION TYPE