


Latitude

Longitude

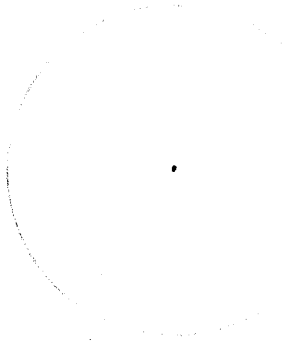

General Loc.
Location NOT
Entered into
database

Topo Location

7.5' Loc. _____ 15' Loc. _____
(calc.) _____

Company Pemo Oil Co

Farm Wells Hrs #4

15' Quad _____
(sec.)

7.5' Quad Tiltonsville

District Buffalo

WELL LOCATION PLAT

County 009 Permit 70231

WELLS HEIRS NO. 3 WELL.

Not located.

now
70229

Buffalo District, Brooke County, W. Va.
 Reno Oil Co.
 Completed, Sept. 2, 1913.
 8" casing, 275'; 5", 1500'.
 Shot Sept. 9th with 20 qts.:
 140 bbls.

	Top.	Bottom.
Top of Berea Sand (pay, 1832')	1821	
Total depth		1842

70231

WELLS HEIRS NO. 4 WELL.

Not located.

Completed, Sept. 13, 1913.
 8" casing, 90'; 6", 1300'.
 Shot, Sept. 15, with 40 qts.
 40 bbls.

	Top.	Bottom.
Coal		40
Top of Berea Sand (pay, 1646')	1635	
Total depth		1654

X
 Buffalo District, Brooks County, W. Va.
 Rockledge Oil Co.
 Beech Bottom Pool.
 Drilled in Sept. 13, 1911.

NO W 70231

Top of Berea Sand, 1635'.

Gas and oil at 12' in sand.

About $\frac{3}{8}$ ' good sand with light gas.

Pumped about 30 bbls. in 24 hrs.

Top of Salt Sand, 830'.

Top of Injun Sand, 982'; bottom of Injun, 1290'.

Good gas in Kenner Sand.

Ten bailers water an hour with gas.

	Top.	Bottom.
Salt Sand	830	
Big Injun Sand (gas)	982	1290
Berea Sand (gas and oil, 1647'-1650½')	1635	-(1650½)±