


Latitude 39° 05'

Longitude 81° 05'

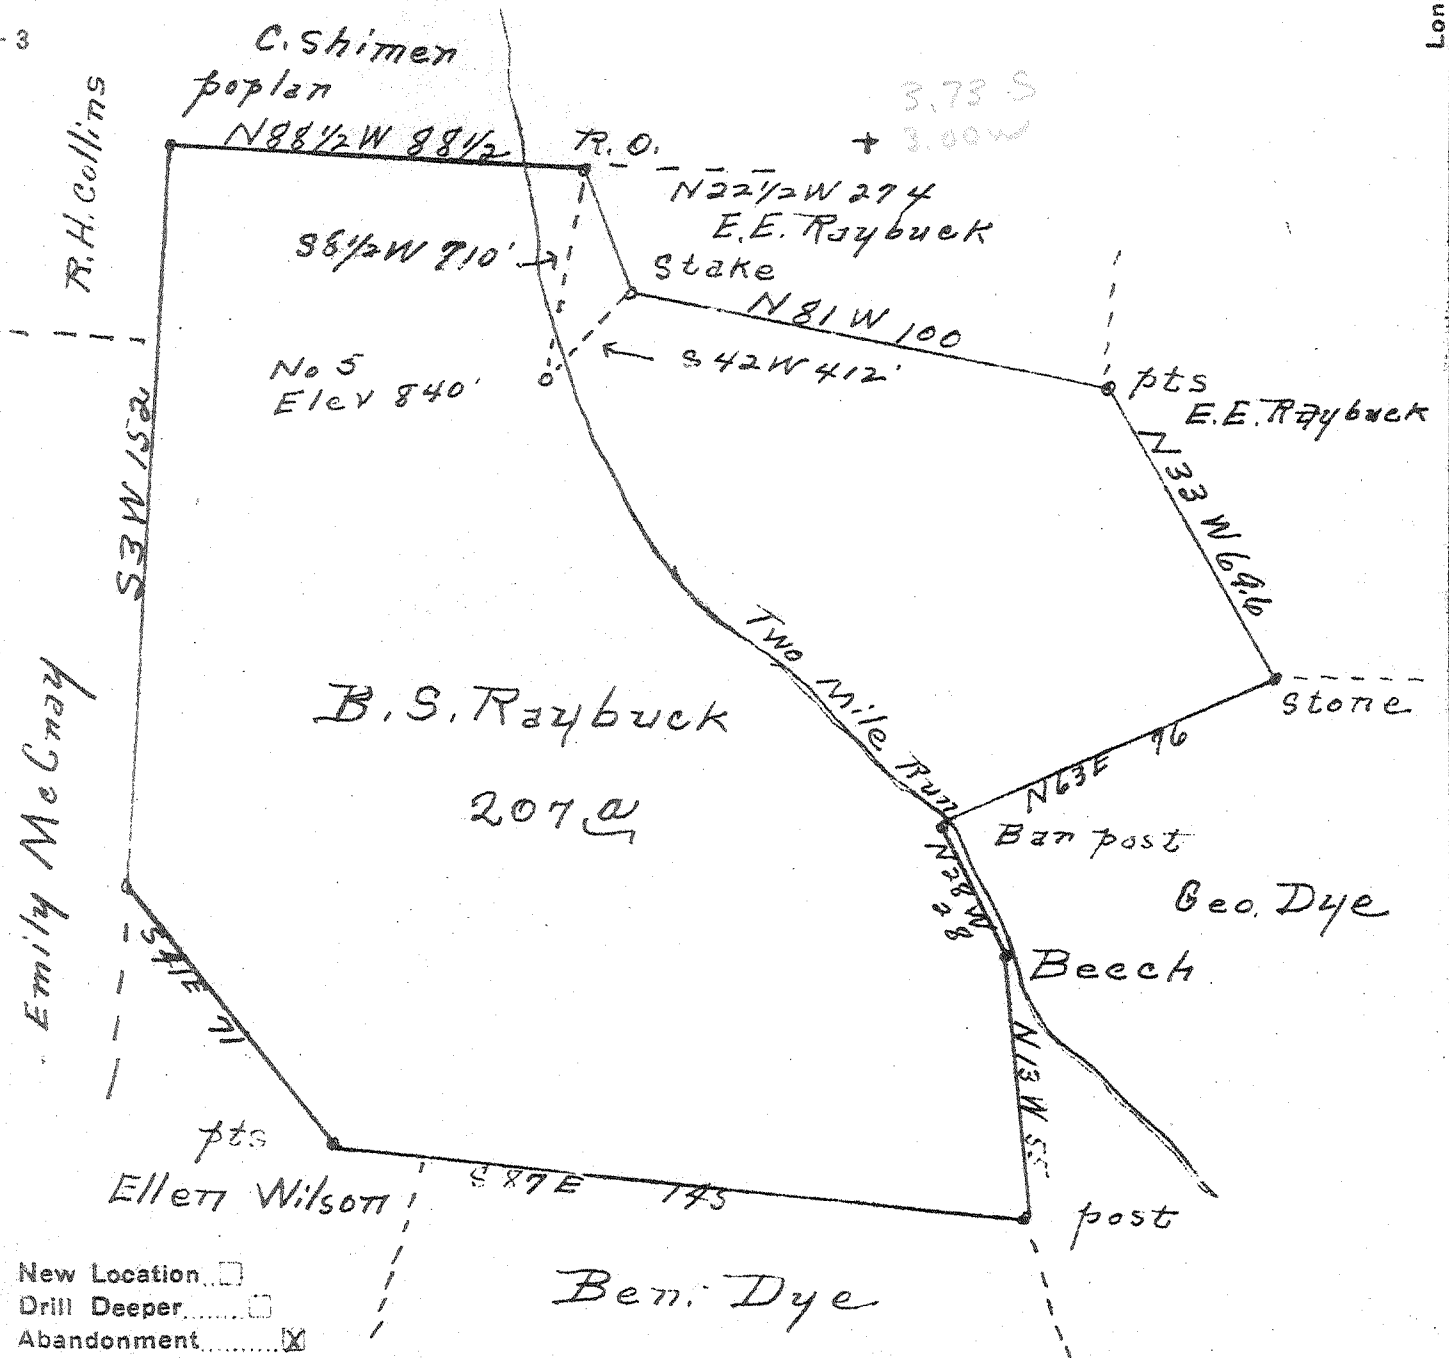

New Location   
 Drill Deeper   
 Abandonment

Company Richter Oil Co  
 Address Brookland, W. Va.  
 Farm B.S. Raybuck  
 Tract \_\_\_\_\_ Acres 207 Lease No. \_\_\_\_\_  
 Well (Farm) No. 5 Serial No. \_\_\_\_\_  
 Elevation (Spirit Level) 840'  
 Quadrangle Hannistville  
 County Calhoun District Sheridan  
 Engineer Wacey Dexter  
 Engineer's Registration No. \_\_\_\_\_  
 File No. \_\_\_\_\_ Drawing No. \_\_\_\_\_  
 Date 5-31-47 Scale 1" = 40 poles

STATE OF WEST VIRGINIA  
 DEPARTMENT OF MINES  
 OIL AND GAS DIVISION  
 CHARLESTON

WELL LOCATION MAP  
 FILE NO. CAH-224-A

+ Denotes location of well on United States Topographic Maps, scale 1 to 62,500, latitude and longitude lines being represented by border lines as shown.

- Denotes one inch spaces on border line of original tracing.



384

STATE OF WEST VIRGINIA  
DEPARTMENT OF MINES  
OIL AND GAS DIVISION

WELL RECORD

Oil or Gas Well (KIND)

Permit No. 204-A

Company Richter Oil Company  
 Address Brohard, W. Va.  
 Farm B. S. Raybuck Acres 207  
 Location (waters) \_\_\_\_\_  
 Well No. 5 Elev. 840  
 District Sheridan County Calhoun  
 The surface of tract is owned in fee by \_\_\_\_\_  
 Address \_\_\_\_\_  
 Mineral rights are owned by \_\_\_\_\_  
 Address \_\_\_\_\_  
 Drilling commenced \_\_\_\_\_  
 Drilling completed \_\_\_\_\_  
 Date Shot \_\_\_\_\_ From \_\_\_\_\_ To \_\_\_\_\_  
 With \_\_\_\_\_  
 Open Flow \_\_\_\_\_ /10ths Water in \_\_\_\_\_ Inch  
 \_\_\_\_\_ /10ths Merc. in \_\_\_\_\_ Inch  
 Volume \_\_\_\_\_ Cu. Ft.  
 Rock Pressure \_\_\_\_\_ lbs. \_\_\_\_\_ hrs.  
 Oil \_\_\_\_\_ bbls., 1st 24 hrs.  
 Fresh water \_\_\_\_\_ feet \_\_\_\_\_ feet  
 Salt water \_\_\_\_\_ feet \_\_\_\_\_ feet

Casing and Tubing	Used in Drilling	Left in Well	Packers
Size			Kind of Packer
16			
13			
10	32'		Size of
<del>8</del> 6"	880'	Part left in	
<del>8</del> 6"	1670	700'	Depth set
<del>5 1/8</del> 5"	1753'	1753	
3			Perf. top
2			Perf. bottom
Liners Used			Perf. top
			Perf. bottom

CASING CEMENTED \_\_\_\_\_ SIZE \_\_\_\_\_ No. Ft. \_\_\_\_\_ Date \_\_\_\_\_  
 COAL WAS ENCOUNTERED AT \_\_\_\_\_ FEET \_\_\_\_\_ INCHES  
 \_\_\_\_\_ FEET \_\_\_\_\_ INCHES FEET \_\_\_\_\_ INCHES  
 \_\_\_\_\_ FEET \_\_\_\_\_ INCHES FEET \_\_\_\_\_ INCHES

Formation	Color	Hard or Soft	Top	Bottom	Oil, Gas or Water	Depth Found	Remarks
Shall try to pull the 5" casing							
6-5/8" casing has the salt sand cased off, shall not try to pull as it broke off when they tried to when well was completed.							
Gas sand			1463				
Salt sand			1593	1670	Oil		
Bottom salt sand				1733			
Break			1733	1735			
Lime			1735				
Injun			1824		Gas	1834	
					Oil	1844-1904	