


MM

P

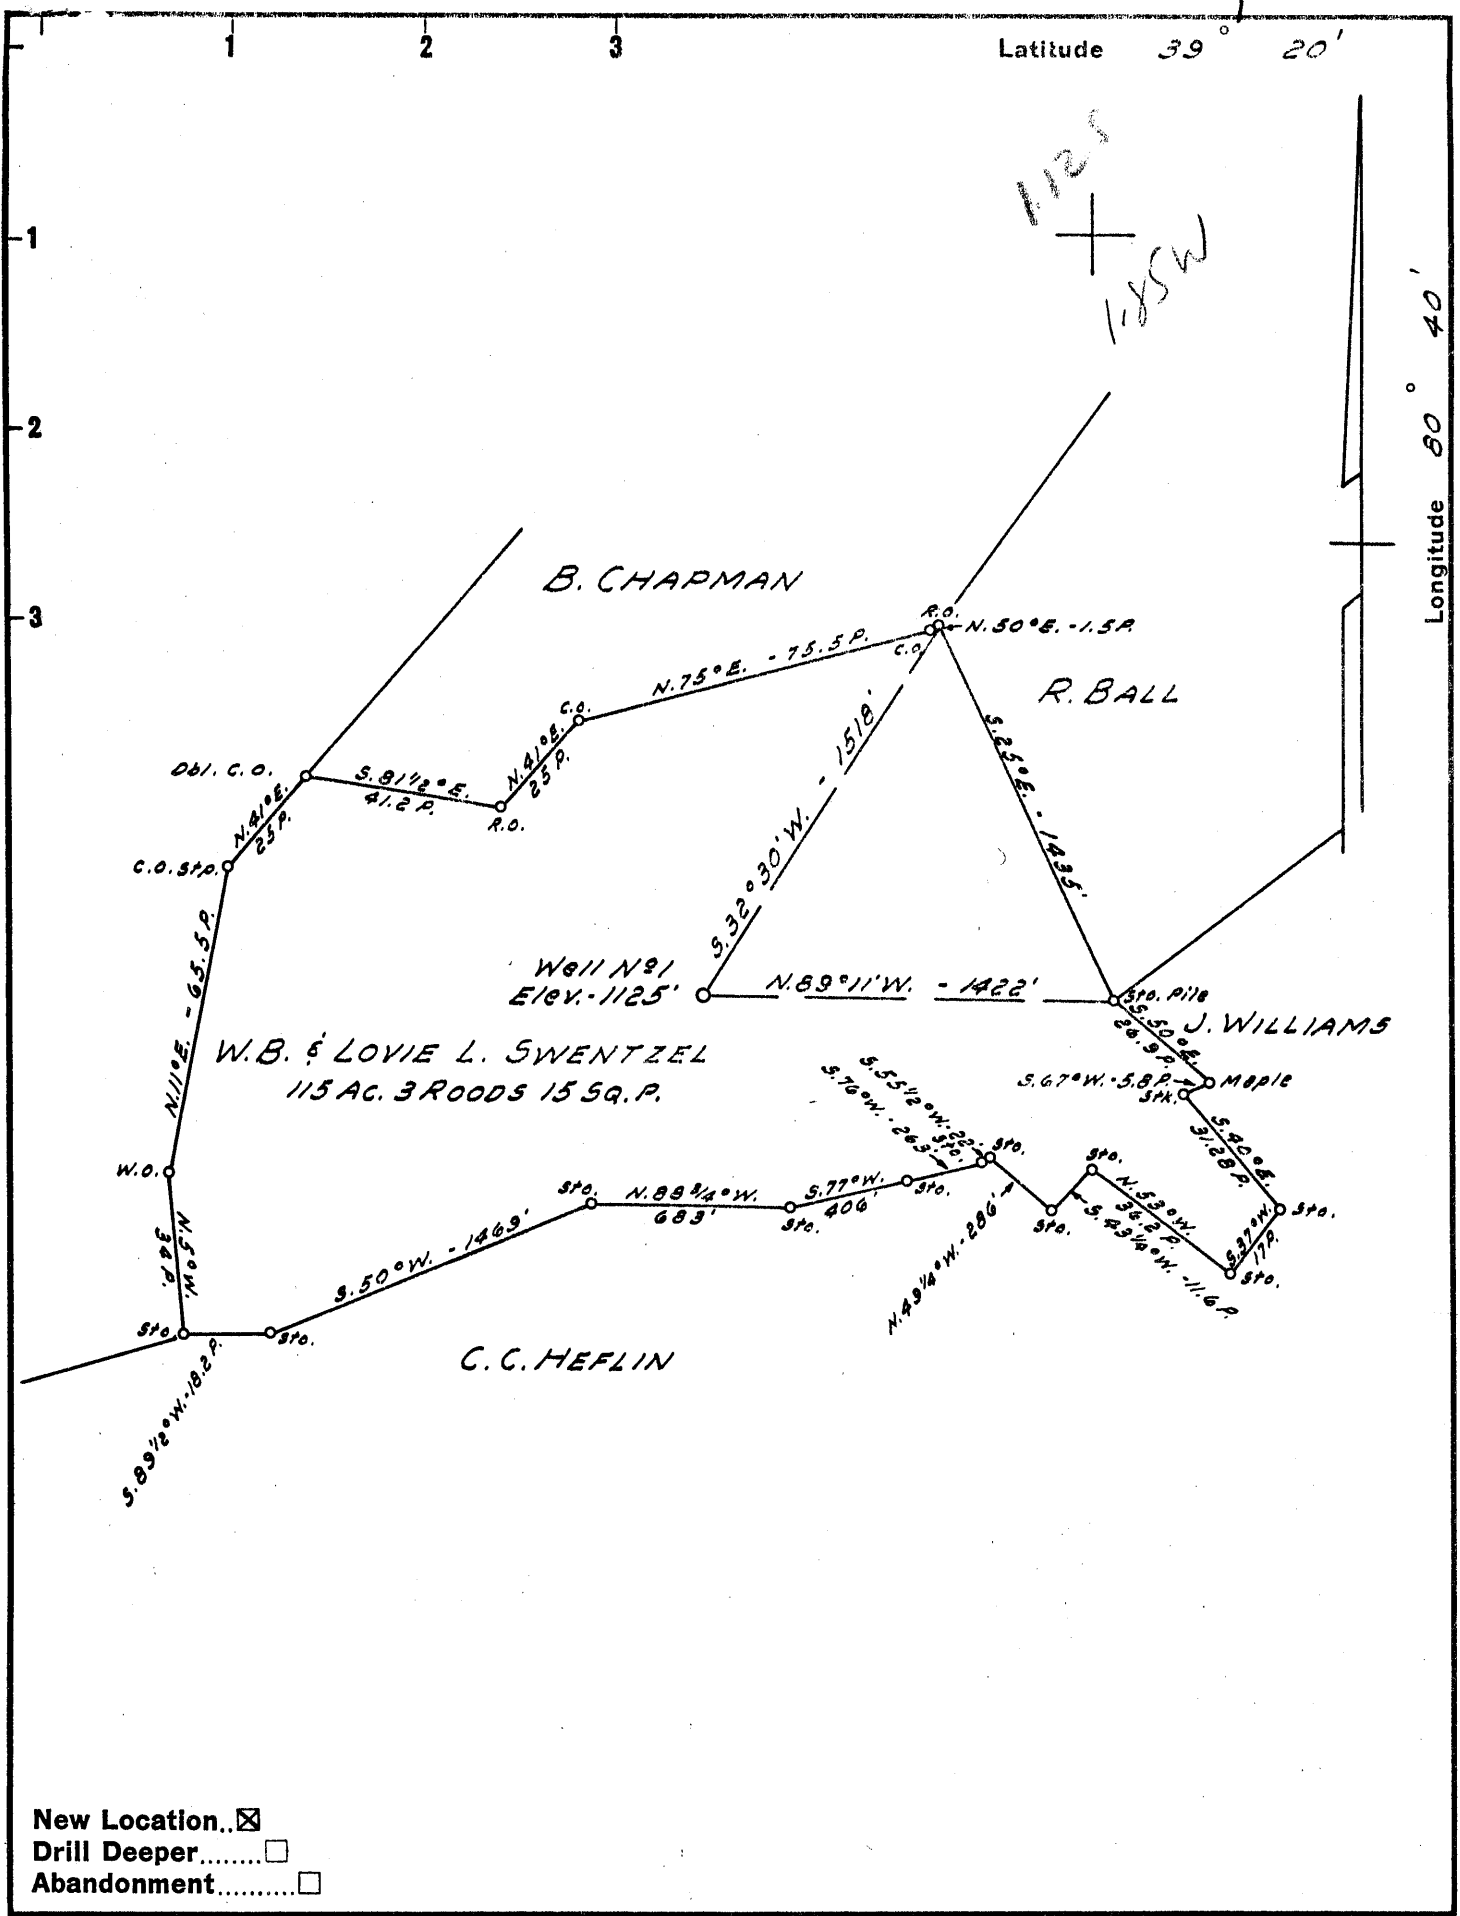

New Location..
 Drill Deeper.....
 Abandonment.....

Company CLARENCE ROGERS
 Address LOWMEDES BUILDING
CLARKSBURG W. VA.
 Farm W.B. & LOVIE L. SWENTZEL
 Tract _____ Acres ^{AS} SHOWN Lease No. _____
 Well (Farm) No. 1 Serial No. _____
 Elevation (Spirit Level) 1125'
 Quadrangle CENTERPOINT - SW
 County DODDRIDGE District GRANT
 Engineer JOHN W. HAMILTON
 Engineer's Registration No. 2274
 File No. _____ Drawing No. _____
 Date SEPT. 5, 1957 Scale 1" = 40 POLES

STATE OF WEST VIRGINIA
 DEPARTMENT OF MINES
 OIL AND GAS DIVISION
 CHARLESTON

WELL LOCATION MAP
 FILE NO. DOD-232

+ Denotes location of well on United States Topographic Maps, scale 1 to 62,500, latitude and longitude lines being represented by border lines as shown.

- Denotes one inch spaces on border line of original tracing.

5-0 17 V



STATE OF WEST VIRGINIA
DEPARTMENT OF MINES
OIL AND GAS DIVISION

Centerpoint

WELL RECORD

Permit No. Dod-232

Oil or Gas Well Dry


(KIND)

Company Clarence M. Rogers
Address Lowndes Bldg., Clarksburg, W. Va.
Farm Swentzel Acres 120
Location (waters) Wolf Penn Run
Well No. 1 Elev. 1125
District Grant County Doddridge
The surface of tract is owned in fee by Walter B. Swentzel, et ux Address Morgansville, W. Va.
Mineral rights are owned by Walter B. Swentzel, et ux. Address Morgansville,
Drilling commenced October 4, 1957
Drilling completed November 13, 1957
Date Shot From To
With _____
Open Flow /10ths Water in Inch
/10ths Merc. in Inch
Volume _____ Cu. Ft.
Rock Pressure _____ lbs. _____ hrs.
Oil _____ bbls., 1st 24 hrs.
Fresh water 50 feet 100 feet
Salt water 1040 feet 1460 feet

Casing and Tubing	Used in Drilling	Left in Well	Packers
Size			
16			Kind of Packer
18			
10	<u>240'</u>	<u>240'</u>	Size of
8 1/4	<u>1182'</u>	<u>1182'</u>	Depth set
6 3/8			
5 3/16			
3			Perf. top
2			Perf. bottom
Liners Used			Perf. top
			Perf. bottom

CASING CEMENTED _____ SIZE _____ No. Ft. _____ Date _____
COAL WAS ENCOUNTERED AT _____ FEET _____ INCHES
_____ FEET _____ INCHES FEET _____ INCHES
_____ FEET _____ INCHES FEET _____ INCHES

Formation	Color	Hard or Soft	Top	Bottom	Oil, Gas or Water	Depth Found	Remarks
Top Soil			0	10			
Sand			10	30			
Red Rock			30	40			
Sand			40	60			
Slate			60	65			
Red Rock			65	85			
Slate			85	100			
Red Rock			100	150			
Slate			150	165			
Slate & Shells			165	200			
Sand			200	235			
Slate			235	245			
Coal			245	246			
Slate & Shells			246	260			
Lime Hard			260	305			
Gritty Lime			305	330			
Red Rock & Shells			330	335			
Red Lime Hard			335	360			
Red Rock & Shells			360	370			
Slate & Shells			370	380			
Sand			380	410			
Broken Lime			410	500			
Lime Hard			500	550			
Lime Broken			550	600			
Lime Hard			600	615			
Red Rock			615	630			
Hard Lime			630	645			
Red Rock & Shells			645	655			
Lime			655	660			
Slate			660	690			
Red Rock			690	700			
Lime Hard			700	745			
Red Rock			745	780			
Slate & Shells			780	855			
Sand			855	870			
Red Rock			870	885			
Slate & Shells			885	900			

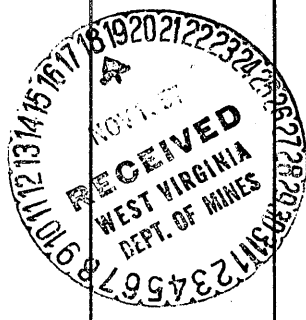

Formation	Color	Hard or Soft	Top /	Bottom	Oil, Gas or Water	Depth Found	Remarks
Red Rock & Shells			900	930			
Lime			930	985			
Black Lime	Hard		985	1020			
Sand			1020	1060			
Hard Sand			1060	1105			
Lime			1105	1157			
Coal			1157	1160			
Slate			1160	1170			
Lime			1170	1185			
Sand			1185	1205			
Slate & Shells			1205	1230			
Sand			1230	1265			
Black Slate			1265	1270			
(Salt) Hard Sand			1270	1485			
Lime Gritty			1485	1530			
Slate			1530	1550			
Sand			1550	1634			
Broken Lime			1634	1660			
Slate & Shells			1660	1714			
Sand			1714	1746			
Black Slate & Shells			1746	1790			
Sand (Maxon)			1790	1816			
Slate			1816	1820			
Hard Lime			1820	1830			
Sand (Maxon)			1830	1875			
Lime			1875	1935			
Sand (Blue Monday)			1935	1955			
Big Lime			1955	1991			
Slate			1991	2023			
Big Injun			2023	2045			
Slate			2045	2157			
					Show of oil & gas		1714-1724

Date Nov. 15, 1957
APPROVED Carroll M. Rogers, Owner
By _____
(Title)