


Latitude 39° 20'

Longitude 80° 45'

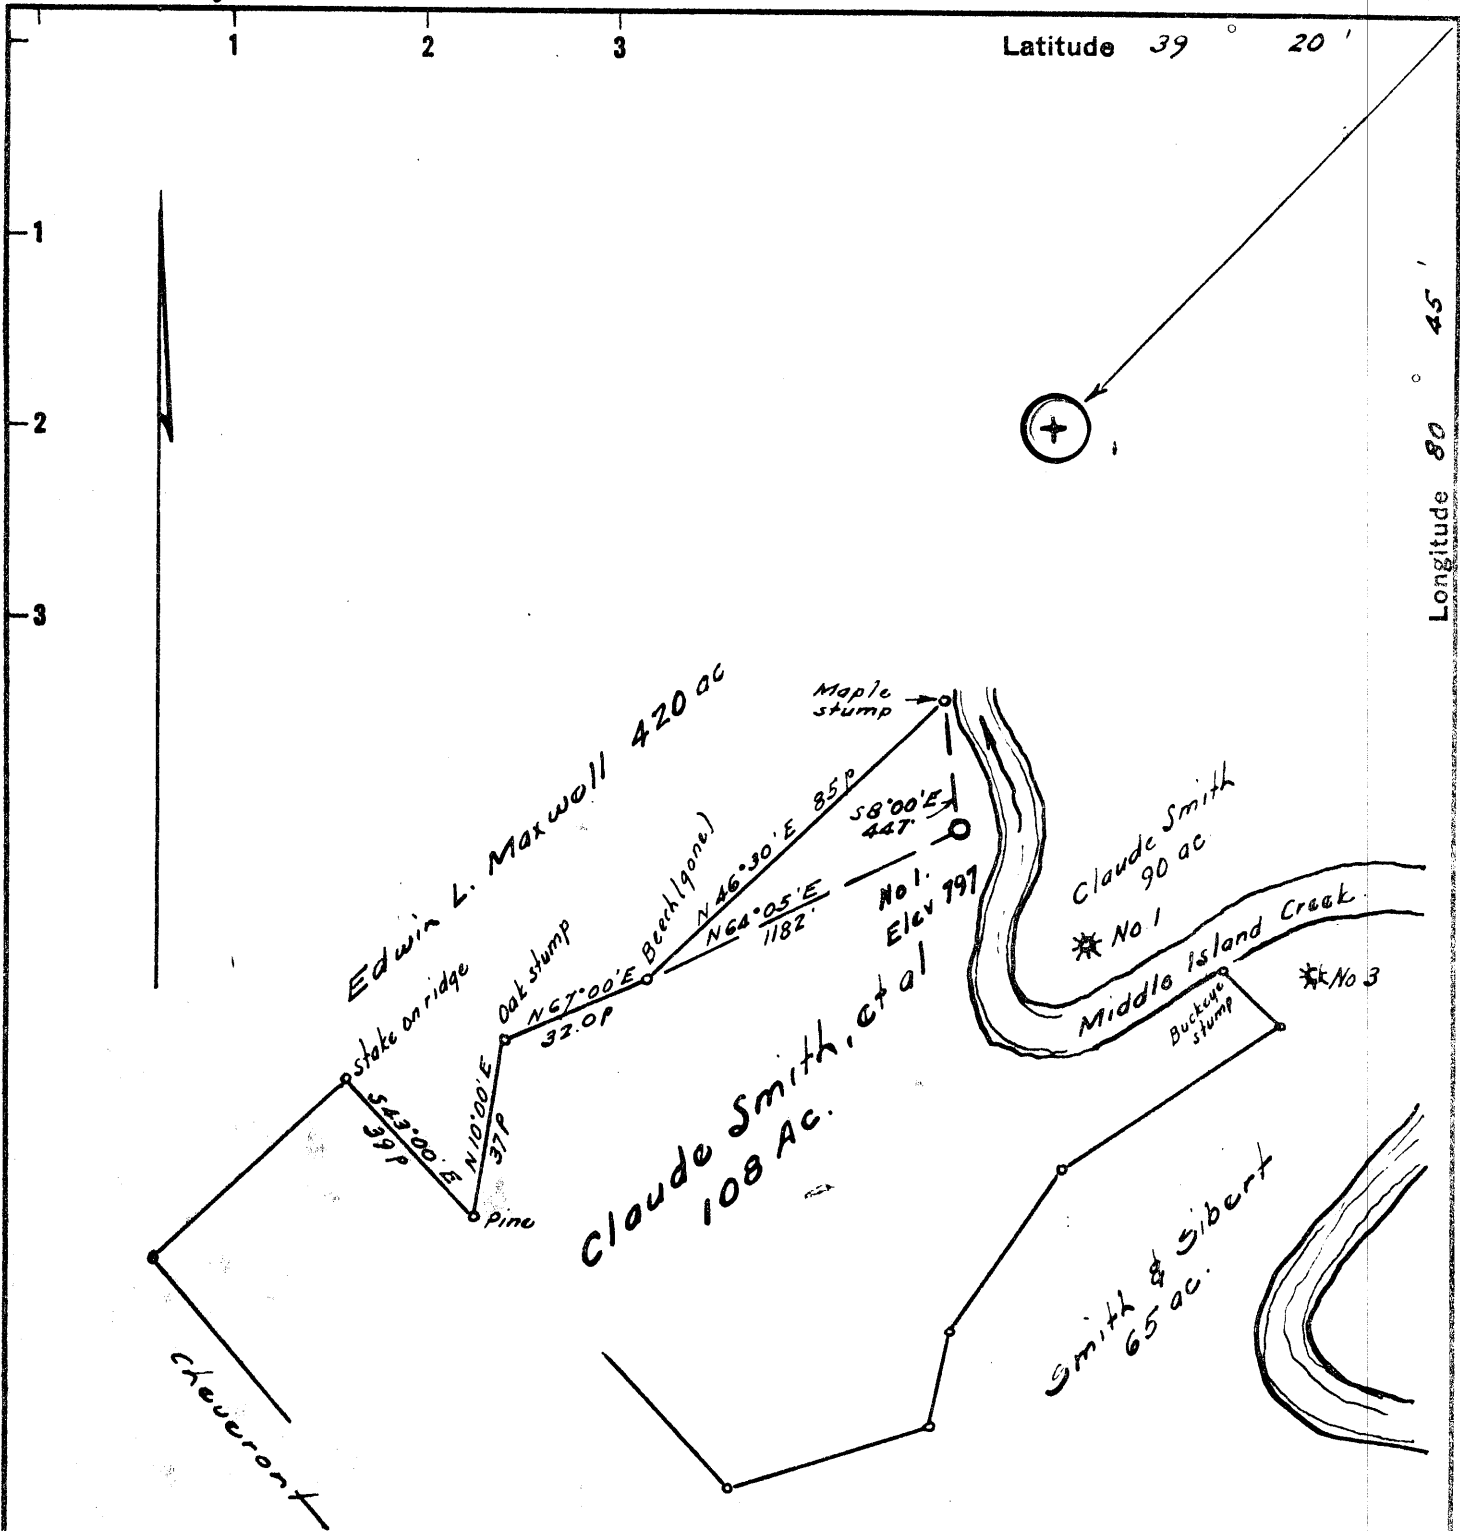

Now Location

Drill Deeper

Abandonment 4-8-74

No coal
Surface is owned by Floyd Sibert,
Box 205, West Union, W. Va.

Company	STONESTREET LANDS COMPANY SMITH & SIBERT
Address	BOX 205, WEST UNION, WEST VA.
Farm	Claude Smith, et al Floyd W Siebert
Tract	Acres 108 Lease No. _____
Well (Farm) No.	One Serial No. _____
Elevation (Spirit Level)	797
Quadrangle	West Union SE
County	Doddridge District West Union
Engineer	<i>W. H. Hall</i>
Engineer's Registration No.	1227
File No.	Drawing No. _____
Date	April, 1960 Scale 1" = 400' = 660'


STATE OF WEST VIRGINIA
DEPARTMENT OF MINES
OIL AND GAS DIVISION
CHARLESTON

WELL LOCATION MAP
FILE NO. DOD-356-P
Plugging Canceled

+ Denotes location of well on United States Topographic Maps, scale 1 to 62,500, latitude and longitude lines being represented by border lines as shown.

NOV 7 1977

- Denotes one inch spaces on border line of original tracing.

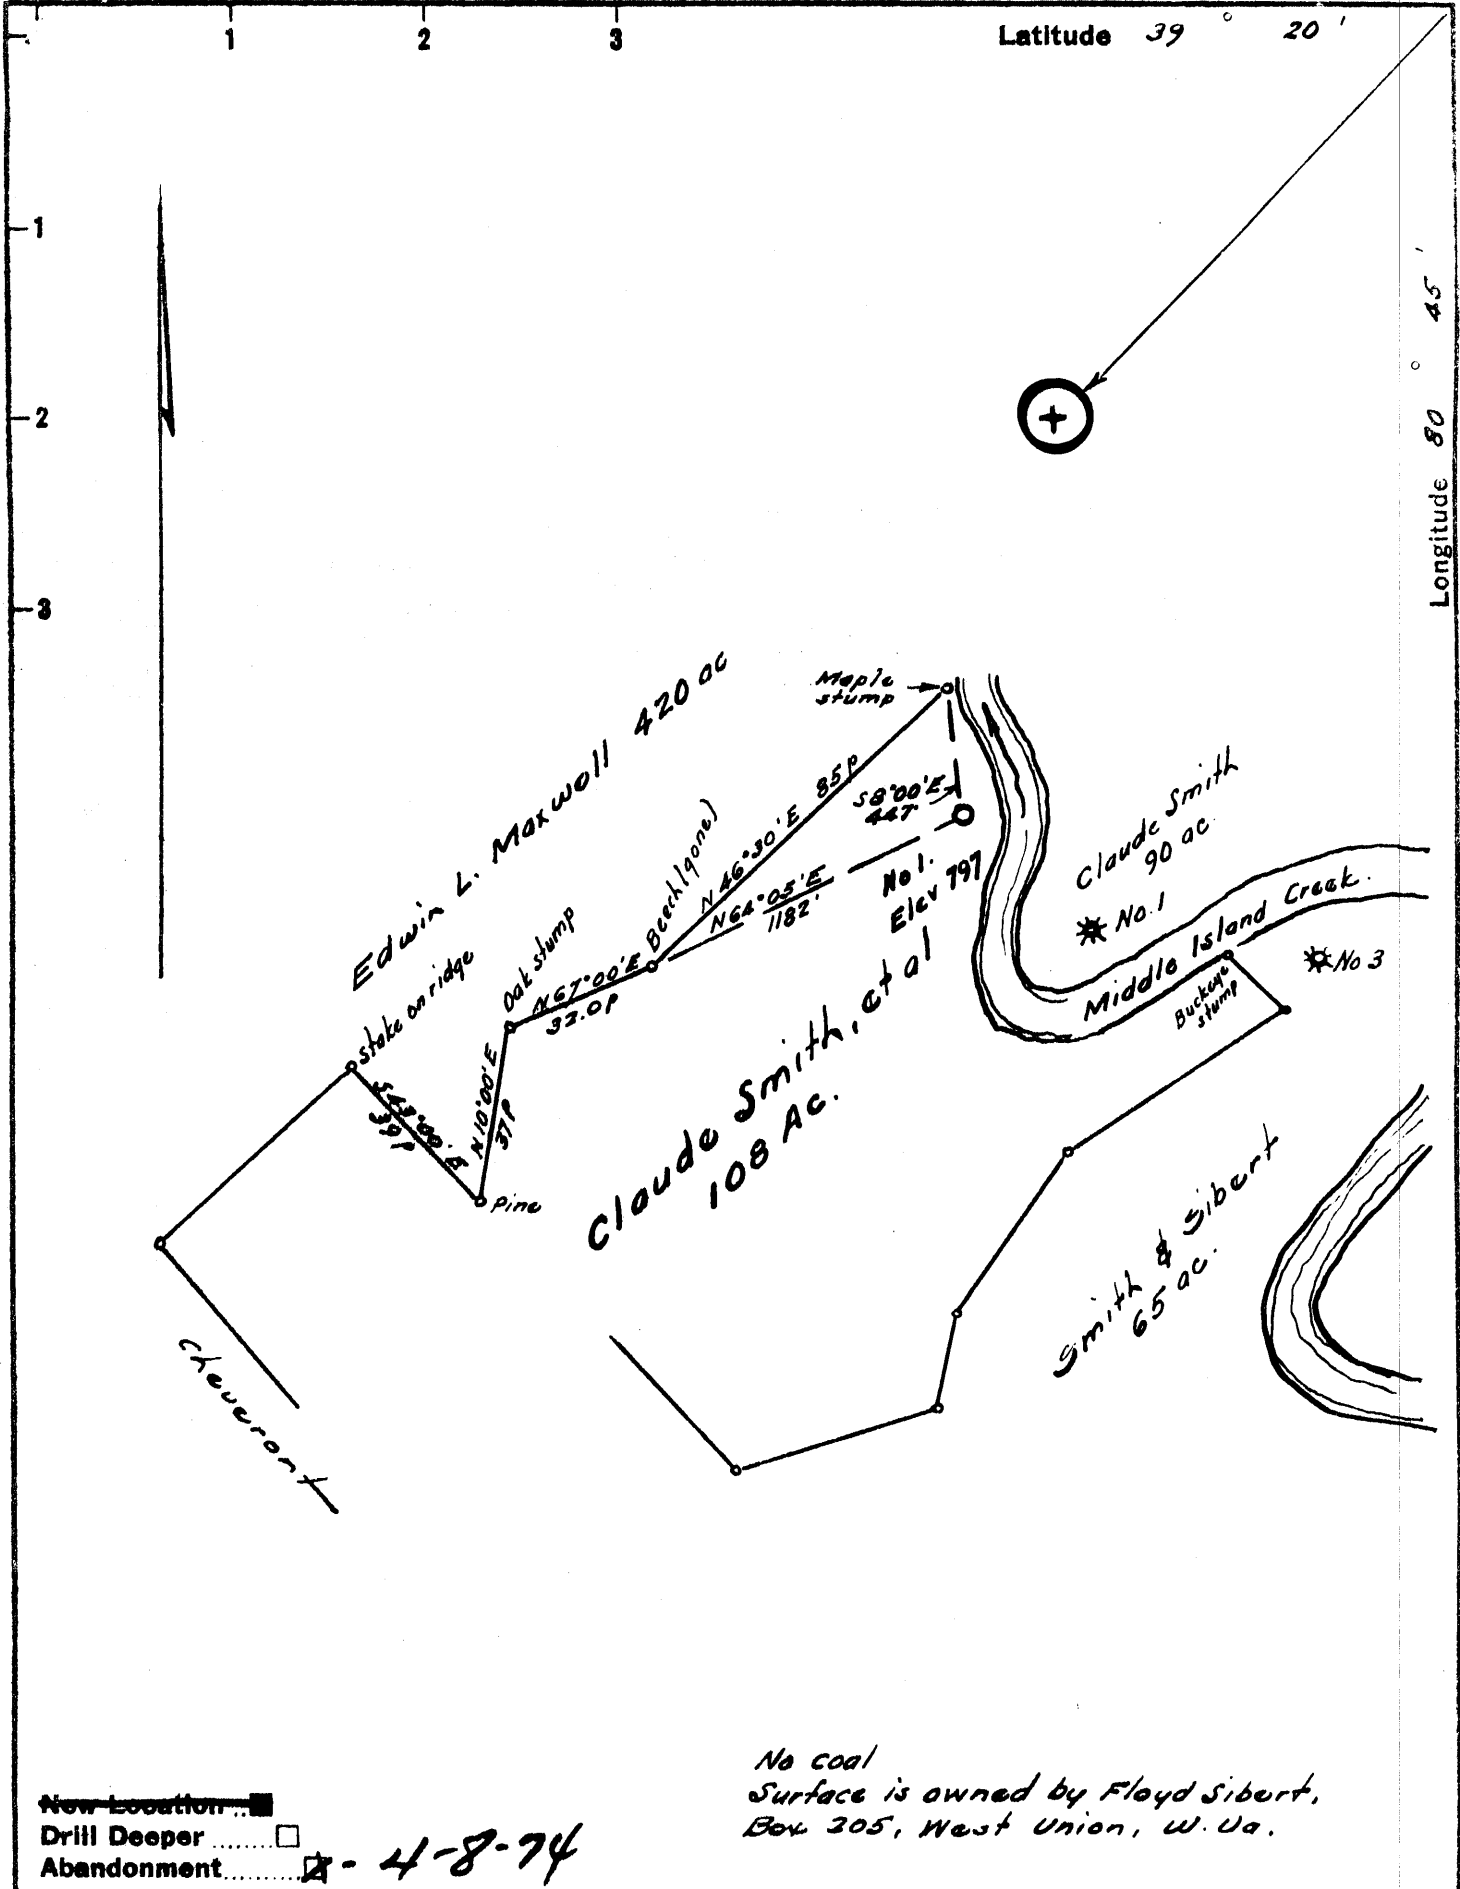

New Location
 Drill Deeper
 Abandonment 4-8-74

No coal
 Surface is owned by Floyd Sibert,
 Box 305, West Union, W. Va.


STONESTREET LANDS COMPANY
 Company ~~SMITH & SIBERT~~
 Address ~~Box 350, Spencer, W. Va.~~
 Farm Claude Smith, et al Floyd W Siebert
 Tract _____ Acres 108 Lease No. _____
 Well (Farm) No. One Serial No. _____
 Elevation (Spirit Level) 797
 Quadrangle West Union SE
 County Doddridge District West Union
 Engineer [Signature]
 Engineer's Registration No. 1227
 File No. _____ Drawing No. _____
 Date April, 1960 Scale 1" = 400' = 660'

STATE OF WEST VIRGINIA
 DEPARTMENT OF MINES
 OIL AND GAS DIVISION
 CHARLESTON

WELL LOCATION MAP
 FILE NO. DDO-356-P

+ Denotes location of well on United States Topographic Maps, scale 1 to 62,500, latitude and longitude lines being represented by border lines as shown.

- Denotes one inch spaces on border line of original tracing.

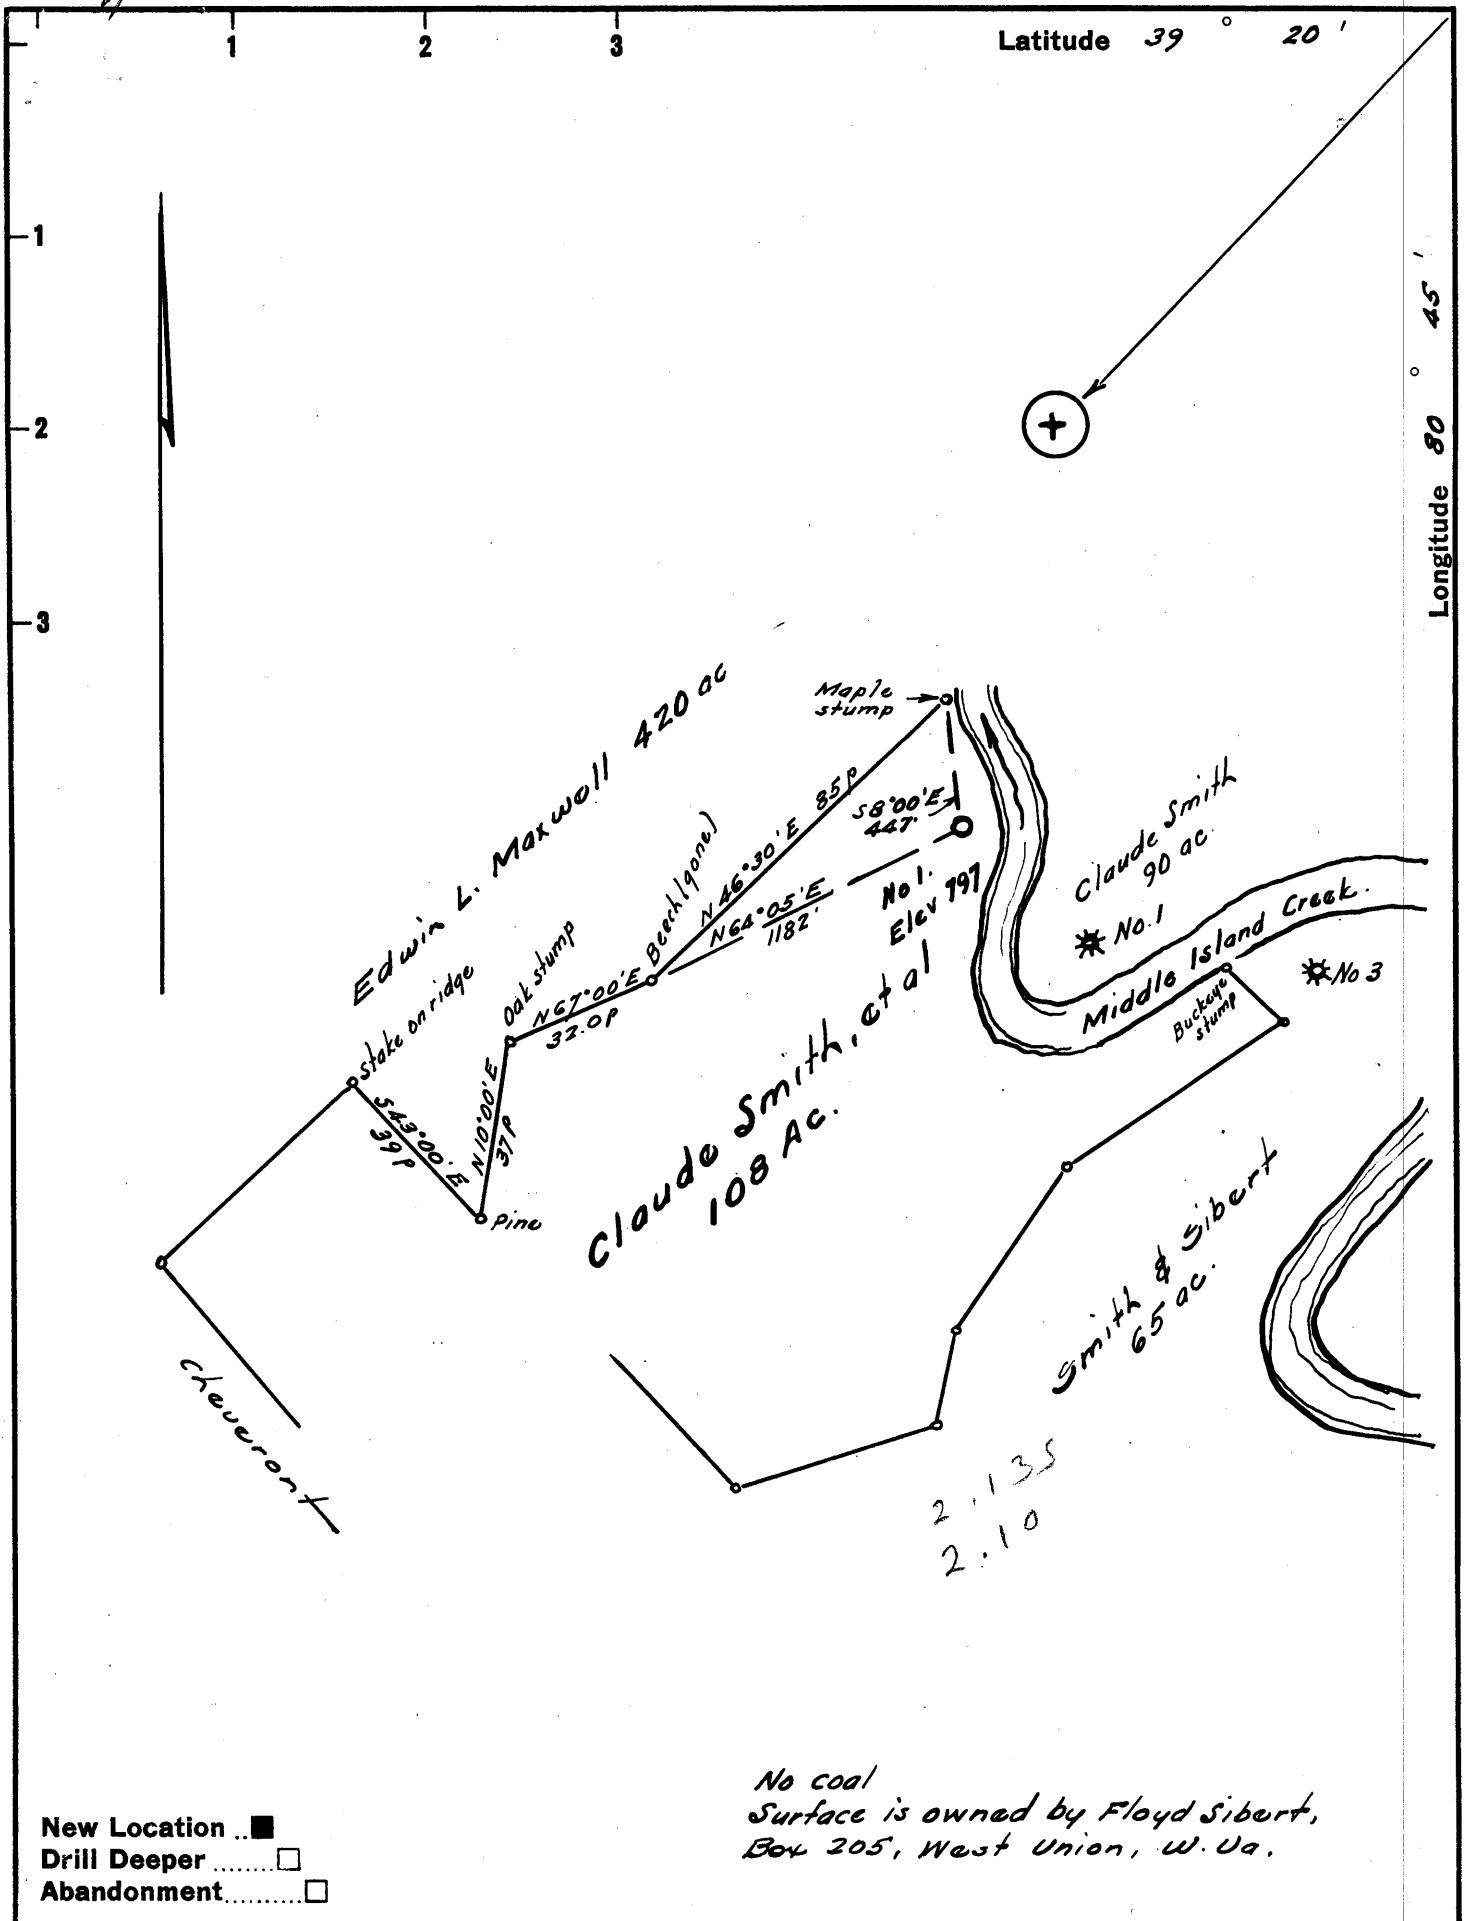

New Location ..
 Drill Deeper
 Abandonment.....

No coal
 Surface is owned by Floyd Sibert,
 Box 205, West Union, W. Va.

Company SMITH & SIBERT
 Address Box 205, West Union, West Va.
 Farm Claude Smith, et al
 Tract _____ Acres 108 Lease No. _____
 Well (Farm) No. One Serial No. _____
 Elevation (Spirit Level) 797
 Quadrangle West Union SE
 County Doddridge District West Union
 Engineer Nussbaumer
 Engineer's Registration No. 1227
 File No. _____ Drawing No. _____
 Date April, 1960 Scale 1" = 40p = 660'

STATE OF WEST VIRGINIA
 DEPARTMENT OF MINES
 OIL AND GAS DIVISION
 CHARLESTON

WELL LOCATION MAP
 FILE NO. DOD-356

+ Denotes location of well on United States Topographic Maps, scale 1 to 62,500, latitude and longitude lines being represented by border lines as shown.
 - Denotes one inch spaces on border line of original tracing.

79



STATE OF WEST VIRGINIA
DEPARTMENT OF MINES
OIL AND GAS DIVISION 9

Quadrangle West Union

WELL RECORD

Permit No. DOD-356

Oil or Gas Well Gas
(KIND)

Company Sibert & Smith
Address c/o J.M.L. Smith Box 205 West Union, W. Va.
Farm Floyd W. Sibert Acres 108
Location (waters) Middle Island Creek
Well No. #1 Elev. 797
District West Union County Doddridge
The surface of tract is owned in fee by Floyd W. Sibert
Address _____
Mineral rights are owned by Cloud F. Smith Et al
West Union Address _____

Casing and Tubing	Used in Drilling	Left in Well	Packers
Size			Kind of Packer
16			
13			
10	2I	2I	Size of
8 1/4	324		
6 5/8	959	959	Depth set
5 3/16	1744	1744	
3			Perf. top
2			Perf. bottom
Liners Used			Perf. top
			Perf. bottom

Drilling commenced April 13-1960
Drilling completed May 23-1960
Date Shot _____ From _____ To _____
With _____
Open Flow 30/10ths Water in one inch Inch
_____ /10ths Merc. in _____ Inch
Volume 65 thousand Cu. Ft.
Rock Pressure 660 lbs. 12 hrs.
Oil _____ bbls., 1st 24 hrs.
WELL ACIDIZED _____

CASING CEMENTED 5 3/16 SIZE _____ No. Ft. _____ Date _____
15 lbs cement - 400# aquapac
COAL WAS ENCOUNTERED AT _____ FEET _____ INCHES
_____ FEET _____ INCHES FEET _____ INCHES
_____ FEET _____ INCHES FEET _____ INCHES


WELL FRACTURED With no success

RESULT AFTER TREATMENT _____

ROCK PRESSURE AFTER TREATMENT _____

Fresh Water 68 Feet 13 gals per hour Salt Water no Feet _____

Formation	Color	Hard or Soft	Top	Bottom	Oil, Gas or Water	Depth	Remarks
Red			0	22			
Lime			22	35			
Red Rock			35	45			
Lime			45	80			
Red rock			80	135			
Slate			135	145			
Black slate			145	155			
White slate			155	175			
Sand			175	198			
Slate & shells			198	210			
Sand			210	227			
Red rock			227	275			
Slate & shells			275	290			
Sand			290	324			
Slate			324	352			
Red rock			352	375			
Slate & shells			375	420			
Lime shell			420	450			
Slate & Shells			450	480			
Red rock			480	575			
Slate & shells			575	600			
Lime			600	660			
Slate & shells			660	675			
Sand			675	700			
Slate & shells			700	735			
Red rock			735	760			
Lime shells			760	780			
Red rock			780	795			
Sand			795	819			

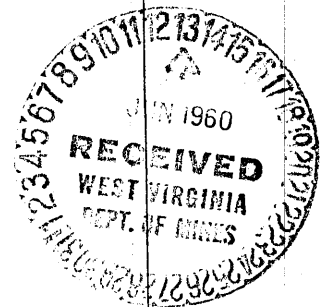

Formation	Color	Hard or Soft	Top 9	Bottom	Oil, Gas or Water	Depth Found	Remarks
Red rock			819	890			
Slate shells			890	1002			
Sand			1002	1135			
Lime shells			1135	1170			
Slate			1170	1215			
Sand			1215	1290			
Slate			1290	1305			
Sand			1305	1350			
Slate & shells			1350	1420			
Sand			1420	1530	Gas I480 to I485		
Grey slate & shells			1530	1547			
Sand			1547	1577			
Slate & shells			1575	1590			
Lime pink			1590	1600			
Gritty lime			1600	1628			
Pink lime			1628	1650			
Slate			1650	1660			
Lime			1660	1683			
Sand			1683	1693			
Slate			1693	1698			
Big lime			1698	1790			
Sand			1790	1805			
Lime			1805	1818			
Slate & shells Sand			1818	1870			
Slate & shells			1870	2007			
Sand			2007	2107			
Slate & shells			2107	2420			
Sand			2420	2430	44?		
Slate			2430	2450	Oil		
Sand			2450	2456			
Slate			2456	2477			
Total depth 2477							
Gas 1858 to 1865 3 1/2 W. 1"							

Date Mar 31, 1960

APPROVED Robert R. Smith, Owner

By W. Smith
(Title)