

4701700478P

WW-7
8-30-06



West Virginia Department of Environmental Protection
Office of Oil and Gas

WELL LOCATION FORM: GPS

API: 47-017-00478 WELL NO.: 1

FARM NAME: Robinson, H.G.

RESPONSIBLE PARTY NAME: Diversified Production LLC

COUNTY: Doddridge DISTRICT: New Milton

QUADRANGLE: New Milton

SURFACE OWNER: Bryan R. Robinson

ROYALTY OWNER: Diversified Production LLC

UTM GPS NORTHING: 4,338,189.1

UTM GPS EASTING: 524,183.8 GPS ELEVATION: 876'

The Responsible Party named above has chosen to submit GPS coordinates in lieu of preparing a new well location plat for a plugging permit or assigned API number on the above well. The Office of Oil and Gas will not accept GPS coordinates that do not meet the following requirements:

1. Datum: NAD 1983, Zone: 17 North, Coordinate Units: meters, Altitude: height above mean sea level (MSL) – meters.
2. Accuracy to Datum – 3.05 meters
3. Data Collection Method:

Survey grade GPS _____: Post Processed Differential _____
Real-Time Differential _____

Mapping Grade GPS X: Post Processed Differential X
Real-Time Differential _____

4. Letter size copy of the topography map showing the well location.

I the undersigned, hereby certify this data is correct to the best of my knowledge and belief and shows all the information required by law and the regulations issued and prescribed by the Office of Oil and Gas.

[Signature]
Signature

Director Production
Title

08/12/2021
Date

RECEIVED
Office of Oil and Gas
AUG 24 2021
WW Department of
Environmental Protection





Diversified Gas & Oil Corporation
100 Diversified Way
Pikeville KY, 41051

47-017-00478


Plugging Map

Legend

- Well
- Access Road
- Pits
- Pad
- Public Roads

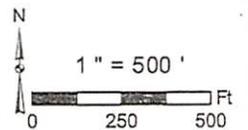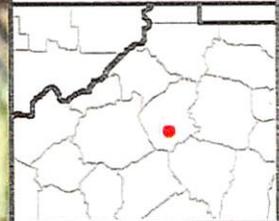

Copyright:© 2013 National Geographic Society, i-cubed

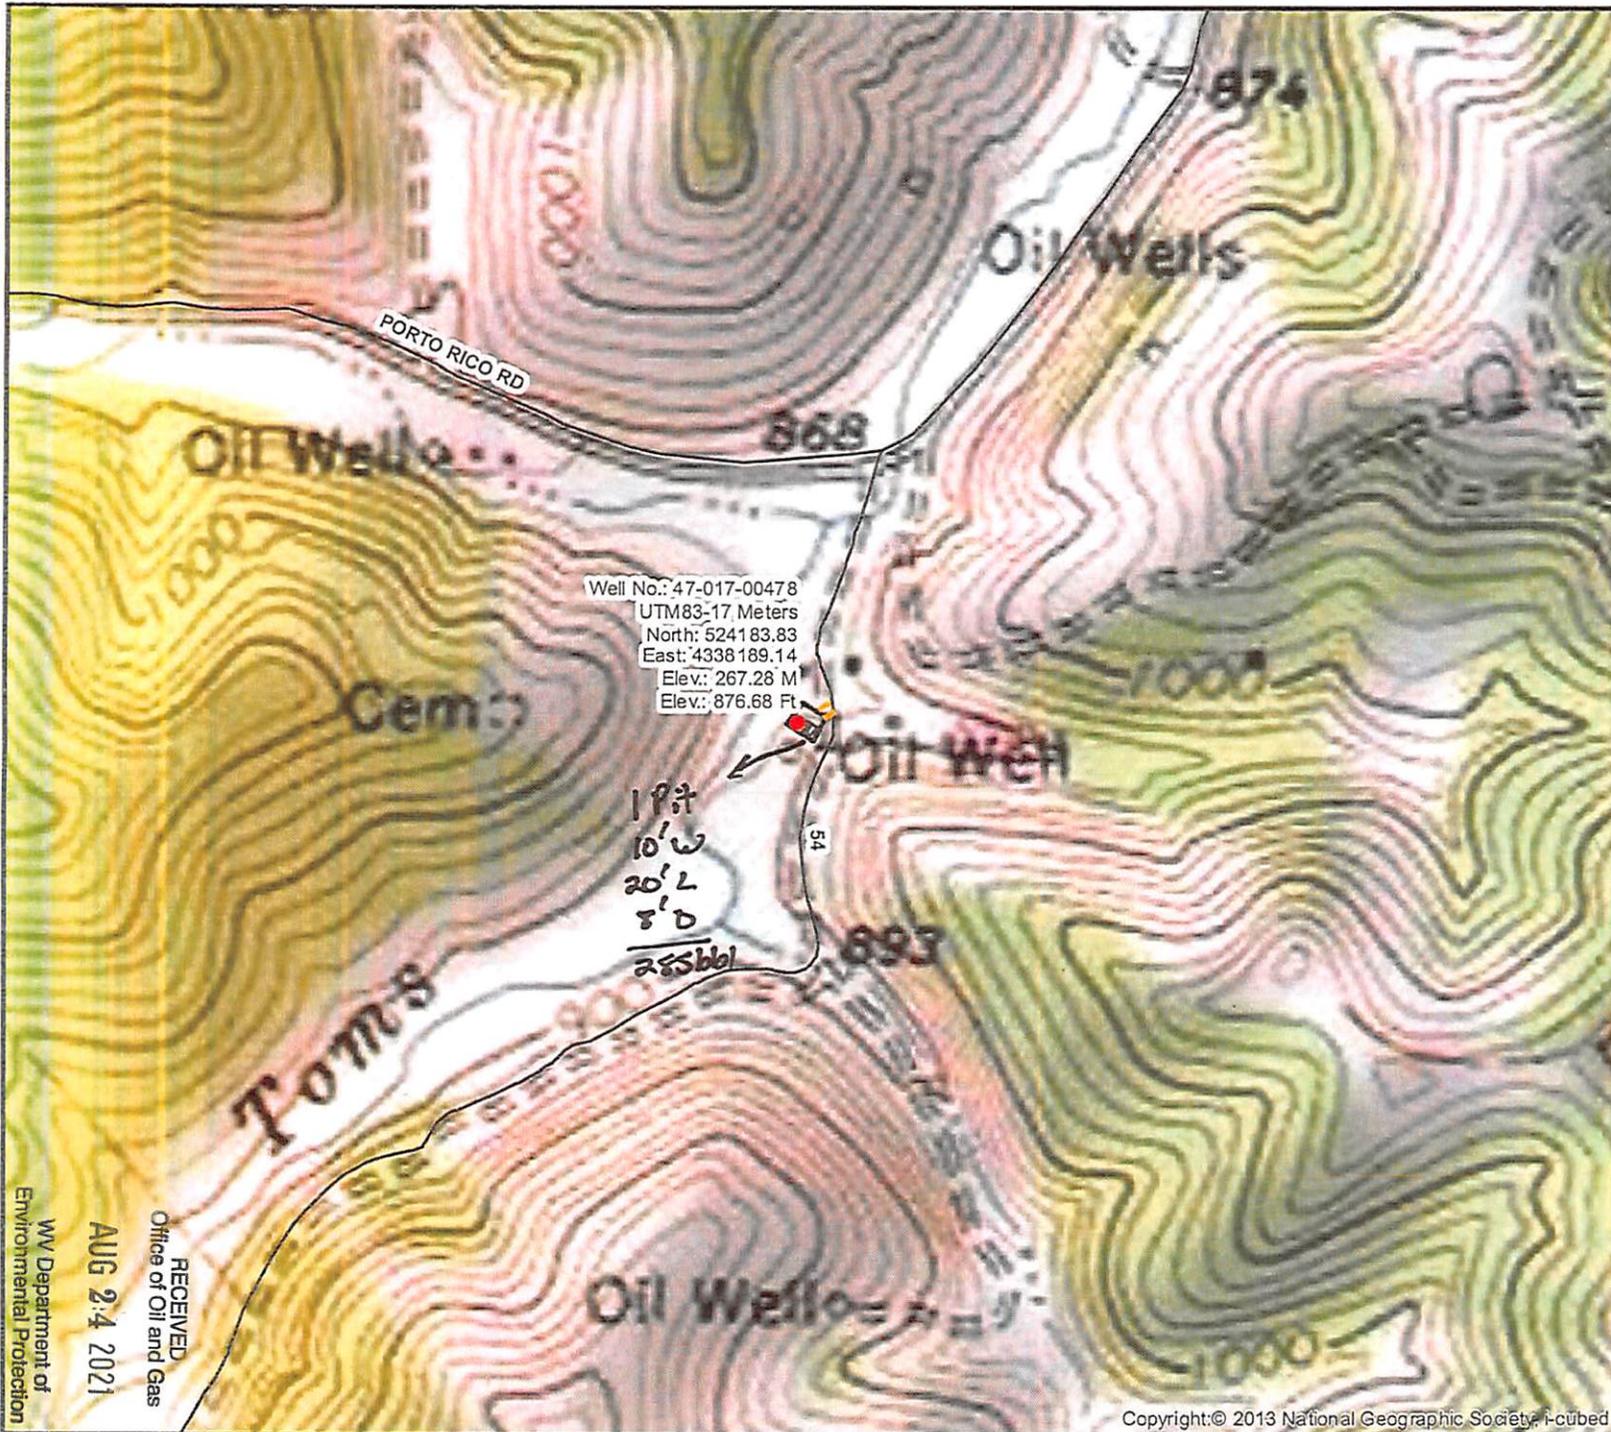

Well No.: 47-017-00478
UTM83-17 Meters
North: 5241 83.83
East: 4338 189.14
Elev.: 267.28 M
Elev.: 876.68 Ft

1 ft
10' W
20' L
8' D
255bb1

RECEIVED
Office of Oil and Gas
AUG 24 2021
WV Department of
Environmental Protection

4701700478 P