


m 15-9-65

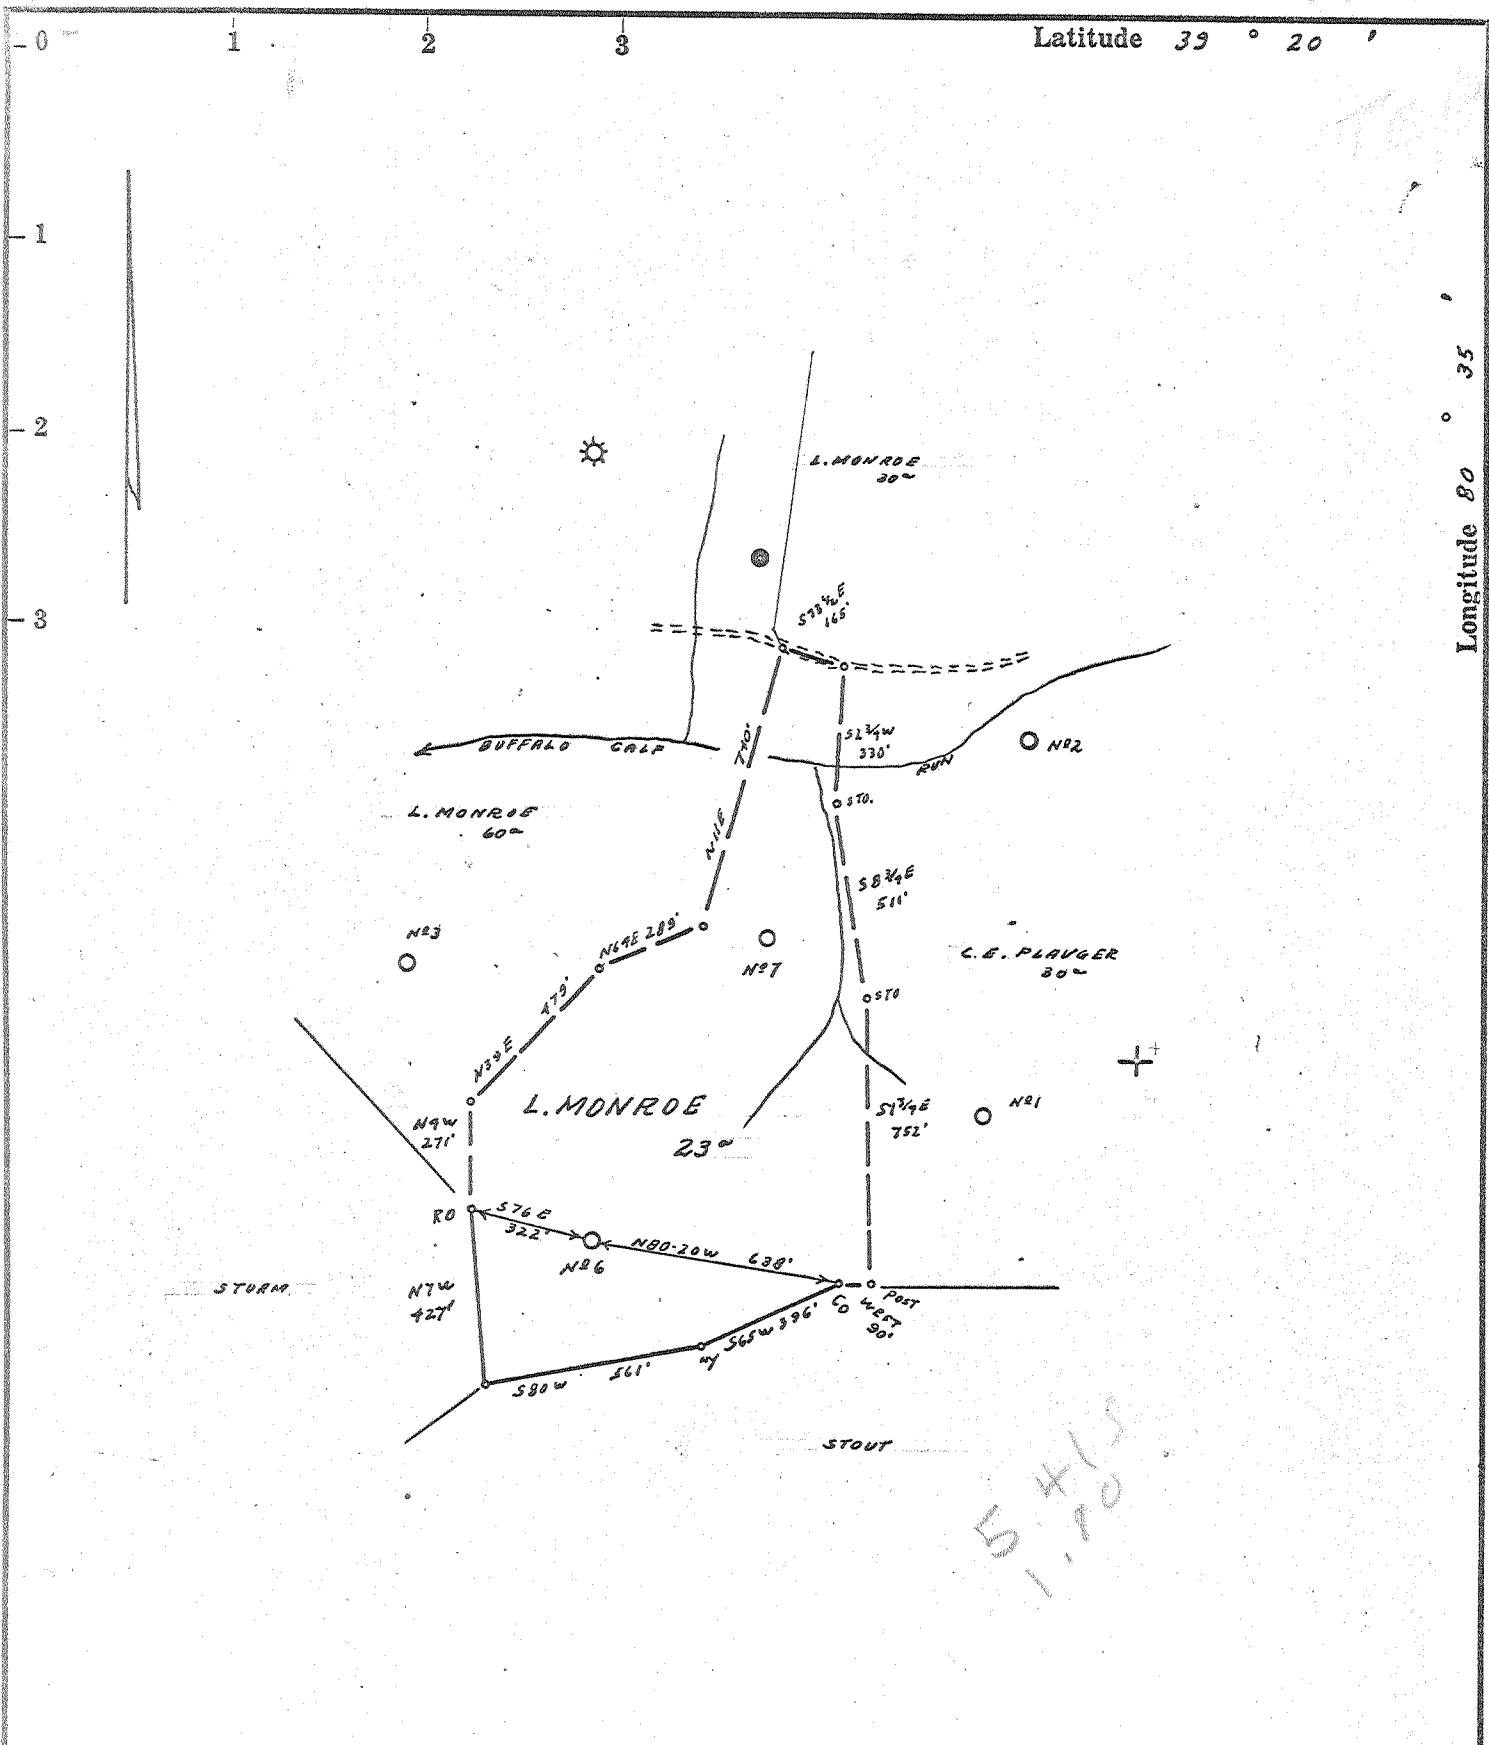

- Fracture.....
- Redrill.....
- New Location.
- Drill Deeper.....
- Abandonment.....

Source of Elevation ROAD FORK NORTH OF LOC. ELEV. 918'

I, the undersigned, hereby certify that this map is correct to the best of my knowledge and belief and shows all the information required by paragraph 6 of the rules and regulations of the oil and gas section of the mining laws of West Virginia.

Minimum accuracy, one part in 200

Company J. E. WEBBER
 Address MORGANSVILLE, W.V.A.
 Farm LAWRENCE MONROE
 Tract _____ Acres 23 Lease No. _____
 Well (Farm) No. 6 Serial No. 0
 Elevation (Spirit Level) 1141'
 Quadrangle CENTERPOINT SE 32
 County DODD BRIDGE District GREENBRIER
 Engineer James J. Jeffers
 Engineer's Registration No. 1084
 File No. 202/1116 Drawing No. _____
 Date 6-12-65 Scale 1" = 500'

STATE OF WEST VIRGINIA
 DEPARTMENT OF MINES
 OIL AND GAS DIVISION
 CHARLESTON

WELL LOCATION MAP

FILE NO. Dod 1310

+ Denotes location of well on United States Topographic Maps, scale 1 to 62,500, latitude and longitude lines being represented by border lines as shown.

— Denotes one inch spaces on border line of original tracing.

6-6-102



STATE OF WEST VIRGINIA
DEPARTMENT OF MINES
OIL AND GAS DIVISION 3

- Rotary
- Spudder
- Cable Tools
- Storage

Quadrangle Centerpoint

Permit No. Dod.- 1310

WELL RECORD

Oil or Gas Well Oil Well
(KIND)

Gas show

Company Webber Associates
 Address Morgansville, W. Va. 26406
 Farm Lawrence Monroe Acres _____
 Location (waters) Buffalo Calf Run
 Well No. 6 Elev. 1141
 District Greenbrier County Doddridge
 The surface of tract is owned in fee by _____
 Address _____
 Mineral rights are owned by _____
 Address _____
 Drilling commenced _____
 Drilling completed December 11, 1965
 Date Shot _____ From _____ To _____
 With _____
 Open Flow _____ /10ths Water in _____ Inch
 _____ /10ths Merc. in _____ Inch
 Volume _____ Cu. Ft.
 Rock Pressure 590 lbs. 24 hrs.
 Oil 10 bbls bbls., 1st 24 hrs.
 WELL ACIDIZED (DETAILS) 12 bbls ACID

Casing and Tubing	Used in Drilling	Left in Well	Packers
Size			Kind of Packer
16			
13			Size of
10			
8 1/4			Depth set
6 3/4			
5 3/16		2180	
4 1/2			Perf. top
3			Perf. bottom
2			Perf. top
Liners Used			Perf. bottom


Attach copy of cementing record.

CASING CEMENTED _____ SIZE _____ No. Ft. _____ Date _____
 Amount of cement used (bags) _____
 Name of Service Co. _____
 COAL WAS ENCOUNTERED AT None FEET _____ INCHES _____
 FEET _____ INCHES FEET _____ INCHES
 FEET _____ INCHES FEET _____ INCHES

WELL FRACTURED (DETAILS) _____

RESULT AFTER TREATMENT (Initial open Flow or bbls.) SAME
 ROCK PRESSURE AFTER TREATMENT _____ HOURS _____
 Fresh Water _____ Feet _____ Salt Water _____ Feet _____
 Producing Sand Big Injun Depth 2287 To 2386

Formation	Color	Hard or Soft	Top	Bottom	Oil, Gas or Water	Depth	Remarks
Soil			0	5			
Red Rock			5	15			
Sand			15	40			
Red Rock			40	60			
White Slate			60	100			
Red Rock			100	175			
Slate & Shell			175	200			
Sand			200	210			
Slate & Shell			210	225			
Red Rock			225	285			
Lime			285	305			
Slate & Shell			305	320			
Red Rock			320	330			
Slate & Shell			330	400			
Red Rock			400	435			
Slate & Shell			435	450			
Lime			450	505			
Sand			505	545			
Red Rock			545	555			
Lime		Gritty	555	575			
Slate & Shell			575	580			
Sand			580	595			
Slate			595	610			
Slate	Black		610	650			
Red Rock			650	660			
Slate & Shells			660	685			
Red Rock			685	695			
Slate & Shells			695	705			
Lime			705	735			

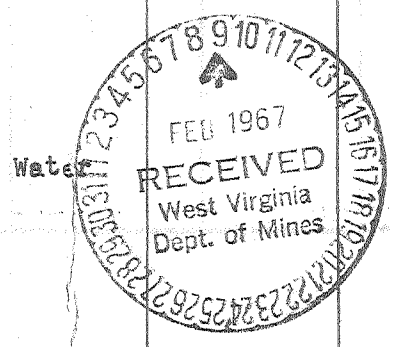

Formation	Color	Hard or Soft	Top 3	Bottom	Oil, Gas or Water	Depth Found	Remarks
Red Rock			735	740			
Lime			740	755			
Sand			755	770			
Slate & Shell			770	890			
Slate	Black		890	910			
Slate & Shells			910	935			
Sand			935	980			
Red Rock			980	1030			
Slate & Shells			1030	1085			
Red Rock			1085	1110			
Slate & Shell			1110	1235			
Red Rock			1235	1270			
Lime			1270	1285			
Red Rock			1285	1295			
Slate & Shells			1295	1375			
Rock	Pink		1375	1400			
Slate & Shells			1400	1440			
Sand			1440	1450			
Lime			1450	1595			
Sand			1595	1630	Show Oil	1610	
Slate & Shells			1630	1675			
Sand			1675	1705	Hole full Water		
Black Slate			1705	1875			
Sand			1875	2055			
Slate			2055	2128			
Rock	Pink		2128	2140			
Slate			2140	2152			
Sand			2152	2162	More Water		
Lime - Broken			2162	2182			
Slate	White		2182	2196			
Little Lime			2196	2230			
Pencil Cave			2230	2238			
Big Lime			2238	2287			
Big Injun			2287	2386	Oil & Gas	2305	
Slate			2386	2402			
Total Depth Drilled				2402			

Date Jan 20, 1967
APPROVED Jack Swelber, Owner
By owner
(Title)