

Minimum Error of Closure 1' IN 200'  
 Source of Elevation U.S.G.S. B.M. ELEVATION 881'

"I, the undersigned, hereby certify that this map is correct to the best of my knowledge and belief and shows all the information required by paragraph 6 of the rules and regulations of the oil and gas section of the mining laws of West Virginia."

New Location.....  
 Drill Deeper.....  
 Abandonment.....

Company DODDRIDGE GAS No 24  
 Address CLARKSBURG, WEST VA.  
 Farm GEO. W. FARR  
 Tract \_\_\_\_\_ Acres 262 Lease No. \_\_\_\_\_  
 Well (Farm) No. \_\_\_\_\_ Serial No. No 1  
 Elevation (Spirit Level) 1058'  
 Quadrangle HOLBROOK N.E.  
 County DODDRIDGE District WEST UNION  
 Engineer Jackson M. Lewis  
 Engineer's Registration No. 2397  
 File No. \_\_\_\_\_ Drawing No. \_\_\_\_\_  
 Date JULY 14, 1969 Scale 1" = 1000'

STATE OF WEST VIRGINIA  
 DEPARTMENT OF MINES  
 OIL AND GAS DIVISION  
 CHARLESTON

WELL LOCATION MAP  
 FILE NO. Dod-1568

+ Denotes location of well on United States Topographic Maps, scale 1 to 62,500, latitude and longitude lines being represented by border lines as shown.


- Denotes one inch spaces on border line of original tracing.

15,500'

LATITUDE 39° 15'

LONGITUDE 80° 45'

4,000'

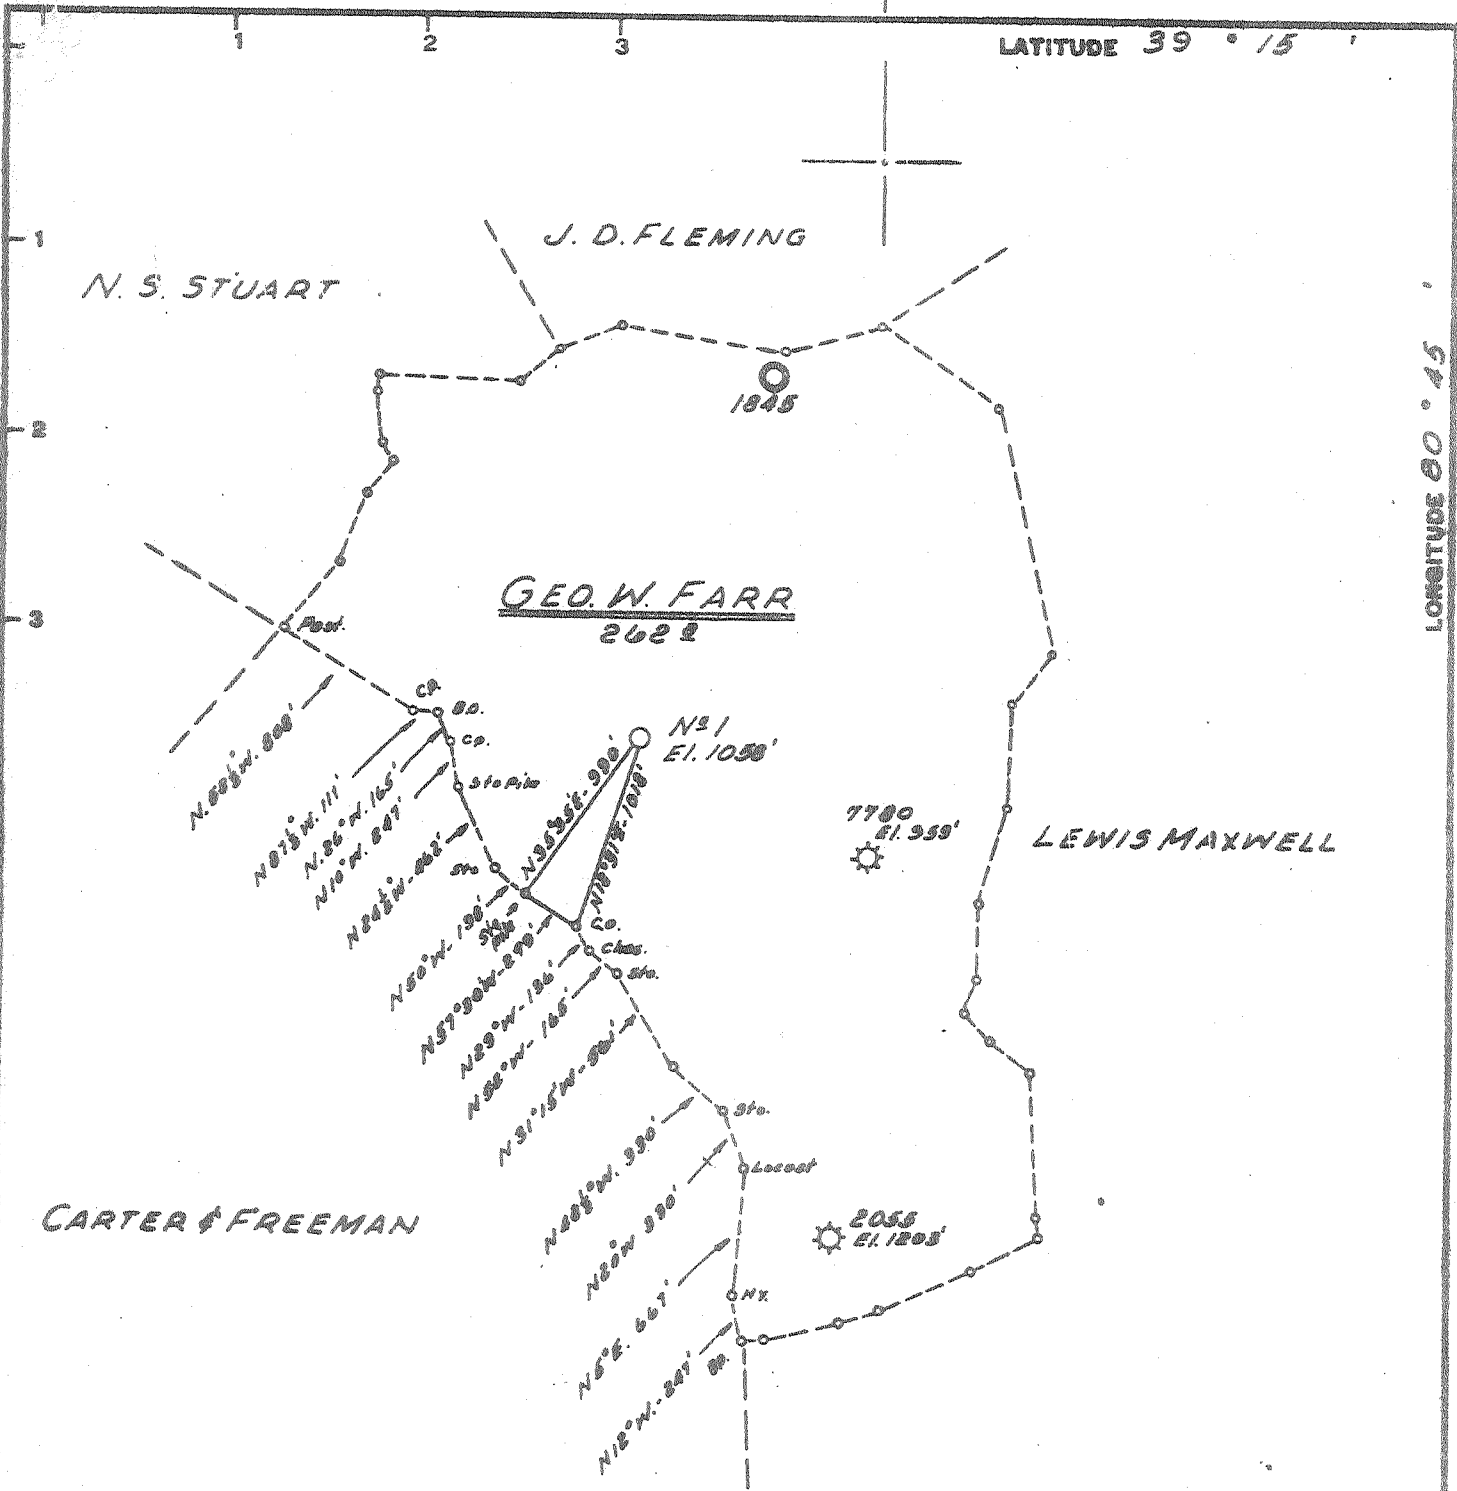

Minimum Error of Closure 1' IN 200'  
 Source of Elevation U.S.G.S. B.M. ELEVATION 881'

"I, the undersigned, hereby certify that this map is correct to the best of my knowledge and belief and shows all the information required by paragraph 6 of the rules and regulations of the oil and gas section of the mining laws of West Virginia."

New Location   
 Drill Deeper   
 Abandonment  *used 10-3-69*

Company DODDRIDGE GAS N# 24  
 Address CLARKSBURG, WEST VA.  
 Farm GEO. W. FARR  
 Tract \_\_\_\_\_ Acres 262 Lease No. \_\_\_\_\_  
 Well (Farm) No. \_\_\_\_\_ Serial No. N#1  
 Elevation (Spirit Level) 1058'  
 Quadrangle HOLBROOK N.E.  
 County DODDRIDGE District WEST UNION  
 Engineer Jackson M. Javis  
 Engineer's Registration No. 2397  
 File No. \_\_\_\_\_ Drawing No. \_\_\_\_\_  
 Date JULY 14, 1969 Scale 1" = 1000'

STATE OF WEST VIRGINIA  
 DEPARTMENT OF MINES  
 OIL AND GAS DIVISION  
 CHARLESTON

WELL LOCATION MAP

FILE NO. Dod-156B-P

*physical 10/9/1969*

+ Denotes location of well on United States Topographic Maps, scale 1 to 62,500, latitude and longitude lines being represented by border lines as shown.

- Denotes one inch spaces on border line of original tracing.

OCT 20 1969



STATE OF WEST VIRGINIA  
DEPARTMENT OF MINES  
OIL AND GAS DIVISION

Rotary   
Spudder   
Cable Tools   
Storage   
Oil or Gas Well DRY (KIND)

Quadrangle Holbrook N. E.  
Permit No. DOD-1568-P


WELL RECORD

Company <u>Doddridge Gas # 24</u>	Casing and Tubing	Used in Drilling	Left in Well	Packers
Address <u>Clarksburg, W. Va.</u>	Size			
Farm <u>George W. Farr</u> Acres <u>262</u>	16	<u>12 ft.</u>	<u>12</u>	Kind of Packer
Location (waters) <u>Arnolds Creek</u>	13			
Well No. _____ Elev. <u>1058</u>	10	<u>261</u>	<u>261</u>	Size of
District <u>West Union</u> County <u>Doddridge</u>	8 1/4	<u>1007</u>		Depth set
The surface of tract is owned in fee by <u>Mrs. Everett Maxwell</u>	6 3/8			
Address <u>West Union, W. Va.</u>	4 1/2	<u>1925</u>	<u>1925</u>	Perf. top
Mineral rights are owned by <u>Mrs. Everett Maxwell</u>	3			Perf. bottom
Address <u>West Union, W. Va.</u>	2			Perf. top
Drilling commenced <u>July 29, 1969</u>	Liners Used			Perf. bottom
Drilling completed <u>Sept. 20, 1969</u>				
Date Shot _____ From _____ To _____				
With _____				

Open Flow \_\_\_\_\_ /10ths Water in \_\_\_\_\_ Inch Attach copy of cementing record.  
 \_\_\_\_\_ /10ths Merc. in \_\_\_\_\_ Inch CASING CEMENTED 4 1/2 SIZE No. Ft. \_\_\_\_\_ Date \_\_\_\_\_  
 Volume Show \_\_\_\_\_ Cu. Ft. Amount of cement used (bags) 65 bags  
 Rock Pressure not taken lbs. \_\_\_\_\_ hrs. Name of Service Co. Garratton Cementing Co.  
 Oil \_\_\_\_\_ bbls., 1st 24 hrs. COAL WAS ENCOUNTERED AT none FEET \_\_\_\_\_ INCHES  
 WELL ACIDIZED (DETAILS) \_\_\_\_\_ FEET \_\_\_\_\_ INCHES FEET \_\_\_\_\_ INCHES  
 \_\_\_\_\_ FEET \_\_\_\_\_ INCHES FEET \_\_\_\_\_ INCHES  
 WELL FRACTURED (DETAILS) 900 BBL water, 57,000# sand, 500 gal. acid

RESULT AFTER TREATMENT (Initial open Flow or bbls.) 20,000 20 MCF Non-commercial  
 ROCK PRESSURE AFTER TREATMENT 50 lb. HOURS 1  
 Fresh Water 40 Feet \_\_\_\_\_ Salt Water \_\_\_\_\_ Feet \_\_\_\_\_  
 Producing Sand \_\_\_\_\_ Depth \_\_\_\_\_

Formation	Color	Hard or Soft	Top	Bottom	Oil, Gas or Water	Depth	Remarks
Red Rock			0	12			
Lime			12	22			
Red Rock			22	40			
Sand			40	50			
Lime			50	74			
Sand			74	80			
Lime			80	90			
Red Rock			90	148			
Lime			148	154			
Lime shells			154	168			
Lime			168	182			
Red Rock			182	205			
Lime			205	242			
Red Rock			242	257			
Lime			257	280			
Sand			280	369			
Red Rock			369	390			
Lime			390	420			
Slate			420	435			
Slate & Shells			435	445			
Lime			445	457			
Slate & Shells			457	488			
Lime			488	500			
Gritty Lime			500	555			
Red Rock			555	600			
Lime			600	615			
Slate & Shells			615	635			
Red Rock			635	657			

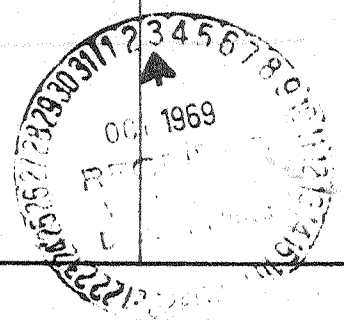

Formation	Color	Hard or Soft	Top	Bottom	Oil, Gas or Water	Depth Found	Remarks
Lime			657	685			
Red Rock			685	705			
Lime			705	722			
Gritty Lime			722	745			
Slate			745	780			
Red Rock			780	810			
Lime			810	855			
Slate			855	870			
Lime			870	905			
Slate & Shells			905	924			
Sand			924	931			
Slate & Shells			931	957			
Lime			957	973			
Slate & Shells			973	985			
Lime			985	1015			
Broken Lime			1015	1036			
Lime			1036	1150			
Lime Shells			1150	1200			
Sand			1200	1245			
Lime Gritty			1245	1263			
Sand			1263	1300			
Lime			1300	1325			
Slate			1325	1335			
Shale			1335	1375			
Sand			1375	1400			
Shale			1400	1423			
Lime Shells			1423	1455			
Sand			1455	1485			
Shale			1485	1505			
Lime			1505	1530			
Slate			1530	1538			
Sand			1538	1575			
Gritty Lime			1575	1605			
Slate & Shells			1605	1625			
Sand			1625	1655			
Slate & Shells			1655	1690			
Lime			1690	1700			
Slate & Shells			1700	1717			
Lime			1717	1823			
Sand <i>Big Injun</i>			1823	1905			
Slate			1905	1927			
Total depth			1927				

Date October 3, 1917

APPROVED: [Signature] #24, Owner

By [Signature] (Title)