


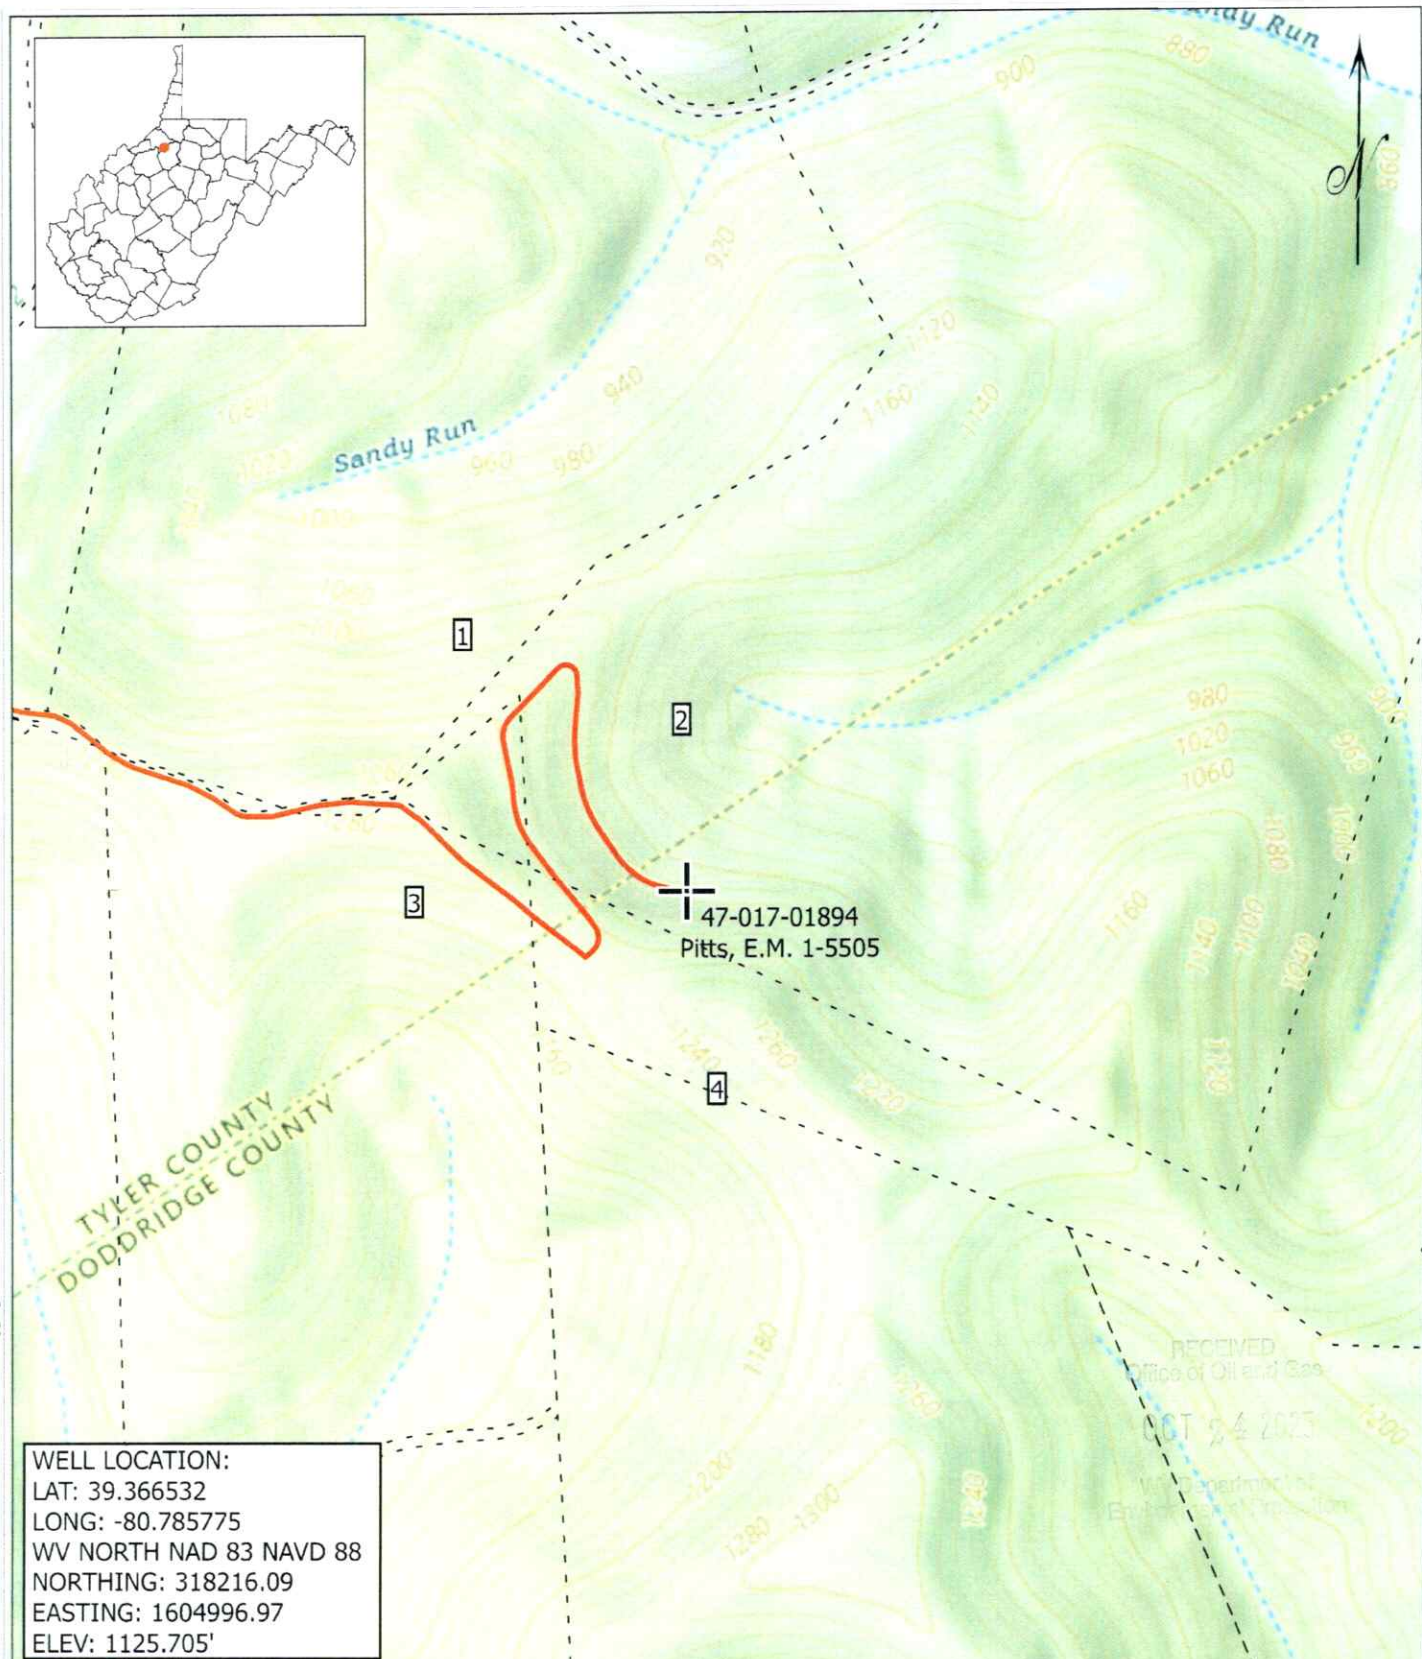

ID	PARCEL ID	OWNER NAME	OWNER ADDRESS
1	48-05-0022-0014-0000	STEINMAN PAUL DEAN JR & STEINMAN MARC J	566 ABERDEEN RD, FRANKFORT, IL 60423
2	48-05-0022-0013-0000	AYALA JESSICA XENIA	239 SANDYS RUN RD, WEST UNION WV 26456
3	09-08-0002-0001-0000	PETROVICH JAMES M	10483 E STATE ROAD 450, SHOALS, IN 47581
4	09-08-0002-0002-0000	BOGGS JASON J	2677 BETHEL-NEW RICHMOND RD, BETHEL, OH 45106

Pitts, E.M. 1-5505 Well Plugging
 47-017-01894
 Doddridge & Tyler County - West Virginia

THRASHER

12/05/2025

WW-7
8-30-06



West Virginia Department of Environmental Protection
Office of Oil and Gas
WELL LOCATION FORM: GPS

API: 47-017-01894 WELL NO.: Pitts, E.M. 1-5505

FARM NAME: _____

RESPONSIBLE PARTY NAME: Equitrans, L.P.

COUNTY: Doddridge DISTRICT: 05

QUADRANGLE: West Union 7.5M

SURFACE OWNER: AYALA JESSICA XENIA

ROYALTY OWNER: _____

UTM GPS NORTHING: 4357474.222

UTM GPS EASTING: 518453.998 GPS ELEVATION: 343.11 (M) 1125.70 (FT)

The Responsible Party named above has chosen to submit GPS coordinates in lieu of preparing a new well location plat for a plugging permit or assigned API number on the above well. The Office of Oil and Gas will not accept GPS coordinates that do not meet the following requirements:

1. Datum: NAD 1983, Zone: 17 North, Coordinate Units: meters, Altitude: height above mean sea level (MSL) – meters.
2. Accuracy to Datum – 3.05 meters
3. Data Collection Method:

Survey grade GPS : Post Processed Differential

Real-Time Differential X

Mapping Grade GPS : Post Processed Differential

Real-Time Differential

4. **Letter size copy of the topography map showing the well location.**

I the undersigned, hereby certify this data is correct to the best of my knowledge and belief and shows all the information required by law and the regulations issued and prescribed by the Office of Oil and Gas.


Signature

PS 2357
Title

10/22/2025
Date

12/05/2025