

9,950'


LATITUDE

39° 12' 30"

LONGITUDE

12.760

*Janie*  
*9/11/97*

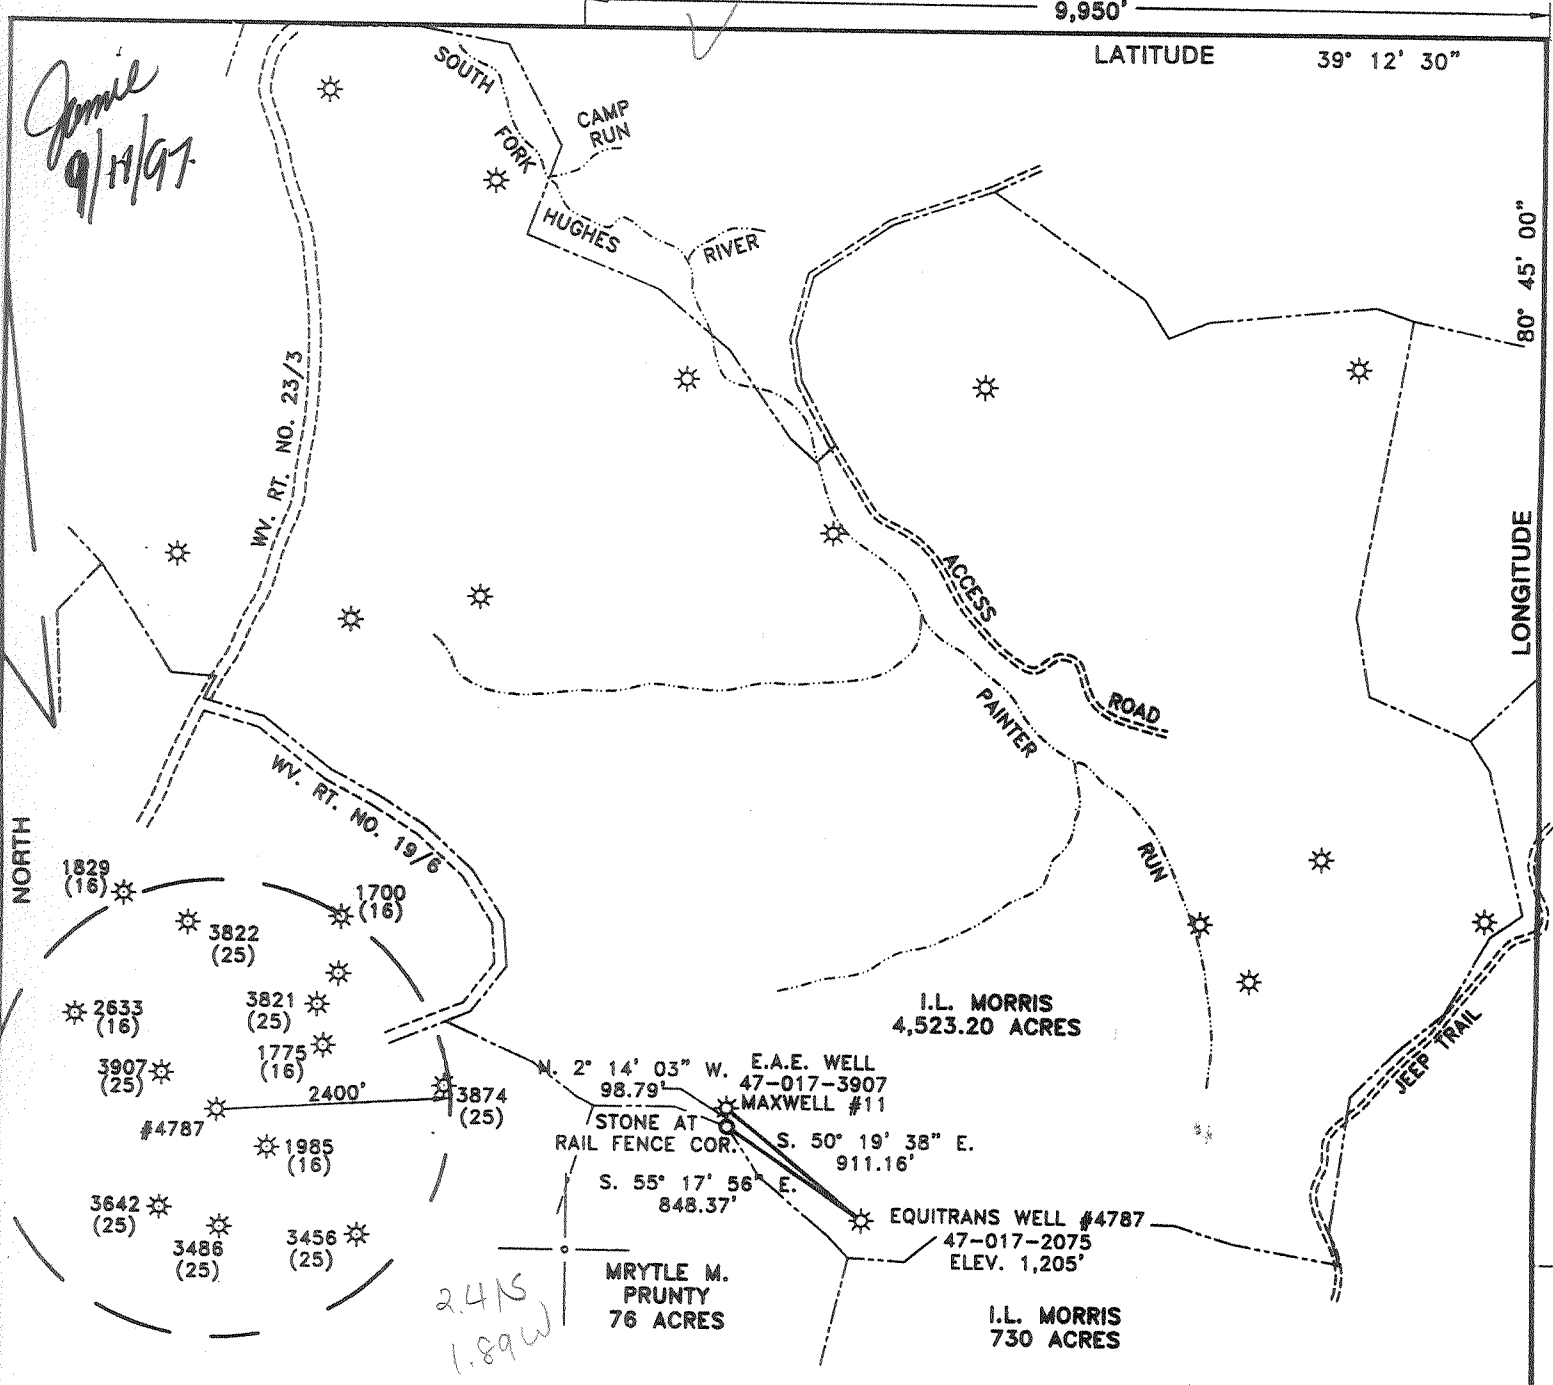


**D. L. WHEELER & ASSOCIATES, INC.**  
 401 N. OHIO AVENUE  
 CLARKSBURG, WEST VIRGINIA 26301  
 Tele. Ph.: 304-623-5851  
 Fax. No.: 304-623-6131

(+) DENOTES LOCATION OF WELL ON UNITED STATES TOPOGRAPHIC MAPS

FILE NO. \_\_\_\_\_  
 DRAWING NO. \_\_\_\_\_  
 SCALE 1" = 1000'  
 MINIMUM DEGREE OF ACCURACY 1 IN 200  
 PROVEN SOURCE OF ELEVATION E.A.E. WELL  
MAXWELL #11

I THE UNDERSIGNED, HEREBY CERTIFY THAT THIS PLAT IS CORRECT TO THE BEST OF MY KNOWLEDGE AND BELIEF AND SHOWS ALL THE INFORMATION REQUIRED BY LAW AND THE REGULATIONS ISSUED AND PRESCRIBED BY THE DEPARTMENT OF ENERGY.  
 (SIGNED) *Daniel L. Wheeler*  
 R.P.E. \_\_\_\_\_ L.L.S. 530  
DANIEL L. WHEELER

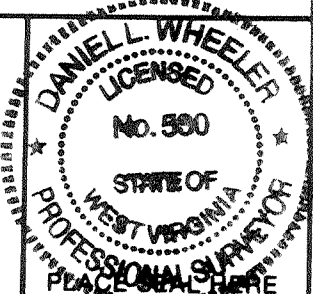

WEST VIRGINIA  
 DIVISION OF ENVIRONMENTAL PROTECTION  
 OFFICE OF OIL AND GAS  
 #10 McJUNKIN ROAD  
 NITRO, WEST VIRGINIA 25143-2506



DATE JULY 24, 19 97  
 OPERATOR'S WELL NO. #4787  
 API WELL NO. \_\_\_\_\_

WELL TYPE: OIL \_\_\_\_\_ GAS X LIQUID INJECTION \_\_\_\_\_ WASTE DISPOSAL \_\_\_\_\_  
 (IF "GAS,") PRODUCTION X STORAGE \_\_\_\_\_ DEEP \_\_\_\_\_ SHALLOW X  
 LOCATION: ELEVATION 1,205' WATER SHED PAINTER RUN  
 DISTRICT SOUTHWEST COUNTY DODDRIDGE  
 QUADRANGLE OXFORD 7.5'

SURFACE OWNER I.L. MORRIS ACREAGE 4,523.20 ACRES  
 OIL & GAS ROYALTY OWNER W.B. MAXWELL HEIRS LEASE ACREAGE 1,891.70 ACRES  
 LEASE NO. 17513

PROPOSED WORK: DRILL \_\_\_\_\_ CONVERT \_\_\_\_\_ DRILL DEEPER \_\_\_\_\_ REDRILL \_\_\_\_\_ FRACTURE OR STIMULATE \_\_\_\_\_ PLUG OFF OLD FORMATION \_\_\_\_\_ PERFORATE NEW FORMATION \_\_\_\_\_ OTHER PHYSICAL CHANGE IN WELL (SPECIFY) Permanent Plugging Pre 1929 Well

PLUG AND ABANDON X CLEAN OUT AND REPLUG \_\_\_\_\_  
 TARGET FORMATION BIG INJUN ESTIMATED DEPTH 1777'  
 WELL OPERATOR EQUITRANS, L.P. DESIGNATED AGENT WILLIAM HOSTUTLER  
 ADDRESS 3500 PARK LANE ADDRESS P.O. BOX 1550  
PITTSBURGH, PA. 15275 CLARKSBURG, WV. 26301

COUNTY NAME PERMIT

SEP 12 1997