


LATITUDE 39° 20' 00"

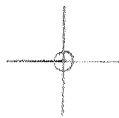

80° 32' 30"

LONGITUDE

7'5 OGIS topo location

7.5' loc	<u>0.66S</u>	15' loc	<u>0.66S</u>
	<u>1.69W</u>	(calc.)	<u>3.92W</u>

Company _____

Farm _____


Quad SALEM 7 1/2' Centerpoint SE

County DODDRIIDGE

District McCLELLAN

WELL LOCATION MAP

File No. 017-2200

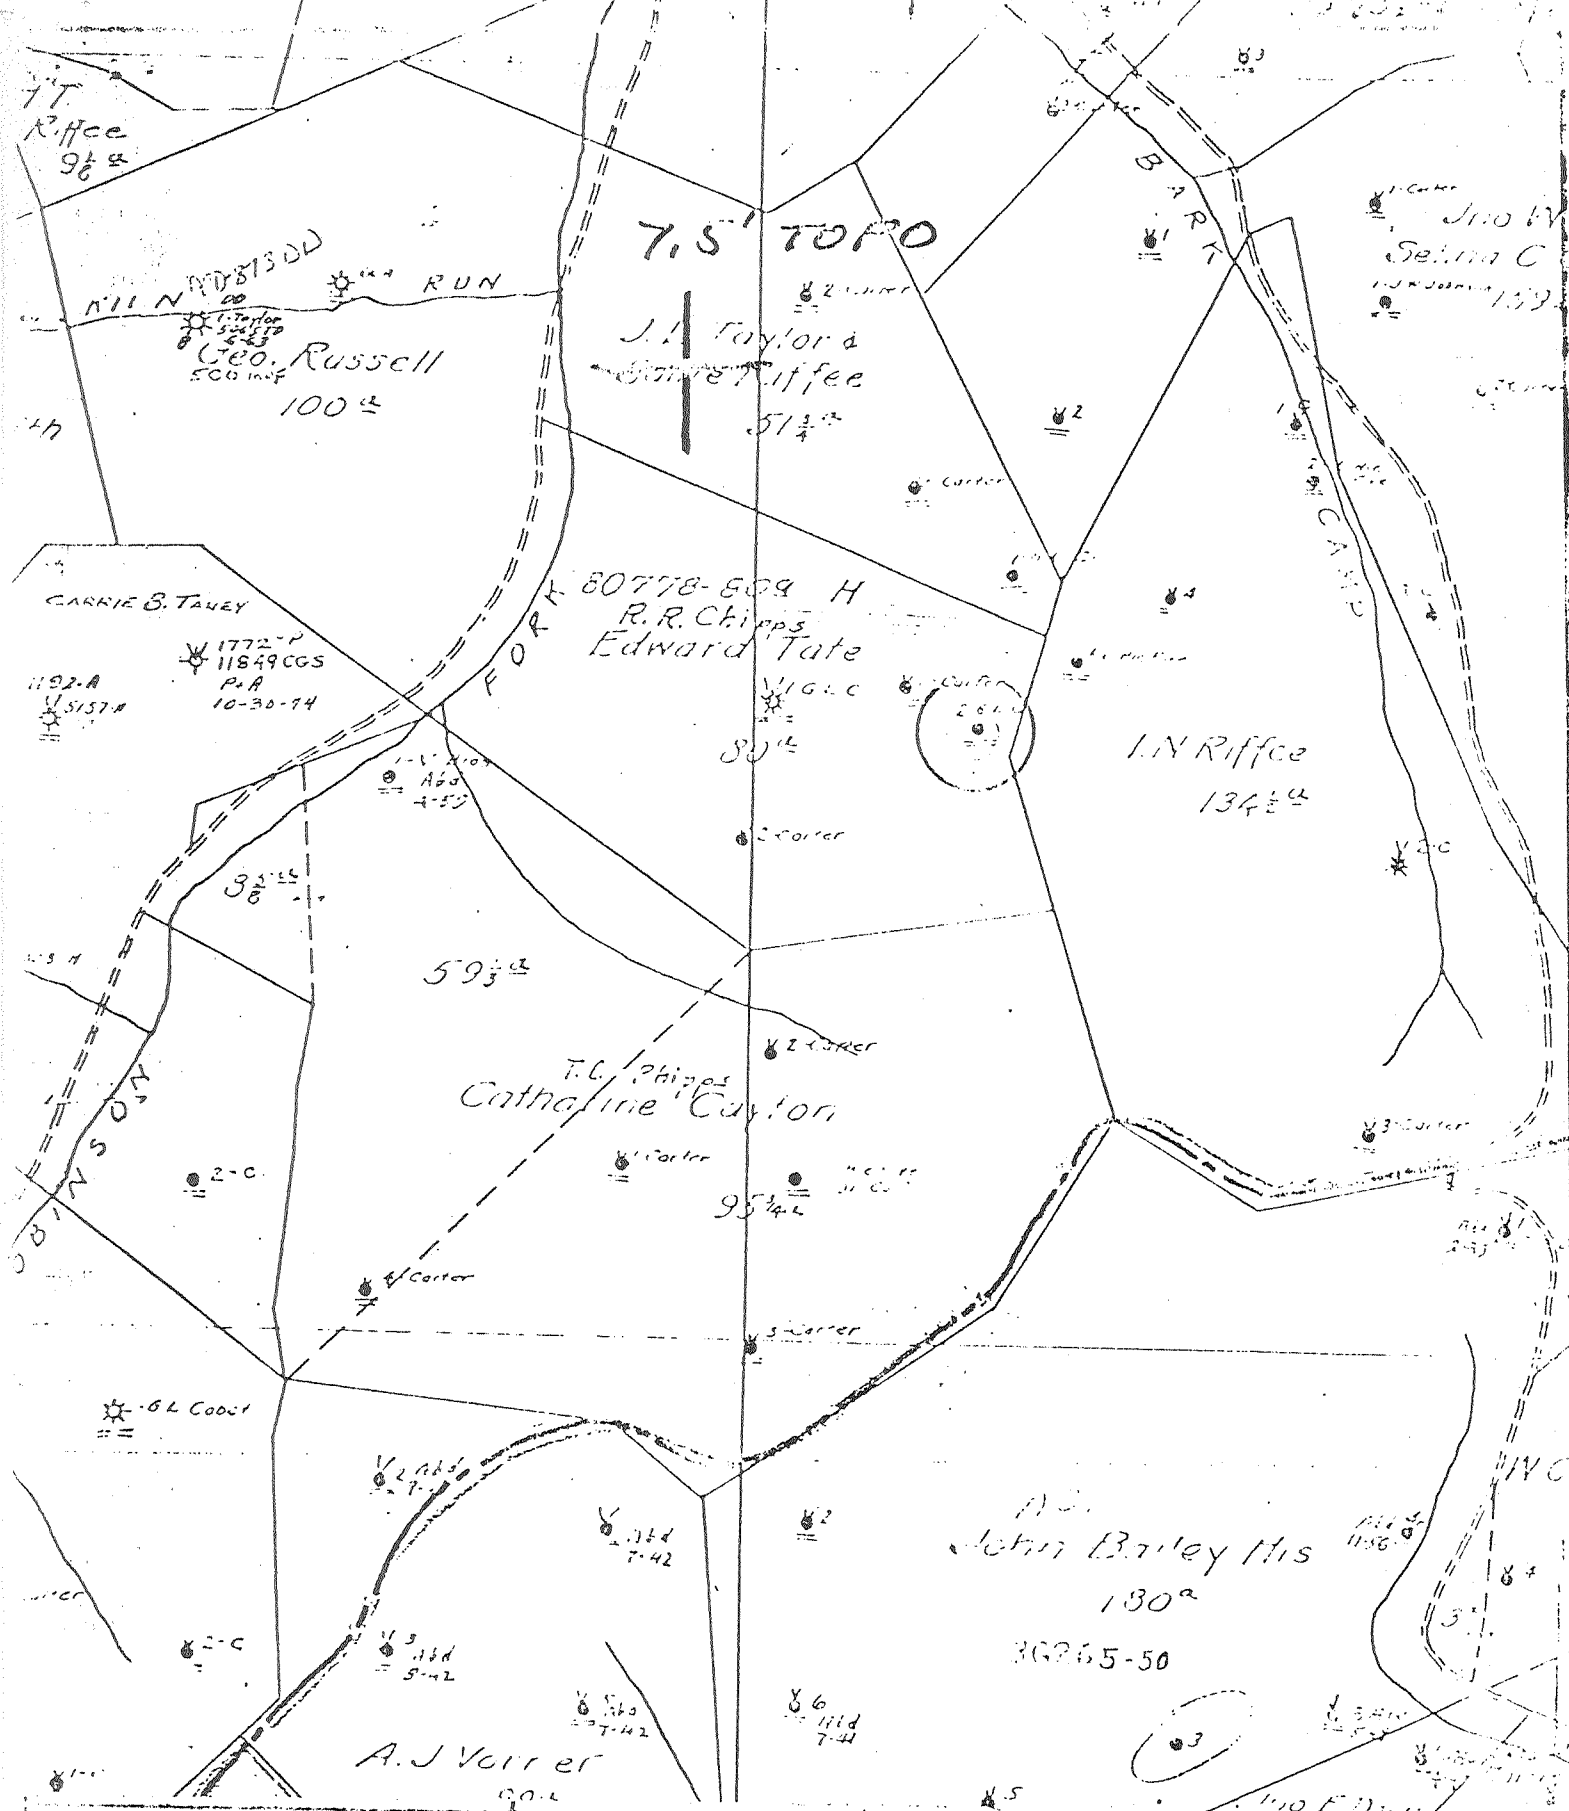

(X) DENOTES LOCATION OF WELL ON UNITED STATES TOPOGRAPHIC MAPS
 FORM IV-6
 (3-78)



DATE Nov 30
 OPERATOR'S WELL NO. _____
 API WELL NO. 47-017-2700
 STATE COUNTY _____

STATE OF WEST VIRGINIA
 DEPARTMENT OF MINES
 OIL AND GAS DIVISION

WELL TYPE: OIL ___ GAS X LIQUID INJECTION ___ WASTE DISPOSAL ___
 (If "GAS", PRODUCTION ___ STORAGE ___ DEEP ___ SHALLOW X
 LOCATION: ELEVATION ___ WATER USED Robinson Forks
 DISTRICT McClellan COUNTY Doddridge
 QUADRANGLE 26.5M 7157
 SURFACE OWNER _____ ACREAGE _____
 OIL & GAS ROYALTY OWNER _____ LEASE NO. 0728-50 LEASE ACREAGE 80
 PROPOSED WORK: DRILL ___ CONVERT ___ RE-DRILL DEEPER ___ RE-DRILL ___ FRACTURE OR
 STIMULATE ___ PLUS OFF OLD FORMATION ___ PERFORATE NEW
 FORMATION ___ OTHER PHYSICAL CHANGE IN WELL (SPECIFY) _____

PLUG AND ABANDON ___ CLEAN OUT AND REPLUG ___
 TARGET FORMATION ___ ESTIMATED DEPTH _____
 WELL OPERATOR Reynolds Company REGISTERED AGENT James A. Crows
 ADDRESS P. O. Box 1588 P. O. Box 1588
Parkersburg, WV 26101 Parkersburg, WV 26101