

WW-7
8-30-06

4701702455P



West Virginia Department of Environmental Protection
Office of Oil and Gas

WELL LOCATION FORM: GPS

API: 47-017-02455 WELL NO.: 3

FARM NAME: Roy Schmidt

RESPONSIBLE PARTY NAME: Mike Ross

COUNTY: Doddridge DISTRICT: Cove

QUADRANGLE: Vadis

SURFACE OWNER: Donald Riffie

ROYALTY OWNER: _____

UTM GPS NORTHING: ~~43300.775~~ 4330078

UTM GPS EASTING: ~~52699.42~~ 526994 GPS ELEVATION: 988'

The Responsible Party named above has chosen to submit GPS coordinates in lieu of preparing a new well location plat for a plugging permit or assigned API number on the above well. The Office of Oil and Gas will not accept GPS coordinates that do not meet the following requirements:

1. Datum: NAD 1983, Zone: 17 North, Coordinate Units: meters, Altitude: height above mean sea level (MSL) – meters.
2. Accuracy to Datum – 3.05 meters
3. Data Collection Method:

Survey grade GPS _____: Post Processed Differential _____

Real-Time Differential _____

Mapping Grade GPS : Post Processed Differential _____

Real-Time Differential _____

RECEIVED
Office of Oil and Gas

MAY 17 2022

WV Department of
Environmental Protection


4. Letter size copy of the topography map showing the well location.

I the undersigned, hereby certify this data is correct to the best of my knowledge and belief and shows all the information required by law and the regulations issued and prescribed by the Office of Oil and Gas.

Mike Ross President
Signature Title

May 12, 2022 06/10/2022
Date

STATE OF WEST VIRGINIA 4701702455 P
REPRESENTED BY THE
STATE OF WEST VIRGINIA GEOLOGICAL SURVEY
AND OTHER STATE AGENCIES

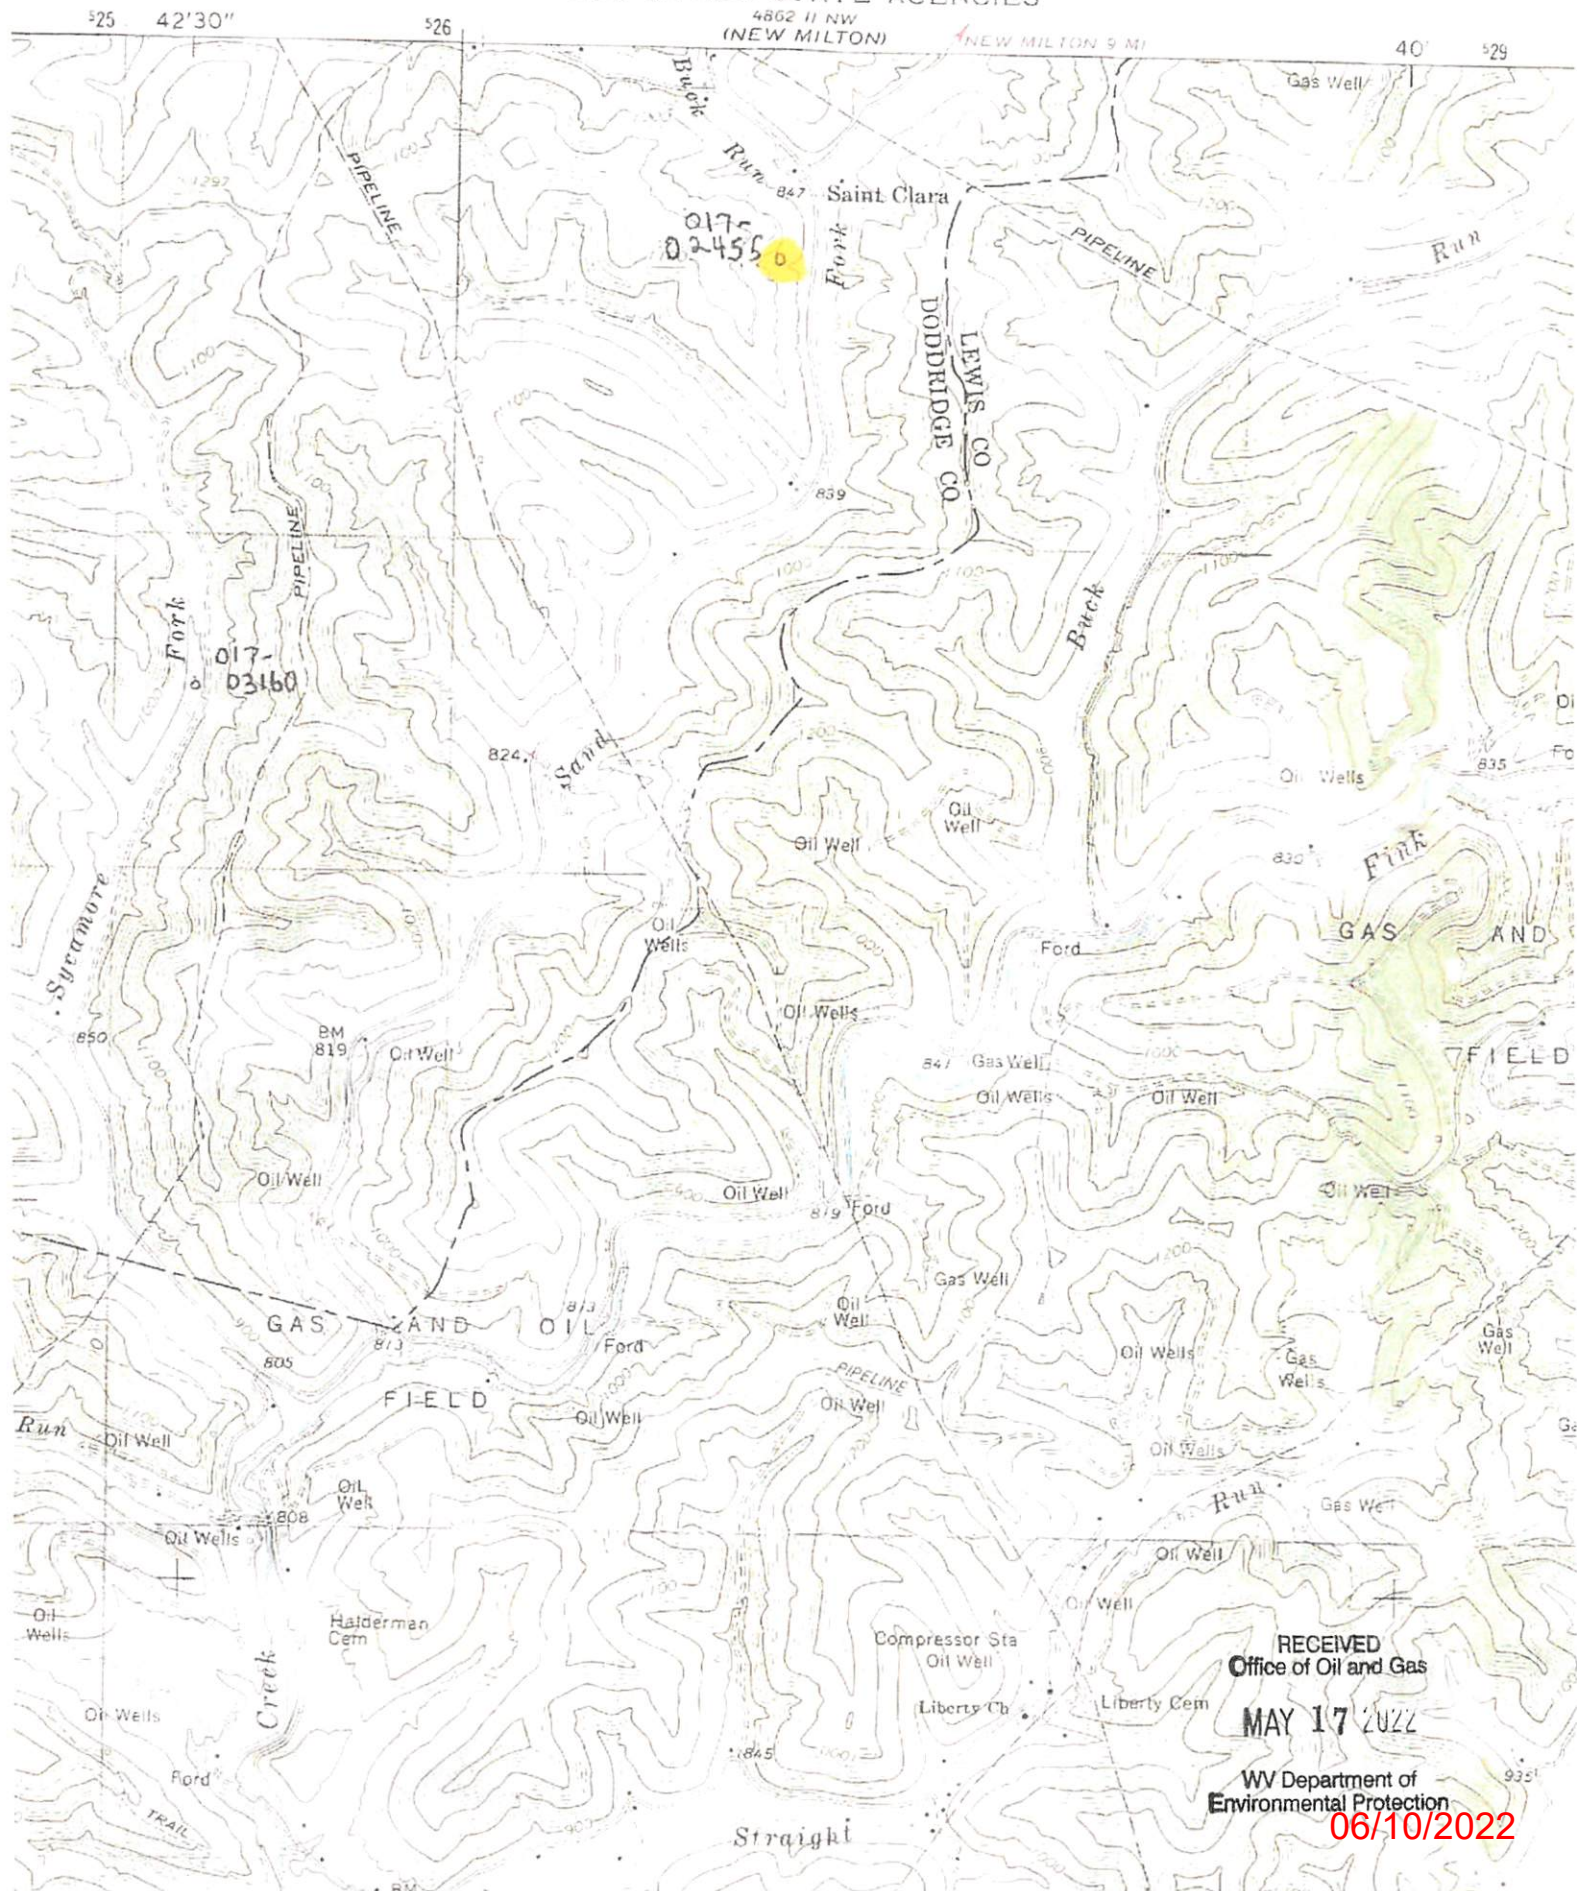

017-02455

017-03160

RECEIVED
Office of Oil and Gas
MAY 17 2022
WV Department of
Environmental Protection
06/10/2022