



west virginia department of environmental protection

Office of Oil and Gas
601 57th Street SE
Charleston, WV 25304
(304) 926-0450
(304) 926-0452 fax

Earl Ray Tomblin, Governor
Randy C. Huffman, Cabinet Secretary
www.dep.wv.gov

January 25, 2016

WELL WORK PERMIT

Horizontal 6A Well

This permit, API Well Number: 47-1706763, issued to ANTERO RESOURCES CORPORATION, is evidence of permission granted to perform the specified well work at the location described on the attached pages and located on the attached plat, subject to the provisions of Chapter 22 of the West Virginia Code of 1931, as amended, and all rules and regulations promulgated thereunder, and to all conditions and provisions outlined in the pages attached hereto. Notification shall be given by the operator to the Oil and Gas Inspector at least 24 hours prior to the construction of roads, locations, and/or pits for any permitted work. In addition, the well operator shall notify the same inspector 24 hours before any actual well work is commenced and prior to running and cementing casing. Spills or emergency discharges must be promptly reported by the operator to 1-800-642-3074 and to the Oil and Gas inspector.

Please be advised that form WR-35, Well Operators Report of Well Work is to be submitted to this office within 90 days completion of permitted well work, as should form WR-34 Discharge Monitoring Report within 30 days of discharge of pits, if applicable. Failure to abide by all statutory and regulatory provisions governing all duties and operations hereunder may result in suspension or revocation of this permit and, in addition, may result in civil and/or criminal penalties being imposed upon the operators.

In addition to the applicable requirements of this permit, and the statutes and rules governing oil and gas activity in WV, this permit may contain specific conditions which must be followed. Permit conditions are attached to this cover letter.

Per 35CSR-4-5.2.g this permit will expire in two (2) years from the issue date unless permitted well work is commenced. If there are any questions, please feel free to contact me at (304) 926-0499 ext. 1654.

James Martin
Chief

Operator's Well No: RAINIER UNIT 2H
Farm Name: COASTAL FOREST RESOURCES
API Well Number: 47-1706763
Permit Type: Horizontal 6A Well
Date Issued: 01/25/2016

PERMIT CONDITIONS 4701700765

West Virginia Code § 22-6A-8(d) allows the Office of Oil and Gas to place specific conditions upon this permit. Permit conditions have the same effect as law. Failure to adhere to the specified permit conditions may result in enforcement action.

CONDITIONS

1. This proposed activity may require permit coverage from the United States Army Corps of Engineers (USACE). Through this permit, you are hereby being advised to consult with USACE regarding this proposed activity.
2. If the operator encounters an unanticipated void, or an anticipated void at an unanticipated depth, the operator shall notify the inspector within 24 hours. Modifications to the casing program may be necessary to comply with W. Va. Code § 22-6A-5a (12), which requires drilling to a minimum depth of thirty feet below the bottom of the void, and installing a minimum of twenty (20) feet of casing. Under no circumstance should the operator drill more than one hundred (100) feet below the bottom of the void or install less than twenty (20) feet of casing below the bottom of the void.
3. When compacting fills, each lift before compaction shall not be more than 12 inches in height, and the moisture content of the fill material shall be within limits as determined by the Standard Proctor Density test of the actual soils used in specific engineered fill, ASTM D698, Standard Test Method for Laboratory Compaction Characteristics of Soil Using Standard Effort, to achieve 95 % compaction of the optimum density. Each lift shall be tested for compaction, with a minimum of two tests per lift per acre of fill. All test results shall be maintained on site and available for review.
4. Operator shall install signage per § 22-6A-8g (6) (B) at all source water locations included in their approved water management plan within 24 hours of water management plan activation.
5. Oil and gas water supply wells will be registered with the Office of Oil and Gas and all such wells will be constructed and plugged in accordance with the standards of the Bureau for Public Health set forth in its Legislative rule entitled *Water Well Regulations*, 64 C.S.R. 19. Operator is to contact the Bureau of Public Health regarding permit requirements. In lieu of plugging, the operator may transfer the well to the surface owner upon agreement of the parties. All drinking water wells within fifteen hundred feet of the water supply well shall be flow tested by the operator upon request of the drinking well owner prior to operating the water supply well.
6. Pursuant to the requirements pertaining to the sampling of domestic water supply wells/springs the operator shall, no later than thirty (30) days after receipt of analytical data provide a written copy to the Chief and any of the users who may have requested such analyses.
7. If any explosion or other accident causing loss of life or serious personal injury occurs in or about a well or well work on a well, the well operator or its contractor shall give notice, stating the particulars of the explosion or accident, to the oil and gas inspector and the Chief, within 24 hours of said accident.
8. During the casing and cementing process, in the event cement does not return to the surface, the oil and gas inspector shall be notified within 24 hours.
9. The operator shall provide to the Office of Oil and Gas the dates of each of the following within 30 days of their occurrence: completion of construction of the well pad, commencement of drilling, cessation of drilling, completion of any other permitted well work, and completion of the well. Such notice shall be provided by sending an email to DEPOOGNotify@wv.gov.



January 12, 2016

Antero Resources
1615 Wynkoop Street
Denver, CO 80202
Office 303.357.7310
Fax 303.357.7315

West Virginia Department of Environmental Protection
Office of Oil and Gas
Attn: Ms. Kelly Kees
601 57th Street
Charleston, WV 25304

Ms. Kees:

Antero Resources Corporation (Antero) would like to submit the following permit update for the recently submitted permit application for the Rainer Unit 2H (API# 47-017-06763) on the existing Cofor Pad. We are requesting to change the tangent point and extend the lateral length and associated Estimated Measured Depth from what was originally submitted on 11/12/2015.

Attached you will find the following documents:

- UPDATED Form WW-6B, which shows the updated BHL and Measured Depth
- UPDATED Mylar Plat, which shows the new Lateral Length and Estimated Measured Depth
- UPDATED Form WW-6A1, which shows the new leases we will be drilling

If you have any questions please feel free to contact me at (303) 357-7323.

Thank you in advance for your consideration.

Sincerely,

Ashlie Steele
Permitting Supervisor
Antero Resources Corporation

Enclosures

RECEIVED
Office of Oil and Gas

JAN 13 2016

WV Department of
Environmental Protection

01/29/2016



November 12, 2015

Antero Resources
1615 Wynkoop Street
Denver, CO 80202
Office 303.357.7310
Fax 303.357.7315

West Virginia Department of Environmental Protection
Office of Oil and Gas
Attn: Ms. Laura Adkins
601 57th Street
Charleston, WV 25304

Ms. Laura Adkins:

Antero Resources Corporation (Antero) would like to submit the following application for a new well work permit to explore for Marcellus Shale potential. Our **West Union** project is located in Doddridge County, WV. On the existing **Cofor Pad** consists **one new horizontal** shallow well (Rainer Unit 2H) that we are requesting approval to drill.

Attached you will find the following:

- Permit Application package
- CD with copy of permit application

If you have any questions please feel free to contact me at (303) 357-7323.

Thank you in advance for your consideration.

Sincerely,

A handwritten signature in blue ink that reads "Ashlie Steele".

Ashlie Steele
Permitting Supervisor
Antero Resources Corporation

Enclosures

RECEIVED
Office of Oil and Gas
NOV 13 2015
WV Department of
Environmental Protection

0701706765

01/29/2016

WW-6B
(04/15)

API# 47-017-06763 PERMIT UPDATE API NO. 47-017 - 06763
OPERATOR WELL NO. Rainer Unit 2H
Well Pad Name: Cofor Pad

STATE OF WEST VIRGINIA
DEPARTMENT OF ENVIRONMENTAL PROTECTION, OFFICE OF OIL AND GAS
WELL WORK PERMIT APPLICATION

1) Well Operator: Antero Resources Corporation 494488557 017- Doddridge Union Pullman 7.5'
Operator ID County District Quadrangle

2) Operator's Well Number: Rainer Unit 2H Well Pad Name: Cofor Pad

3) Farm Name/Surface Owner: Coastal Forest Resources Company Public Road Access: CR 11/8

4) Elevation, current ground: 1189' Elevation, proposed post-construction: 1189'

5) Well Type (a) Gas Oil _____ Underground Storage _____
Other _____

(b) If Gas Shallow Deep _____
Horizontal _____

*Bryan Bean
1-12-16*

6) Existing Pad: Yes or No Yes

7) Proposed Target Formation(s), Depth(s), Anticipated Thickness and Expected Pressure(s):
Marcellus Shale: 7900' TVD, Anticipated Thickness- 60 feet, Associated Pressure- 3100#

8) Proposed Total Vertical Depth: 7900' TVD

9) Formation at Total Vertical Depth: Marcellus Shale

10) Proposed Total Measured Depth: 17800' MD

11) Proposed Horizontal Leg Length: 8628'

12) Approximate Fresh Water Strata Depths: 120'

13) Method to Determine Fresh Water Depths: Outback Unit 1H (API# 47-17-06518) on same pad.

14) Approximate Saltwater Depths: 764'

15) Approximate Coal Seam Depths: 853'

16) Approximate Depth to Possible Void (coal mine, karst, other): None anticipated

17) Does Proposed well location contain coal seams directly overlying or adjacent to an active mine? Yes _____ No

(a) If Yes, provide Mine Info: Name: _____
Depth: _____
Seam: _____
Owner: _____

RECEIVED
Office of Oil and Gas

JAN 13 2016

West Virginia Department of
Environmental Protection

01/29/2016

WW-6B
(04/15)

API# 47-017-06763 PERMIT UPDATE API NO. 47- 017 - 06763

OPERATOR WELL NO. Rainer Unit 2H

Well Pad Name: Color Pad

18)

CASING AND TUBING PROGRAM

TYPE	Size (in)	New or Used	Grade	Weight per ft. (lb/ft)	FOOTAGE: For Drilling (ft)	INTERVALS: Left in Well (ft)	CEMENT: Fill-up (Cu. Ft.)/CTS
Conductor	20"	New	H-40	94#	40'	40'	CTS, 38 Cu. Ft.
Fresh Water	13-3/8"	New	J-55/H-40	54.5#/48#	300'	300'	CTS, 417 Cu. Ft.
Coal	9-5/8"	New	J-55	36#	2400'	2400'	CTS, 977 Cu. Ft.
Intermediate							
Production	5-1/2"	New	P-110	20#	17800'	17800'	4517 Cu. Ft.
Tubing	2-3/8"	New	N-80	4.7#		7100'	
Liners							

*Supp. Hvac
7-12-16*

TYPE	Size (in)	Wellbore Diameter (in)	Wall Thickness (in)	Burst Pressure (psi)	Anticipated Max. Internal Pressure (psi)	Cement Type	Cement Yield (cu. ft./k)
Conductor	20"	24"	0.438"	1530	50	Class A	1.18
Fresh Water	13-3/8"	17-1/2"	0.38"/0.33"	2730/1730	1000	Class A	1.18
Coal	9-5/8"	12-1/4"	0.352"	3520	1500	Class A	1.18
Intermediate							
Production	5-1/2"	8-3/4" & 8-1/2"	0.361"	12630	2500	Lead to POZ & Tail - H	H/POZ-1.44 & H-1.8
Tubing	2-3/8"	4.778"	0.19"	11200			
Liners							

PACKERS

Kind:	N/A			
Sizes:	N/A			
Depths Set:	N/A			

RECEIVED
Office of Oil and Gas

Page 7 of 3
JAN 13 2016

WV Department of
Environmental Protection

01/29/2016

19) Describe proposed well work, including the drilling and plugging back of any pilot hole:

Drill, perforate, fracture a new horizontal shallow well and complete Marcellus Shale.

20) Describe fracturing/stimulating methods in detail, including anticipated max pressure and max rate:

Antero plans to pump Slickwater into the Marcellus Shale formation in order to ready the well for production. The fluid will be comprised of approximately 99 percent water and sand, with less than 1 percent special-purpose additives as shown in the attached "List of Anticipated Additives Used for Fracturing or Stimulating Well."

Anticipated Max Pressure - 9300 lbs
Anticipated Max Rate - 80 bpm

21) Total Area to be disturbed, including roads, stockpile area, pits, etc., (acres): 50.15 existing acres

22) Area to be disturbed for well pad only, less access road (acres): 3.70 existing acres

23) Describe centralizer placement for each casing string:

Conductor: no centralizers
Surface Casing: one centralizer 10' above the float shoe, one on the insert float collar and one every 4th joint spaced up the hole to surface.
Intermediate Casing: one centralizer above float joint, one centralizer 5' above float collar and one every 4th collar to surface.
Production Casing: one centralizer at shoe joint and one every 3 joints to top of cement in intermediate casing.

24) Describe all cement additives associated with each cement type:

Conductor: no additives, Class A cement.
Surface: Class A cement with 2-3% calcium chloride and 1/4 lb of flake
Intermediate: Class A cement with 1/4 lb of flake, 5 gallons of clay treat
Production: Lead cement- 50/50 Class H/Poz + 1.5% salt + 1% C-45 + 0.5% C-16a + 0.2% C-12 + 0.45% C-20 + 0.05% C-51
Production: Tail cement- Class H + 45 PPS Calcium Carbonate + 1.0% FL-160 + 0.2% ACGB-47 + 0.05% ACSA-51 + 0.2% ACR-20

25) Proposed borehole conditioning procedures:

Conductor: blowhole clean with air, run casing, 10 bbls fresh water.
Surface: blowhole clean with air, trip to conductor shoe, trip to bottom, blowhole clean with air, trip out, run casing, circulate pipe capacity + 40 bbls fresh water followed by 25 bbls bentonite mud, 10 bbls fresh water spacer.
Intermediate: blowhole clean with air, trip to surface casing shoe, trip to bottom, blowhole clean with air, trip out, run casing, circulate 40 bbls brine water followed by 10 bbls fresh water and 25 bbls bentonite mud, pump 10 bbls fresh water.
Production: circulate with 14 lb/gal NaCl mud, trip to middle of lateral, circulate, pump high viscosity sweep, trip to base of curve, pump high viscosity sweep, trip to top of curve, trip to bottom, circulate, pump high viscosity sweep, trip out, run casing, circulate 10 bbls fresh water, pump 48 bbls barite pill, pump 10 bbls fresh water followed by 48 bbls mud flush and 10 bbls water.

*Note: Attach additional sheets as needed.

Office of Oil and Gas
JAN 13 2016
Page 3 of 3
WV Department of
Environmental Protection

01/29/2016

WW-9
(2/15)

API Number 47 - 017 - _____
Operator's Well No. Rainer Unit 2H

STATE OF WEST VIRGINIA
DEPARTMENT OF ENVIRONMENTAL PROTECTION
OFFICE OF OIL AND GAS

FLUIDS/ CUTTINGS DISPOSAL & RECLAMATION PLAN

Operator Name Antero Resources Corporation OP Code 494488557
Watershed (HUC 10) Headwaters Middle Island Creek Quadrangle West Union 7.5'

Do you anticipate using more than 5,000 bbls of water to complete the proposed well work? Yes No

Will a pit be used? Yes No

If so, please describe anticipated pit waste: No pit will be used at this site (Drilling and Flowback Fluids will be stored in tanks. Cuttings will be tanked and hauled off site).

Will a synthetic liner be used in the pit? Yes No If so, what ml.? N/A

Proposed Disposal Method For Treated Pit Wastes:

- Land Application
- Underground Injection (UIC Permit Number _____)
- Reuse (at API Number Future permitted well locations when applicable. API# will be provided on Form WR-34)
- Off Site Disposal (Supply form WW-9 for disposal location) (Meadowfill Landfill Permit #SWF-1032-98)
- Other (Explain _____)

Will closed loop system be used? If so, describe: Yes

Drilling medium anticipated for this well (vertical and horizontal)? Air, freshwater, oil based, etc.

Surface - Air/Freshwater, Intermediate - Dust/Stiff Foam, Production - Water Based Mud

-If oil based, what type? Synthetic, petroleum, etc. N/A

Additives to be used in drilling medium? Please See Attachment

Drill cuttings disposal method? Leave in pit, landfill, removed offsite, etc. Stored in tanks, removed offsite and taken to landfill.

-If left in pit and plan to solidify what medium will be used? (cement, lime, sawdust) N/A

-Landfill or offsite name/permit number? Meadowfill Landfill (Permit #SWF-1032-98)

Office of Oil and Gas
WV Dept. of Environmental Protection

Received

NOV 20 2015

Permittee shall provide written notice to the Office of Oil and Gas of any load of drill cuttings or associated waste rejected at any West Virginia solid waste facility. The notice shall be provided within 24 hours of rejection and the permittee shall also disclose where it was properly disposed.


I certify that I understand and agree to the terms and conditions of the GENERAL WATER POLLUTION PERMIT issued on August 1, 2005, by the Office of Oil and Gas of the West Virginia Department of Environmental Protection. I understand that the provisions of the permit are enforceable by law. Violations of any term or condition of the general permit and/or other applicable law or regulation can lead to enforcement action.

I certify under penalty of law that I have personally examined and am familiar with the information submitted on this application form and all attachments thereto and that, based on my inquiry of those individuals immediately responsible for obtaining the information, I believe that the information is true, accurate, and complete. I am aware that there are significant penalties for submitting false information, including the possibility of fine or imprisonment.

Company Official Signature [Signature]

Company Official (Typed Name) Cole Kilstrom

Company Official Title Environmental & Regulatory Manager

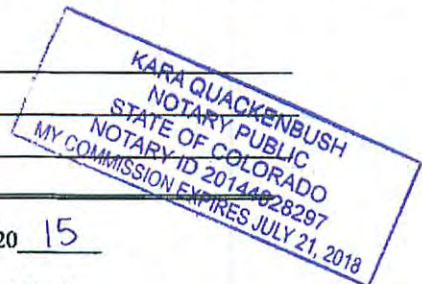

Subscribed and sworn before me this 11th day of November, 20 15

[Signature]

Notary Public

My commission expires July 21, 2018

01/29/2016

Antero Resources Corporation

Proposed Revegetation Treatment: Acres Disturbed 50.15 existing acres Prevegetation pH _____

Lime 2-3 Tons/acre or to correct to pH 6.5

Fertilizer type Hay or straw or Wood Fiber (will be used where needed)

Fertilizer amount 500 lbs/acre

Mulch 2-3 Tons/acre

Access Roads (24.12) + Staging Areas (1.39) + Rock Run Well Pad (6.81) + Cofor Well Pad (3.70) + Water Containment Pad (2.27) + Excess/Topsoil Material Stockpiles (11.86) = 50.15 Existing Acres

Temporary		Permanent	
Seed Type	lbs/acre	Seed Type	lbs/acre
Annual Ryegrass	40	Crownvetch	10-15
*See attached Table 3 for additional seed type (Cofor Pad Design Page 19)		*See attached Table 4a for additional seed type (Cofor Pad Design Page 19)	
*or type of grass seed requested by surface owner		*or type of grass seed requested by surface owner	
*No Fescue or Timothy Grass shall be used			

Attach:

Drawing(s) of road, location, pit and proposed area for land application (unless engineered plans including this info have been provided)

Photocopied section of involved 7.5' topographic sheet.

Plan Approved by: *Debra O'Hara*

Comments: _____

4701706763

Title: *Inspection* Date: *11-16-15*

Field Reviewed? () Yes () No

Received

NOV 20 2015

Office of Oil and Gas
WV Dept. of Environmental Protection

Form WW-9 Additives Attachment

SURFACE INTERVAL

1. Fresh Water
2. Soap –Foamer AC
3. Air

INTERMEDIATE INTERVAL

4701706765

STIFF FOAM RECIPE:

- 1) 1 ppb Soda Ash / Sodium Carbonate-Alkalinity Control Agent
- 2) 1 ppb Conqor 404 (11.76 ppg) / Corrosion Inhibitor
- 3) 4 ppb KLA-Gard (9.17 ppg) / Amine Acid Complex-Shale Stabilizer
- 4) 1ppb Mil Pac R / Sodium Carboxymethylcellulose-Filtration Control Agent
- 5) 12 ppb KCL / Potassium Chloride-inorganic Salt
- 6) Fresh Water 80 bbls
- 7) Air

PRODUCTION INTERVAL

1. Alpha 1655
Salt Inhibitor
2. Mil-Carb
Calcium Carbonate
3. Cottonseed Hulls
Cellulose-Cottonseed Pellets – LCM
4. Mil-Seal
Vegetable, Cotton & Cellulose-Based Fiber Blend – LCM
5. Clay-Trol
Amine Acid Complex – Shale Stabilizer
6. Xan-Plex
Viscosifier For Water Based Muds
7. Mil-Pac (All Grades)
Sodium Carboxymethylcellulose – Filtration Control Agent
8. New Drill
Anionic Polyacrylamide Copolymer Emulsion – Shale Stabilizer
9. Caustic Soda
Sodium Hydroxide – Alkalinity Control
10. Mil-Lime
Calcium Hydroxide – Lime
11. LD-9
Polyether Polyol – Drilling Fluid Defoamer
12. Mil Mica
Hydro-Biotite Mica – LCM

RECEIVED
Office of Oil and Gas
NOV 13 2015
WV Department of
Environmental Protection


01/29/2016

13. Escaid 110
Drilling Fluid Solvent – Aliphatic Hydrocarbon
14. Ligo
Highly Oxidized Leonardite – Filtration Control Agent
15. Super Sweep
Polypropylene – Hole Cleaning Agent
16. Sulfatrol K
Drilling Fluid Additive – Sulfonated Asphalt Residuum
17. Sodium Chloride, Anhydrous
Inorganic Salt
18. D-D
Drilling Detergent – Surfactant
19. Terra-Rate
Organic Surfactant Blend
20. W.O. Defoam
Alcohol-Based Defoamer
21. Perma-Lose HT
Fluid Loss Reducer For Water-Based Muds
22. Xan-Plex D
Polysaccharide Polymer – Drilling Fluid Viscosifier
23. Walnut Shells
Ground Cellulosic Material – Ground Walnut Shells – LCM
24. Mil-Graphite
Natural Graphite – LCM
25. Mil Bar
Barite – Weighting Agent
26. X-Cide 102
Biocide
27. Soda Ash
Sodium Carbonate – Alkalinity Control Agent
28. Clay Trol
Amine Acid complex – Shale Stabilizer
29. Sulfatrol
Sulfonated Asphalt – Shale Control Additive
30. Xanvis
Viscosifier For Water-Based Muds
31. Milstarch
Starch – Fluid Loss Reducer For Water Based Muds
32. Mil-Lube
Drilling Fluid Lubricant

4701706705

RECEIVED
Office of Oil and Gas
NOV 13 2015
WV Department of
Environmental Protection

01/29/2016

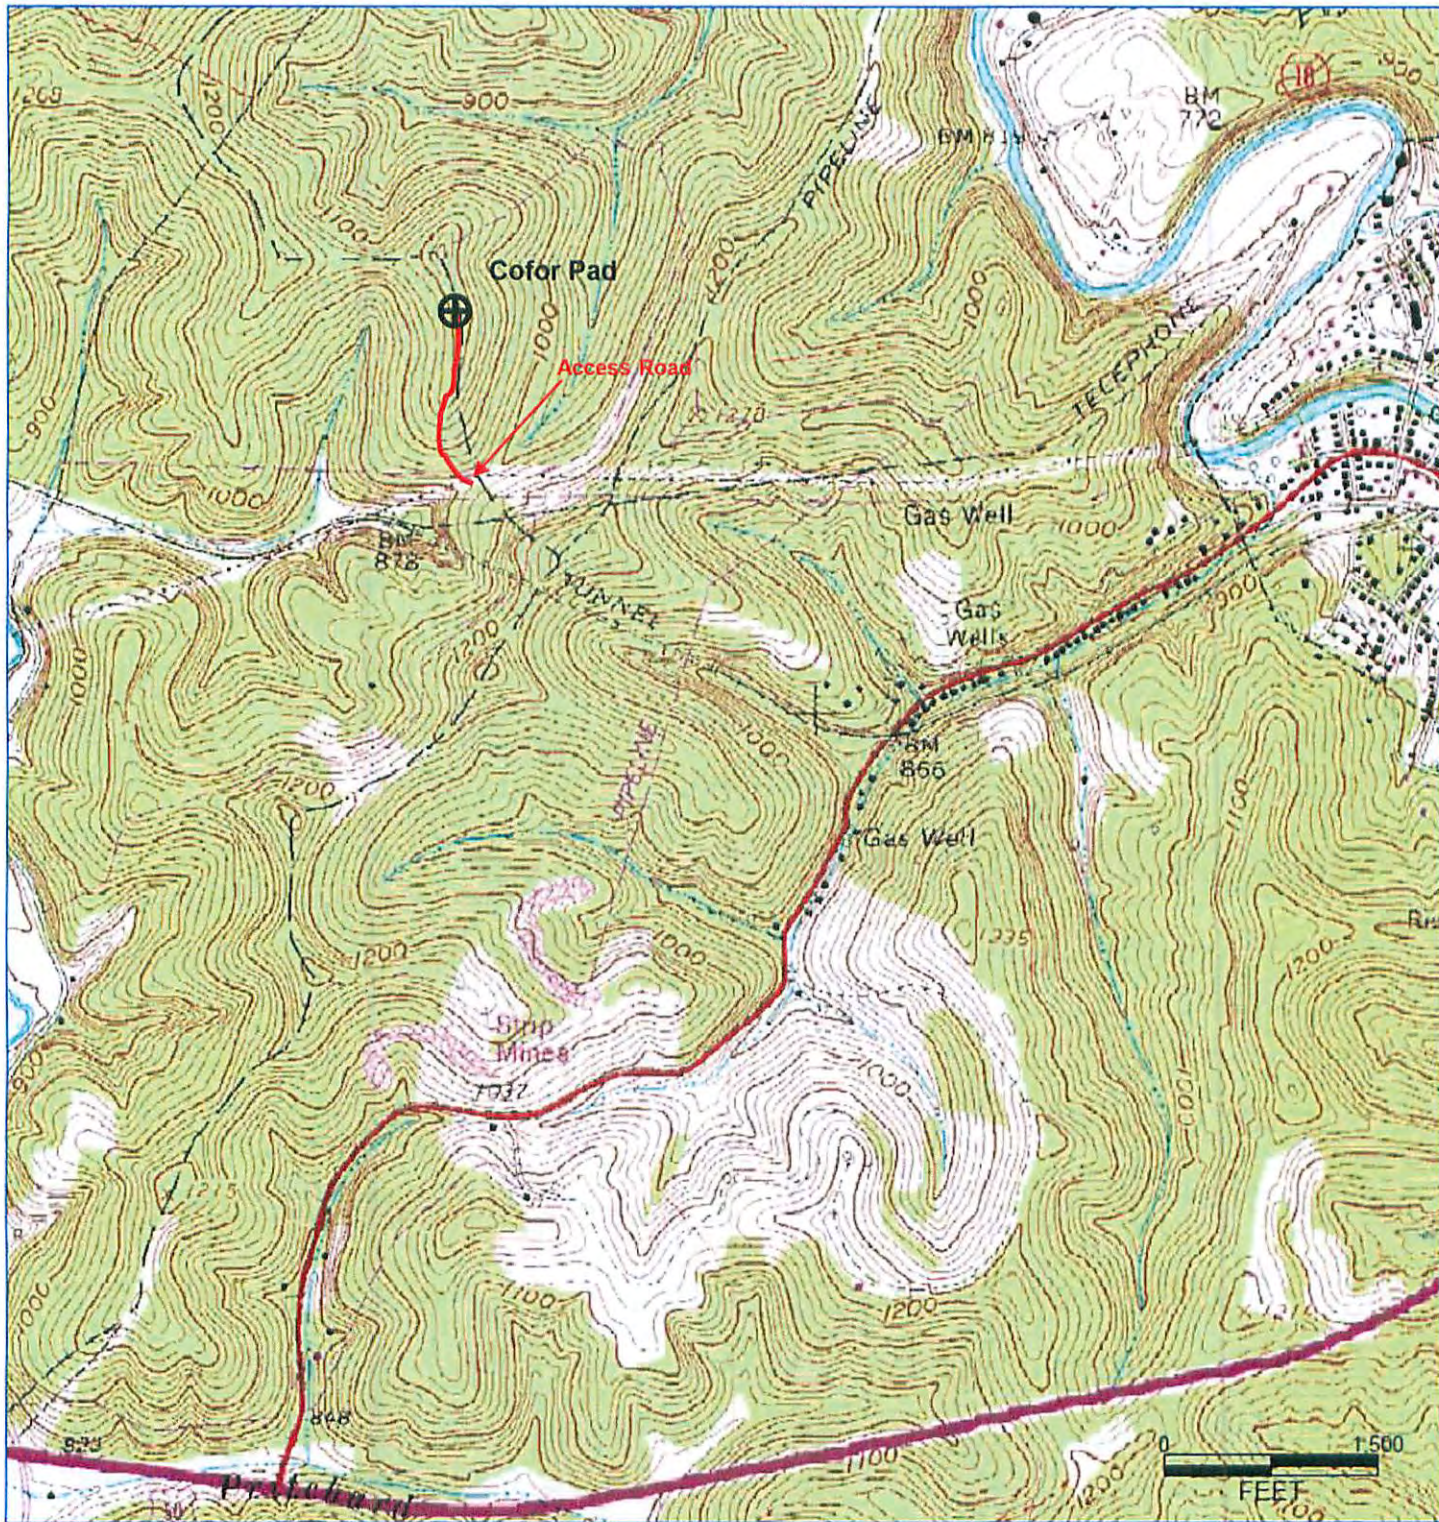

Antero Resources Corporation
 Appalachian Basin
 Rainer Unit 2H
 Doddridge County

Quadrangle: West Union 7.5'
 Watershed: Headwaters Middle Island Creek
 District: West Union
 Date: 4-01-2014

4701706765

RECEIVED
 Office of Oil and Gas
 WV Department of
 Environmental Protection
 NOV 13 2015

01/29/2016



911 Address
770 Tunnel Hill Rd.
West Union, WV 26456

Bryan O'Hara
11-16-15

Well Site Safety Plan

Antero Resources

Well Name: Outback Unit 1H, Outback Unit 2H, Morton Unit 1H, Morton Unit 2H, Nova Unit 1H, Nova Unit 2H, Grape Unit 1H, Grape Unit 2H, Rainer Unit 1H, Rainer Unit 2H

Pad Location: COFOR PAD
Doddridge County/West Union District

GPS Coordinates: Lat 39°17'57.92"/Long -80°48'0.20" (NAD83)

Driving Directions:

From West Union, WV: Drive west on HWY 50 W 2.6 miles. Turn right onto US-50 West 2.6 miles. Turn right on Co. Route 11/Arnolds Creek Rd. 1.4 miles. Turn right onto Tunnel Hill Rd. 0.75 miles. Turn left onto access road. Look for rig signs.

Received

NOV 20 2015

Office of Oil and Gas
WV Dept. of Environmental Protection

4701706753

EMERGENCY (24 HOUR) CONTACT 1-800-878-1373

LATITUDE 39°20'00"

2,425'

9,395' TO BOTTOM HOLE

LATITUDE 39°17'30"

LONGITUDE 80°45'00"

4,638' TO BOTTOM HOLE

12,425'

LONGITUDE 80°47'30"


Antero Resources Corporation
Well No. Rainer Unit 2H

NOTES:
 WELL 2H TOP HOLE INFORMATION:
 N: 293,755ft E: 1,632,045ft
 LAT: 39°17'57.19" LON: 80°48'00.85"
 BOTTOM HOLE INFORMATION:
 N: 286,298ft E: 1,636,763ft
 LAT: 39°16'44.16" LON: 80°46'59.48"
 WEST VIRGINIA COORDINATE SYSTEM OF 1927 NORTH ZONE. ZONE WAS DERIVED FROM MEASUREMENTS TAKEN WITH TRIMBLE GEOXT SUBMETER MAPPING GRADE GPS UNIT. PLAT ORIENTATION, CORNER, AND WELL REFERENCE TIE LINES ARE BASED ON GRID NORTH.


(NAD) 83 (UTM) ZONE 17 COORDS:
 WELL 2H TOP HOLE INFORMATION:
 N: 4,350,010m E: 517,240m
 BOTTOM HOLE INFORMATION:
 N: 4,347,763m E: 518,715m

NOTE:
 1. NO OCCUPIED DWELLINGS OR BUILDINGS TWO THOUSAND FIVE HUNDRED (2,500) SQUARE FEET OR LARGER USED TO HOUSE OR SHELTER DAIRY CATTLE OR POULTRY HUSBANDRY ARE LOCATED WITHIN SIX HUNDRED TWENTY-FIVE (625) FEET OF THE CENTER OF THE WELL PAD.
 2. THIS WELL BORE IS SUBJECT TO THAT 60 FOOT STRIP OF GROUND KNOWN AS THE OLD NORTHWESTERN TURNPIKE.




A / KENNETH MASON ET AL D.B. 202 PG. 610 T.M. 32 PAR. 15 (LOT)
 B / KENNETH MASON ET AL D.B. 202 PG. 610 T.M. 32 PAR. 9 (LOT)
 C / DARRIN G. SHARR ET UX D.B. 273 PG. 434 T.M. 32 PAR. 4 (LOT)
 D / DARRIN SHARR ET UX D.B. 272 PG. 713 T.M. 32 PAR. 16 (LOT)
 E / DARRIN G. SHARR ET UX D.B. 273 PG. 434 T.M. 32 PAR. 15 (LOT)
 F / FRANK KISTNER D.B. 193 PG. 39 T.M. 32 PAR. 22 (LOT)
 G / FRANK KISTNER D.B. 193 PG. 39 T.M. 32 PAR. 21 (LOT)
 H / RICHARD ALLEN SMITH ET AL A.P. 34 PG. 391 T.M. 32 PAR. 25 (LOT)
 I / RICHARD ALLEN SMITH ET AL A.P. 34 PG. 391 T.M. 32 PAR. 47 (LOT)

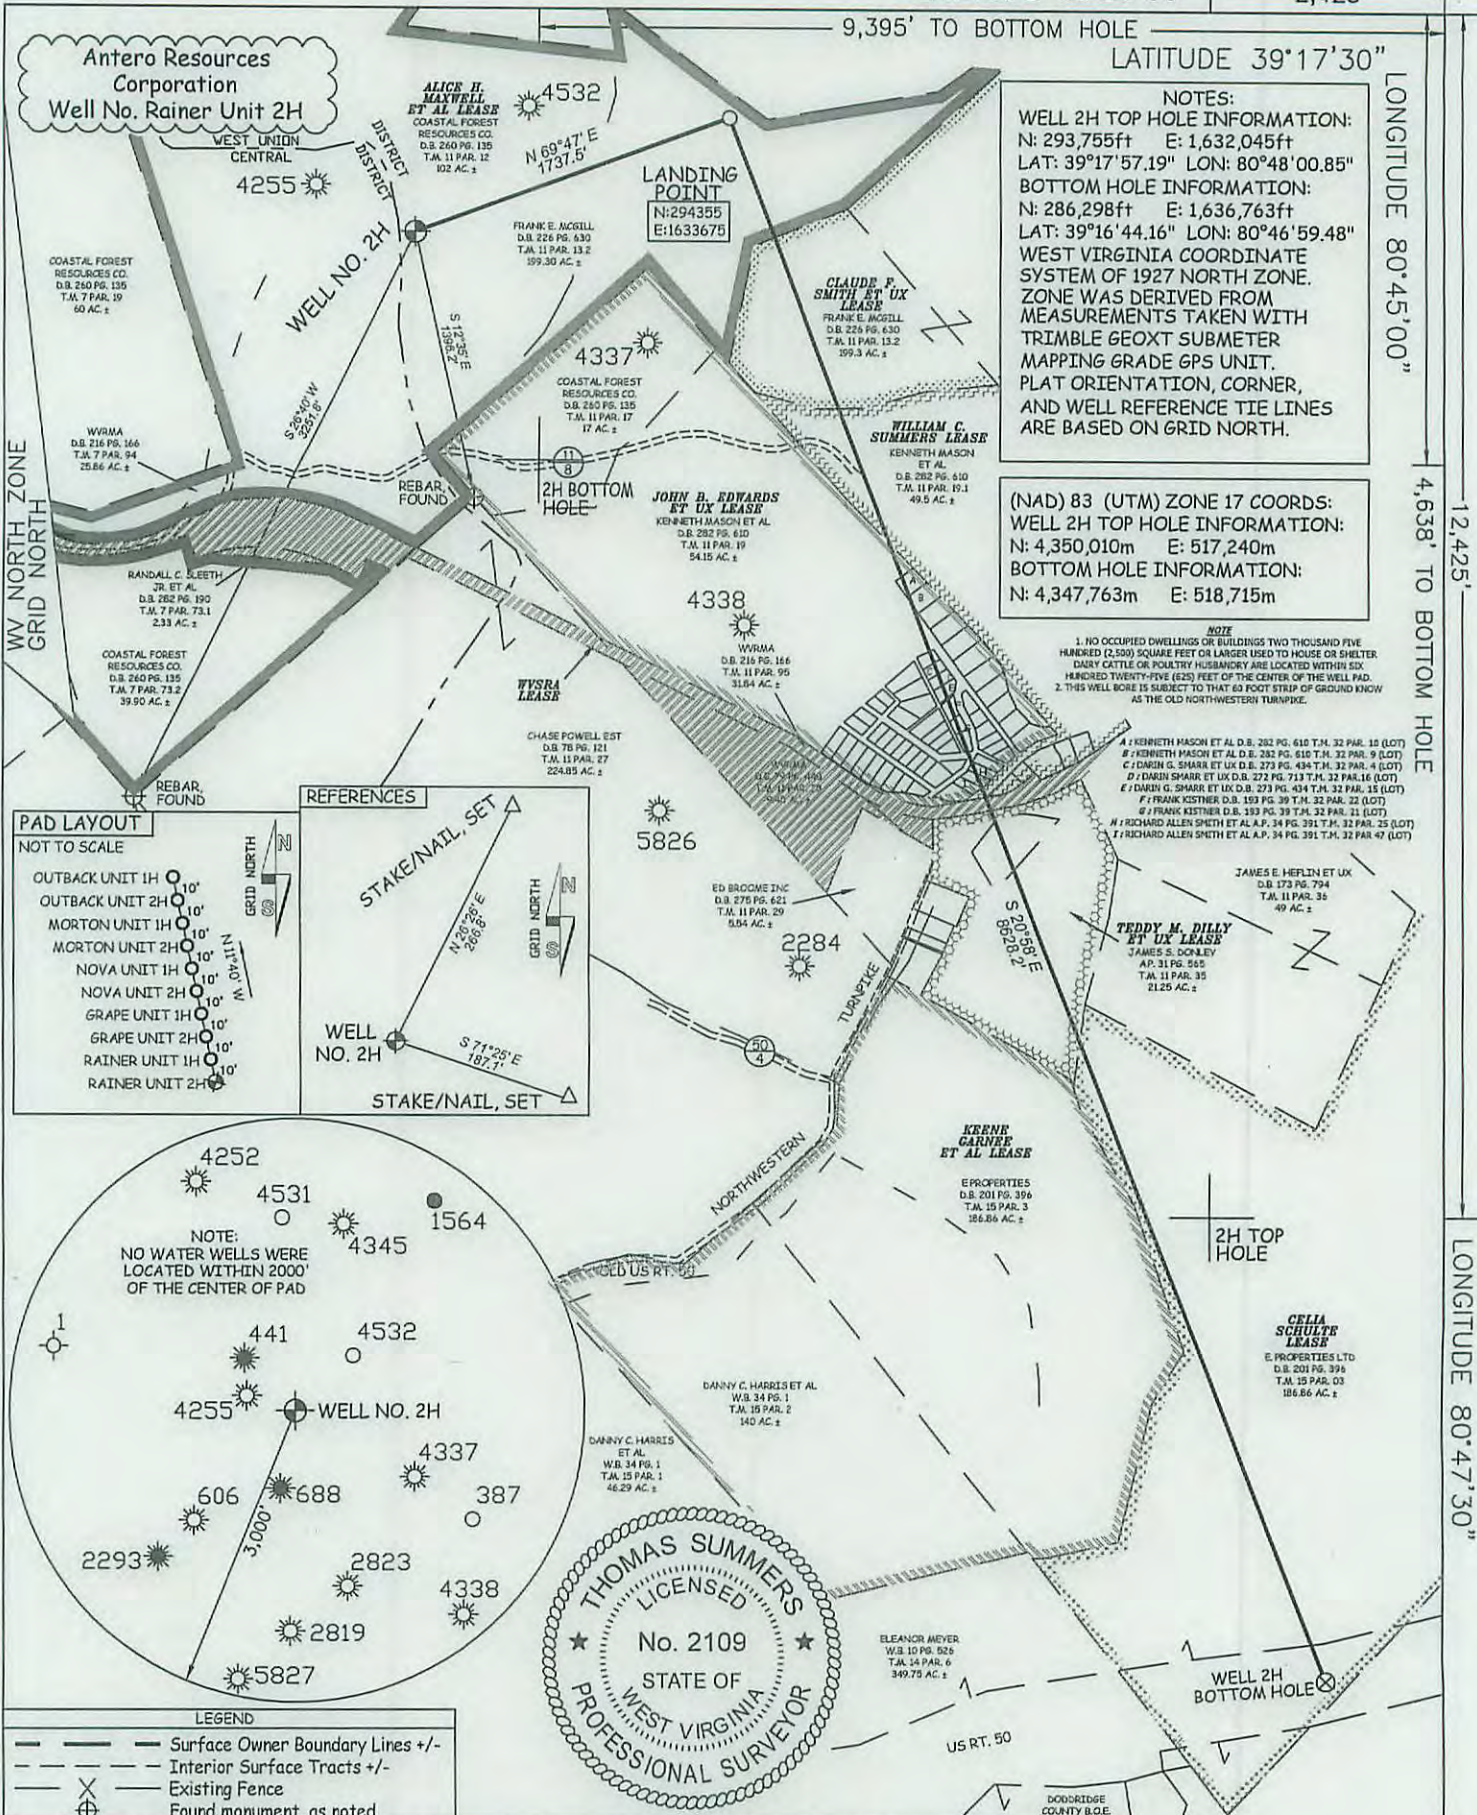

PAD LAYOUT

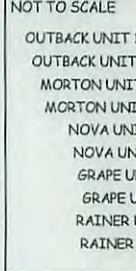

REFERENCES

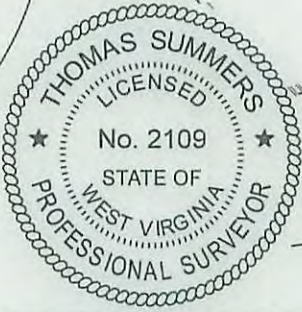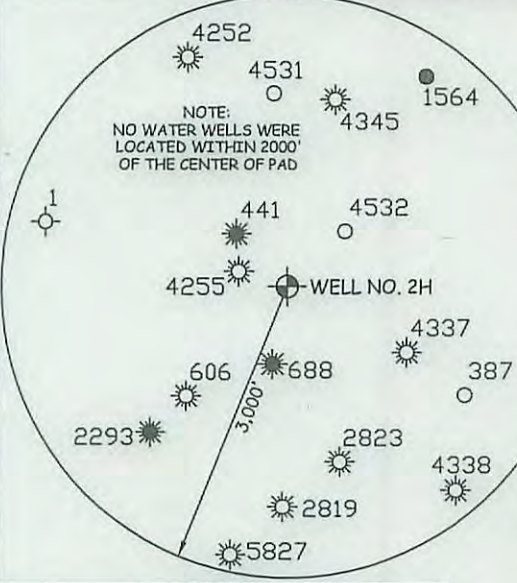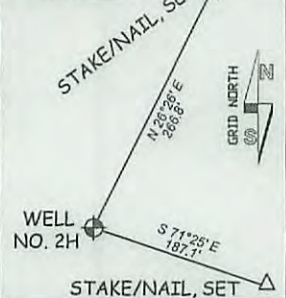

LEGEND

- Surface Owner Boundary Lines +/-
- Interior Surface Tracts +/-
- Existing Fence
- Found monument, as noted

JOB # 15-035WA
 DRAWING # RAINER2H
 SCALE 1" = 1000'
 MINIMUM DEGREE OF ACCURACY SUBMETER
 PROVEN SOURCE OF ELEV. SUBMETER MAPPING GRADE GPS

I, THE UNDERSIGNED, HEREBY CERTIFY THAT THIS PLAT IS CORRECT TO THE BEST OF MY KNOWLEDGE AND BELIEF AND SHOWS ALL THE INFORMATION REQUIRED BY LAW AND THE RULES ISSUED AND PERSCRIBED BY THE DEPARTMENT OF ENVIRONMENTAL PROTECTION.



STATE OF WEST VIRGINIA, DIVISION OF ENVIRONMENTAL PROTECTION, OFFICE OF OIL AND GAS
 WILLOW LAND SURVEYING PLLC
 220 MASONIC AVE. PENNSBORO WEST VIRGINIA 26415

THOMAS SUMMERS P.S. 2109
 DATE 08/14/15
 OPERATOR'S WELL# RAINER2H
 API WELL # 147000017

STATE OF WEST VIRGINIA DEPARTMENT OF ENERGY DIVISION OF OIL AND GAS
 WELL TYPE: OIL ___ GAS X LIQUID INJECTION ___ WASTE DISPOSAL ___
 (IF "GAS") PRODUCTION X STORAGE ___ DEEP ___ SHALLOW X
 LOCATION: ELEVATION 1,221' - ORIGINAL 1,189' - PROPOSED WATERSHED HEADWATERS MIDDLE ISLAND CREEK STATE COUNTY PERMIT
 QUADRANGLE WEST UNION 7.5' DISTRICT WEST UNION COUNTY DODDRIDGE
 SURFACE OWNER COASTAL FOREST RESOURCES COMPANY ACREAGE 102 ACRES +/-
 OIL & GAS ROYALTY OWNER ALICE H. MAXWELL ET AL; CLAUDE F. SMITH ET UX; LEASE ACREAGE 420 AC±; 108 AC±;
 WILLIAM C. SUMMERS; JOHN B. EDWARDS ET UX; WVSRA; TEDDY M. DILLY ET UX; CELIA SCHULTE 49 AC±; 92 AC±; 301.19 AC±; 23 AC±; 200 AC±
 PROPOSED WORK: DRILL X CONVERT ___ DRILL DEEPER ___ REDRILL ___ FRACTURE OR STIMULATE X
 PLUG OFF OLD FORMATION ___ PERFORATE NEW FORMATION X OTHER PHYSICAL CHANGE IN WELL (SPECIFY) ___ PLUG & ABANDON ___ CLEAN OUT & REPLUG
 TARGET FORMATION MARCELLUS ESTIMATED DEPTH 7,900' TVD 17,800' MD
 WELL OPERATOR ANTERO RESOURCES CORP. DESIGNATED AGENT DIANNA STAMPER - GT CORPORATION SYSTEM
 ADDRESS 1615 WYNKOOP STREET ADDRESS 5400 D BIG TYLER ROAD
 DENVER, CO 80202 CHARLESTON, WV 25313

LATITUDE 39°20'00"

2,425'

9,395' TO BOTTOM HOLE


LATITUDE 39°17'30"

LONGITUDE 80°45'00"

12,425'

4,638' TO BOTTOM HOLE




LONGITUDE 80°47'30"

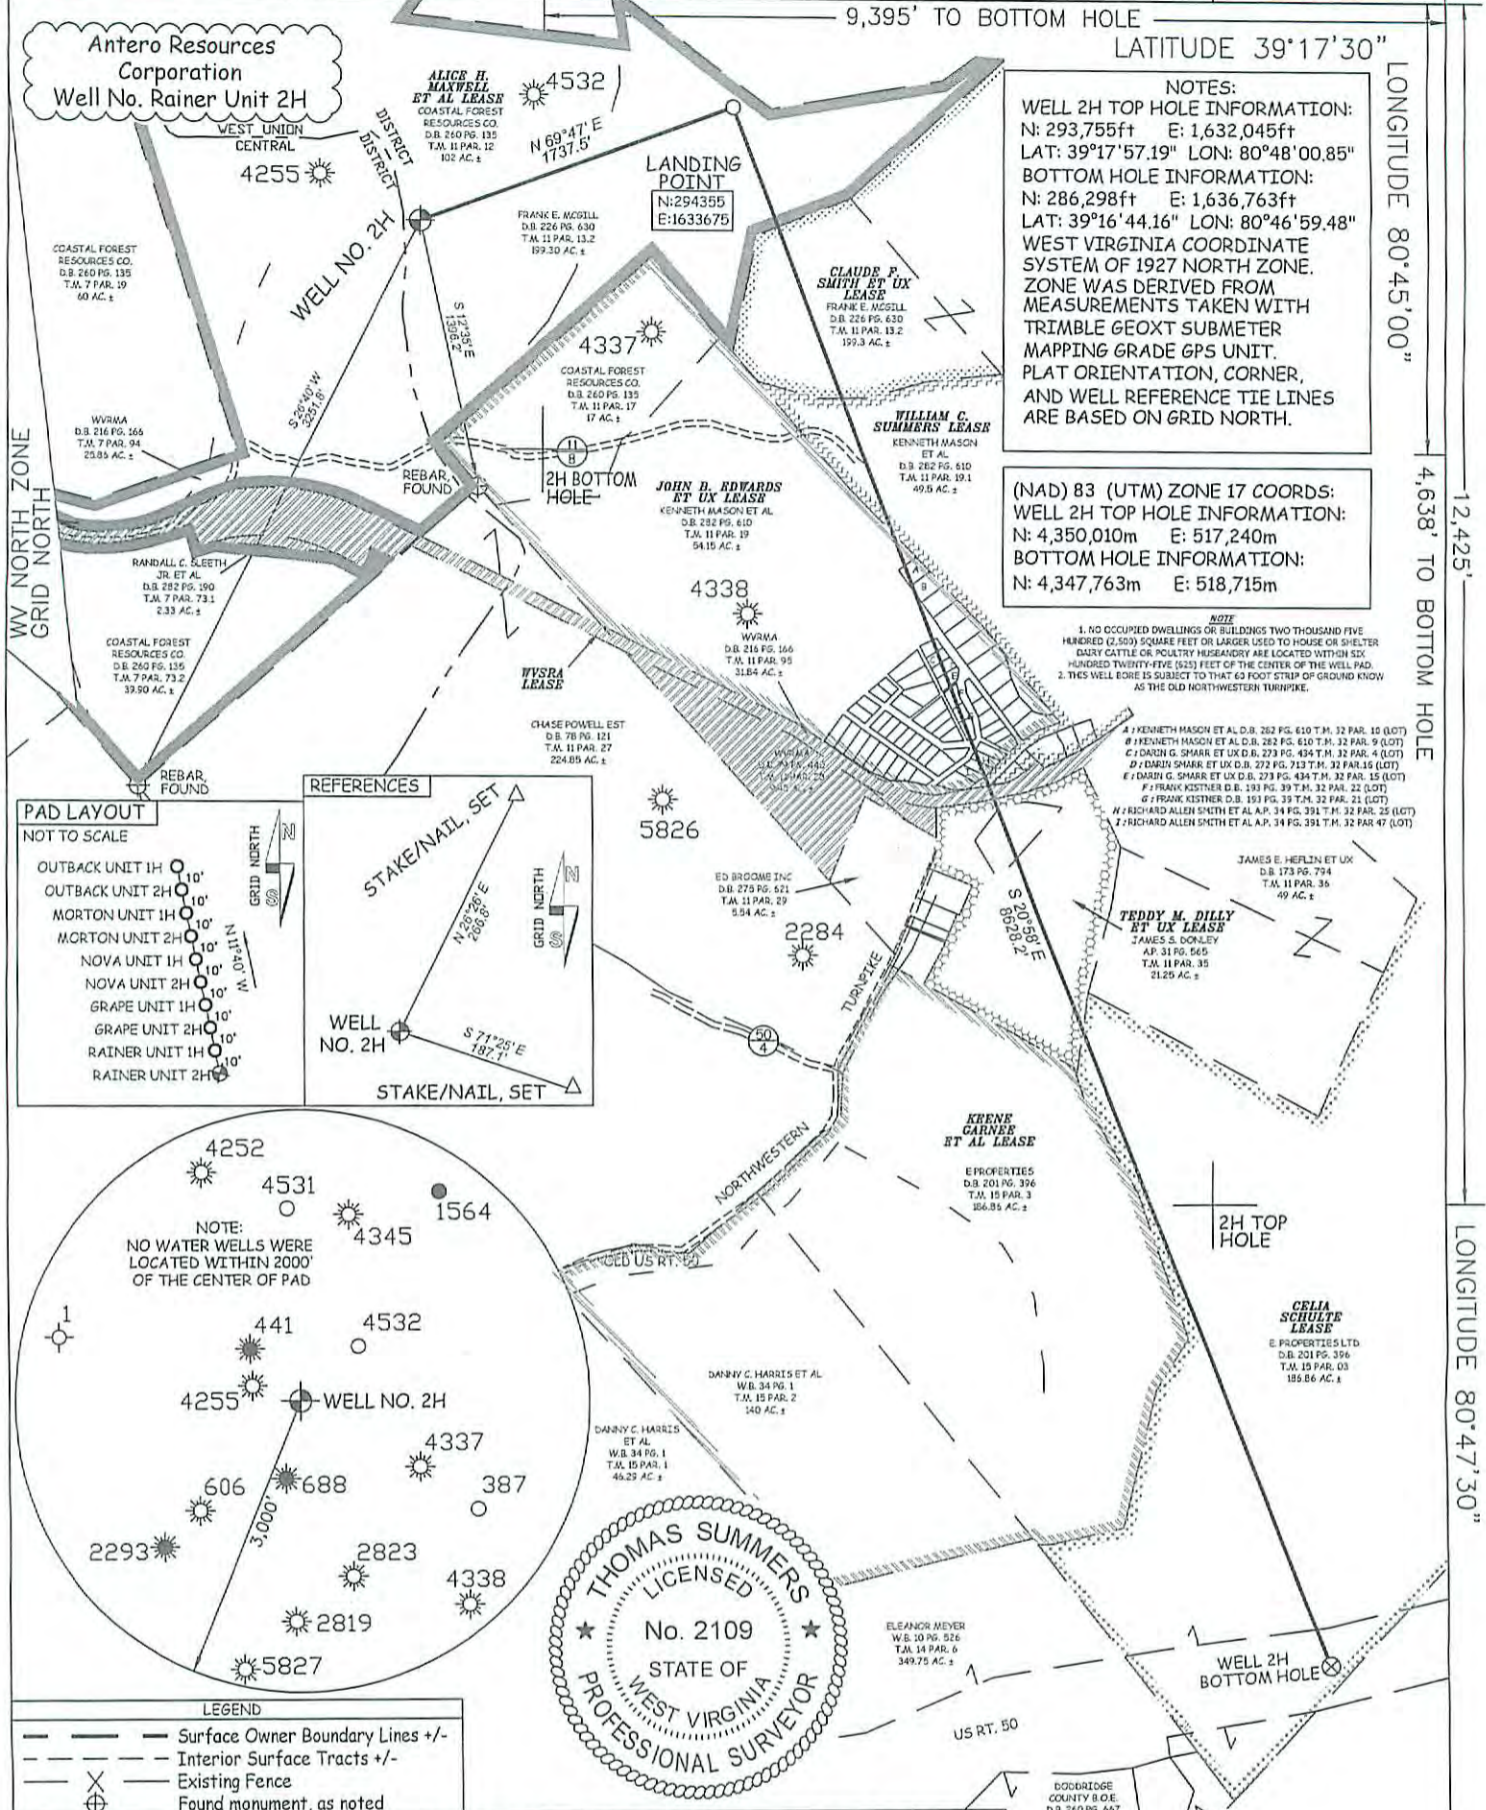

NOTES:
 WELL 2H TOP HOLE INFORMATION:
 N: 293,755ft E: 1,632,045ft
 LAT: 39°17'57.19" LON: 80°48'00.85"
 BOTTOM HOLE INFORMATION:
 N: 286,298ft E: 1,636,763ft
 LAT: 39°16'44.16" LON: 80°46'59.48"
 WEST VIRGINIA COORDINATE SYSTEM OF 1927 NORTH ZONE. ZONE WAS DERIVED FROM MEASUREMENTS TAKEN WITH TRIMBLE GEOXT SUBMETER MAPPING GRADE GPS UNIT. PLAT ORIENTATION, CORNER, AND WELL REFERENCE TIE LINES ARE BASED ON GRID NORTH.

(NAD) 83 (UTM) ZONE 17 COORDS:
 WELL 2H TOP HOLE INFORMATION:
 N: 4,350,010m E: 517,240m
 BOTTOM HOLE INFORMATION:
 N: 4,347,763m E: 518,715m

- NOTE
- NO OCCUPIED DWELLINGS OR BUILDINGS TWO THOUSAND FIVE HUNDRED (2,500) SQUARE FEET OR LARGER USED TO HOUSE OR SHELTER CATTLE OR POULTRY HUSBANDRY ARE LOCATED WITHIN SIX HUNDRED TWENTY FIVE (625) FEET OF THE CENTER OF THE WELL PAD.
 - THIS WELL BORE IS SUBJECT TO THAT 60 FOOT STRIP OF GROUND KNOWN AS THE OLD NORTHWESTERN TURNPIKE.
- A: KENNETH MASON ET AL D.B. 282 PG. 610 T.M. 32 PAR. 10 (LOT)
 - B: KENNETH MASON ET AL D.B. 282 PG. 610 T.M. 32 PAR. 9 (LOT)
 - C: DARRIN G. SMARR ET UX D.B. 273 PG. 434 T.M. 32 PAR. 4 (LOT)
 - D: DARRIN G. SMARR ET UX D.B. 273 PG. 434 T.M. 32 PAR. 15 (LOT)
 - E: DARRIN G. SMARR ET UX D.B. 273 PG. 434 T.M. 32 PAR. 15 (LOT)
 - F: FRANK KISTNER D.B. 193 PG. 39 T.M. 32 PAR. 22 (LOT)
 - G: FRANK KISTNER D.B. 193 PG. 39 T.M. 32 PAR. 21 (LOT)
 - H: RICHARD ALLEN SMITH ET AL A.P. 34 PG. 391 T.M. 32 PAR. 25 (LOT)
 - I: RICHARD ALLEN SMITH ET AL A.P. 34 PG. 391 T.M. 32 PAR. 47 (LOT)

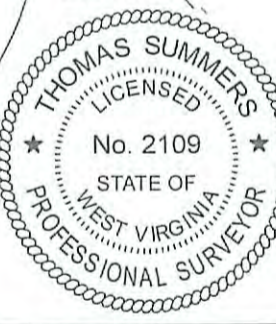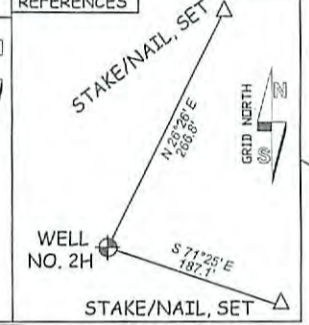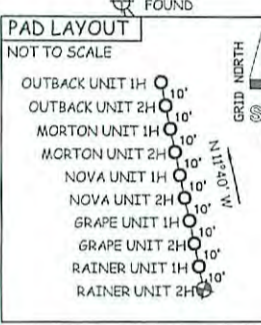

LEGEND

---	Surface Owner Boundary Lines +/-
- - -	Interior Surface Tracts +/-
- - - X	Existing Fence
⊕	Found monument, as noted

JOB # 15-035WA
 DRAWING # RAINIER2H
 SCALE 1" = 1000'
 MINIMUM DEGREE OF ACCURACY SUBMETER
 PROVEN SOURCE OF ELEV. SUBMETER MAPPING GRADE GPS

I THE UNDERSIGNED, HEREBY CERTIFY THAT THIS PLAT IS CORRECT TO THE BEST OF MY KNOWLEDGE AND BELIEF AND SHOWS ALL THE INFORMATION REQUIRED BY LAW AND THE RULES ISSUED AND PERSCRIBED BY THE DEPARTMENT OF ENVIRONMENTAL PROTECTION.



STATE OF WEST VIRGINIA, DIVISION OF ENVIRONMENTAL PROTECTION, OFFICE OF OIL AND GAS

WILLOW LAND SURVEYING PLLC
 220 MASONIC AVE. PENNSBORO WEST VIRGINIA 26415

THOMAS SUMMERS P.S. 2109
 DATE 08/14/15

STATE OF WEST VIRGINIA DEPARTMENT OF ENERGY DIVISION OF OIL AND GAS

WELL TYPE: OIL GAS LIQUID INJECTION WASTE DISPOSAL
 (IF "GAS") PRODUCTION STORAGE DEEP SHALLOW

LOCATION: ELEVATION 1,221' - ORIGINAL 1,189' - PROPOSED WATERSHED HEADWATERS MIDDLE ISLAND CREEK STATE COUNTY 01/29/2016
 QUADRANGLE WEST UNION 7.5' DISTRICT WEST UNION COUNTY DODDRIDGE

SURFACE OWNER COASTAL FOREST RESOURCES COMPANY ACREAGE 102 ACRES +/-
 OIL & GAS ROYALTY OWNER ALICE H. MAXWELL ET AL; CLAUDE F. SMITH ET UX; LEASE ACREAGE 420 AC±; 108 AC±;
 WILLIAM C. SUMMERS; JOHN B. EDWARDS ET UX; WVSRA; TEDDY M. DILLY ET UX; CELIA SCHULTE 49 AC±; 92 AC±; 301.49 AC±; 23 AC±; 200 AC±

PROPOSED WORK: DRILL CONVERT DRILL DEEPER REDRILL FRACTURE OR STIMULATE
 PLUG OFF OLD FORMATION PERFORATE NEW FORMATION OTHER PHYSICAL CHANGE IN WELL (SPECIFY) _____ PLUG & ABANDON _____ CLEAN OUT & REPLUG _____

TARGET FORMATION MARCELLUS ESTIMATED DEPTH 7,900' TVD -17,800' MD
 WELL OPERATOR ANTERO RESOURCES CORP. DESIGNATED AGENT DIANNA STAMPER - CT CORPORATION SYSTEM
 ADDRESS 1615 WYNKOOP STREET ADDRESS 5400 D BIG TYLER ROAD
 DENVER, CO 80202 CHARLESTON, WV 25313

INFORMATION SUPPLIED UNDER WEST VIRGINIA CODE
Chapter 22, Article 6A, Section 5(a)(5)
IN LIEU OF FILING LEASE(S) AND OTHER CONTINUING CONTRACT(S)

Under the oath required to make the verification on page 1 of this Notice and Application, I depose and say that I am the person who signed the Notice and Application for the Applicant, and that –


(1) the tract of land is the same tract described in this Application, partly or wholly depicted in the accompanying plat, and described in the Construction and Reclamation Plan;

(2) the parties and recordation data (if recorded) for lease(s) or other continuing contract(s) by which the Applicant claims the right to extract, produce or market the oil or gas are as follows:

Grantor, lessor, etc.	Grantee, lessee, etc.	Royalty	Book/Page
Alice H. Maxwell, et al Lease			
Alice H. Maxwell	Carl D. Perkins	1/8	0063/0111
Carl D. Perkins	Justin L. Henderson	Assignment	0104/0689
Justin Henderson	P.D. Farr, II	Assignment	0109/0385
P.D. Farr, II	Antero Resources Appalachian Corporation	*Partial Assignment of Oil & Gas Leases	0271/0546
Antero Resources Appalachian Corporation	Antero Resources Corporation	Name Change	Exhibit 1
Claude F. Smith, et ux Lease			
Claude L. Smith, et al	Key Oil Company	1/8	0104/0448
Key Oil Company	1978 XOIL Drilling Partners	Assignment	0104/0541
1978 XOIL Drilling Partners	XPLOR Corporation	Assignment	0146/0649
XPLOR Corporation	Venus Exploration, Inc.	Name Change	Exhibit 4
Venus Exploration, Inc.	Allegheny Interest, Inc.	Assignment of Oil & Gas Leases	0184/0512
Allegheny Interest, Inc.	Rubin Resources, Inc.	Assignment of Oil & Gas Leases	0187/0685
Rubin Resources, Inc.	PetroEdge Energy, LLC	Conveyance	0230/0666
PetroEdge Energy, LLC	Statoil USA Onshore Properties, Inc.	Assignment, Bill of Sale & Conveyance	0285/0071
Statoil USA Onshore Properties, Inc.	Antero Resources Corporation	Notice of Agreement	0365/0450
John B. Edwards, et ux Lease			
John B. Edwards, et ux	Trio Petroleum Corporation	1/8	0179/0049
Trio Petroleum Corporation	Waco Holding Co.	Merger	Exhibit 2
Waco Holding Co.	Waco Oil & Gas Co.	Name Change	Exhibit 3
Waco Oil & Gas Co.	Linn Energy, LLC	Assignment	0195/0541
Linn Energy, LLC	Linn Energy Holdings, LLC	Assignment	0262/0483
Linn Energy Holdings, LLC	XTO Energy, Inc.	Assignment	0224/0155
XTO Energy, Inc.	Antero Resources Corporation	Assignment	0329/0609
William G. Summers, et al Lease			
William G. Summers, et al	Clarence W. Mutschelknaus	1/8	0130/0601
Clarence W. Mutschelknaus	Bluestone Energy Partners	Assignment	0245/0577
Bluestone Energy Partners	Antero Resources Bluestone, LLC, a wholly owned subsidiary of Antero Resources Appalachian Corporation	Affidavit Regarding Merger	DB 0288/0001
Antero Resources Appalachian Corporation	Antero Resources Corporation	Name Change	Exhibit 1
WVSRA Lease			
West Virginia State Rail Authority	Antero Resources Appalachian Corporation	1/8	0253/0409
Antero Resources Appalachian Corporation	Antero Resources Corporation	Name Change	Exhibit 1

*Partial Assignments to Antero Resources Corporation include 100% rights to extract, produce and market the oil and gas from the Marcellus and any other formations completed with this well.

01/29/2016

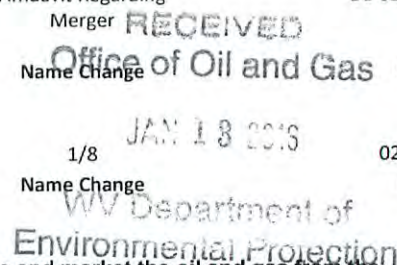

INFORMATION SUPPLIED UNDER WEST VIRGINIA CODE
 Chapter 22, Article 6A, Section 5(a)(5)
 IN LIEU OF FILING LEASE(S) AND OTHER CONTINUING CONTRACT(S)

Under the oath required to make the verification on page 1 of this Notice and Application, I depose and say that I am the person who signed the Notice and Application for the Applicant, and that –

- (1) the tract of land is the same tract described in this Application, partly or wholly depicted in the accompanying plat, and described in the Construction and Reclamation Plan;
- (2) the parties and recordation data (if recorded) for lease(s) or other continuing contract(s) by which the Applicant claims the right to extract, produce or market the oil or gas are as follows:

Grantor, lessor, etc.	Grantee, lessee, etc.	Royalty	Book/Page
Teddy M. Dilly, et ux Lease			
Teddy M. & Wanda L. Dilly	Key Oil Company	1/8	0178/0649
Key Oil Company	Antero Resources Appalachian Corporation	*Partial Assignment of Oil & Gas Leases	0276/0526
Antero Resources Appalachian Corporation	Antero Resources Corporation	Name Change	Exhibit 1
Keene Garnee, et al Lease			
Keene Garnee, et al	Key Oil Company	1/8	0104/0293
Key Oil Company	J & J Enterprises, Inc.	Assignment	0111/0326
J & J Enterprises	Eastern American Energy Corporation	Confirmatory Deed & Assignment	0211/0137
Eastern American Energy Corporation	Eastern Corporation of America	Confirmatory Deed & Assignment	0240/0498
Eastern Corporation of America	Antero Resources Appalachian Corporation	*Partial Assignment of Oil & Gas Leases	0272/0307
Antero Resources Appalachian Corporation	Antero Resources Corporation	Name Change	Exhibit 1

RECEIVED
 Office of Oil and Gas

JAN 13 2016

*Partial Assignments to Antero Resources Corporation include 100% rights to extract, produce and market the oil and gas from the Marcellus and any other formations completed with this well.

WV Department of

Environmental Protection
 CONTINUED ON NEXT PAGE 01/29/2016

**INFORMATION SUPPLIED UNDER WEST VIRGINIA CODE
Chapter 22, Article 6A, Section 5(a)(5)
IN LIEU OF FILING LEASE(S) AND OTHER CONTINUING CONTRACT(S)**

Under the oath required to make the verification on page 1 of this Notice and Application, I depose and say that I am the person who signed the Notice and Application for the Applicant, and that –

- (1) the tract of land is the same tract described in this Application, partly or wholly depicted in the accompanying plat, and described in the Construction and Reclamation Plan;
- (2) the parties and recordation data (if recorded) for lease(s) or other continuing contract(s) by which the Applicant claims the right to extract, produce or market the oil or gas are as follows:

Lease Name or Number	Grantor, Lessor, etc.	Grantee, Lessee, etc.	Royalty	Book/Page
Celia Schulte Lease	Celia Schulte	P. Douglass Farr	1/8	0062/0485
	P. Douglass Farr	Triangle Oil Company	Assignment	0069/0125
	Triangle Oil Company	New Triangle Oil Company	Assignment	0149/0174
	New Triangle Oil Company	Professional Oilfield Services, Inc.	Farmount Agreement	0336/0456
	Professional Oilfield Services, Inc.	Antero Resources Corporation	*Partial Assignment of Oil & Gas Leases	0336/0461

*Partial Assignments to Antero Resources Corporation include 100% rights to extract, produce and market the oil and gas from the Marcellus and any other formations completed with this well.

**Acknowledgement of Possible Permitting/Approval
In Addition to the Office of Oil and Gas**

The permit applicant for the proposed well work addressed in this application hereby acknowledges the possibility of the need for permits and/or approvals from local, state, or federal entities in addition to the DEP, Office of Oil and Gas, including but not limited to the following:

- WV Division of Water and Waste Management
- WV Division of Natural Resources WV Division of Highways
- U.S. Army Corps of Engineers
- U.S. Fish and Wildlife Service
- County Floodplain Coordinator

The applicant further acknowledges that any Office of Oil and Gas permit in no way overrides, replaces, or nullifies the need for other permits/approvals that may be necessary and further affirms that all needed permits/approvals should be acquired from the appropriate authority before the affected activity is initiated.

Well Operator: Antero Resources Corporation
 By: Ward McNeilly
 Its: VP - Reserves Planning & Midstream

JAN 13 2016

FORM WW-6A1
EXHIBIT 1

FILED

JUN 10 2013

Natalie E. Tennant
Secretary of State
1900 Kanawha Blvd E
Bldg 1, Suite 157-K
Charleston, WV 25305



Penney Barker, Manager
Corporations Division
Tel: (304)558-8000
Fax: (304)558-8381
Website: www.wvso.com
E-mail: business@wvso.com

APPLICATION FOR
AMENDED CERTIFICATE
OF AUTHORITY

Office Hours: Monday - Friday
8:30 a.m. - 5:00 p.m. ET

FILE ONE ORIGINAL
(Two if you want a filed
stamped copy returned to you)
FEE: \$25.00

**** In accordance with the provisions of the West Virginia Code, the undersigned corporation hereby ****
applies for an Amended Certificate of Authority and submits the following statement:

- Name under which the corporation was authorized to transact business in WV: Antero Resources Appalachian Corporation
- Date Certificate of Authority was issued in West Virginia: 6/25/2008
- Corporate name has been changed to: Antero Resources Corporation
(Attach one Certified Copy of Name Change as filed in home State of Incorporation.)
- Name the corporation elects to use in WV: Antero Resources Corporation
(due to home state name not being available)
- Other amendments: _____
(attach additional pages if necessary)
- Name and phone number of contact person. (This is optional, however, if there is a problem with the filing, listing a contact person and phone number may avoid having to return or reject the document.)
Alvyn A. Schopp (303) 367-7310
Contact Name Phone Number
- Signature information (See below *Important Legal Notice Regarding Signature):
Print Name of Signer: Alvyn A. Schopp Title/Capacity: Authorized Person
Signature: [Handwritten Signature] Date: June 10, 2013

**Important Legal Notice Regarding Signature:* Per West Virginia Code §311-1-129. Penalty for signing false document. Any person who signs a document he or she knows is false in any material respect and knows that the document is to be delivered to the secretary of state for filing is guilty of a misdemeanor and, upon conviction thereof, shall be fined not more than one thousand dollars or confined in the county or regional jail not more than one year, or both.

Form CF-4

Issued by the Office of the Secretary of State

RECEIVED
Office of Oil and Gas

JAN 13 2016

State of West Virginia




Certificate

*I, Joe Manchin III, Secretary of State of the
State of West Virginia, hereby certify that*

by the provisions of Chapter 31 of the West Virginia Code, Articles of Merger were received and filed
MERCING TRIO PETROLEUM CORP., A QUALIFIED WV ORGANIZATION, WITH AND INTO WACO HOLDING COMPANY,
A QUALIFIED WV ORGANIZATION.

Therefore, I hereby issue this

CERTIFICATE OF MERGER

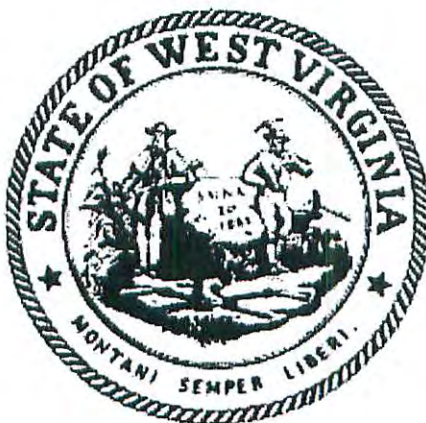

*Given under my hand and the
Great Seal of the State of
West Virginia on this day of
October 26, 2001*

A handwritten signature in black ink, appearing to read "Joe Manchin III".

Secretary of State

MO

State of West Virginia




Certificate

*I, Joe Manchin III, Secretary of State of the
State of West Virginia, hereby certify that*

by the provisions of Chapter 31 of the West Virginia Code, Articles of Merger were received and filed
MERGING **WACO HOLDING COMPANY**, A QUALIFIED WV ORGANIZATION, WITH AND INTO **WACO OIL & GAS CO.,
INC.**, A QUALIFIED WV ORGANIZATION.


Therefore, I hereby issue this

CERTIFICATE OF MERGER

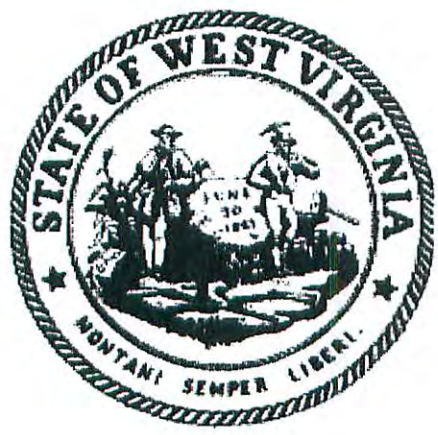

*Given under my hand and the
Great Seal of the State of
West Virginia on this day of*

October 29, 2001
RECEIVED
Office of Oil and Gas

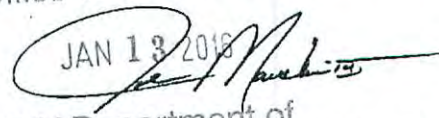JAN 13 2018

WV Department of
Environmental Protection *Secretary of State*

01/29/2016

State of West Virginia



Certificate

*I, Hon Hechler, Secretary of State of the
State of West Virginia, hereby certify that*

the following and attached is a true and exact copy of the articles of merger of **VENUS EXPLORATION, INC.** a non-qualified Delaware corporation and **XPLOR CORPORATION** a qualified Delaware corporation.

Therefore I hereby issue this CERTIFICATE OF MERGER, merging VENUS EXPLORATION, INC. with and into XPLOR CORPORATION, the survivor which then changed its name to VENUS EXPLORATION, INC.



*Given under my hand and the
Great Seal of the State of
West Virginia on this
Eighteenth day of
July 19 97*
Kar Hechler
Secretary of State

RECEIVED

01/29/2016



November 12, 2015

Antero Resources
1615 Wynkoop Street
Denver, CO 80202
Office 303.357.7310
Fax 303.357.7315

West Virginia Department of Environmental Protection
Chief, Office of Oil and Gas
Attn: Mr. James Martin
601 57th Street SE
Charleston, WV 25304

RE: Rainer Unit 2H
Quadrangle: West Union 7.5'
Doddridge County/West Union District, West Virginia

Mr. Martin:

Antero Resources Corporation (Antero) is submitting the following application for a new well work permit for the Rainer Unit 2H horizontal shallow well. As an authorized representative, I certify that Antero has the right to extract, produce or market the oil or gas for all leases through which the Rainer Unit 2H horizontal lateral will drill through including any and all roads crossed under as identified on the attached survey plat.

Sincerely,

A handwritten signature in blue ink, appearing to read "Thomas Kuhn", with a long horizontal line extending to the right.

Thomas Kuhn
Landman

470970077-

RECEIVED
Office of Oil and Gas
NOV 13 2015
WV Department of
Environmental Protection

01/29/2016

STATE OF WEST VIRGINIA
DEPARTMENT OF ENVIRONMENTAL PROTECTION, OFFICE OF OIL AND GAS
NOTICE CERTIFICATION

Date of Notice Certification: 11/11/2015

API No. 47- 017 - _____

Operator's Well No. Rainer Unit 2H

Well Pad Name: Color Pad

Notice has been given:

Pursuant to the provisions in West Virginia Code § 22-6A, the Operator has provided the required parties with the Notice Forms listed below for the tract of land as follows:

State: West Virginia
County: Doddridge
District: West Union
Quadrangle: West Union 7.5'
Watershed: Headwaters Middle Island Creek

UTM NAD 83 Easting: 517240m
Northing: 4350010m
Public Road Access: CR 11/3
Generally used farm name: Coastal Forest Resources Company

Pursuant to West Virginia Code § 22-6A-7(b), every permit application filed under this section shall be on a form as may be prescribed by the secretary, shall be verified and shall contain the following information: (14) A certification from the operator that (i) it has provided the owners of the surface described in subdivisions (1), (2) and (4), subsection (b), section ten of this article, the information required by subsections (b) and (c), section sixteen of this article; (ii) that the requirement was deemed satisfied as a result of giving the surface owner notice of entry to survey pursuant to subsection (a), section ten of this article six-a; or (iii) the notice requirements of subsection (b), section sixteen of this article were waived in writing by the surface owner; and Pursuant to West Virginia Code § 22-6A-11(b), the applicant shall tender proof of and certify to the secretary that the notice requirements of section ten of this article have been completed by the applicant.

Pursuant to West Virginia Code § 22-6A, the Operator has attached proof to this Notice Certification that the Operator has properly served the required parties with the following:

*PLEASE CHECK ALL THAT APPLY

- 1. NOTICE OF SEISMIC ACTIVITY or NOTICE NOT REQUIRED BECAUSE NO SEISMIC ACTIVITY WAS CONDUCTED
- 2. NOTICE OF ENTRY FOR PLAT SURVEY or NO PLAT SURVEY WAS CONDUCTED
- 3. NOTICE OF INTENT TO DRILL or NOTICE NOT REQUIRED BECAUSE NOTICE OF ENTRY FOR PLAT SURVEY WAS CONDUCTED or
 WRITTEN WAIVER BY SURFACE OWNER (PLEASE ATTACH)
- 4. NOTICE OF PLANNED OPERATION
- 5. PUBLIC NOTICE
- 6. NOTICE OF APPLICATION

OOG OFFICE USE ONLY

- RECEIVED/
NOT REQUIRED
- RECEIVED
- RECEIVED/
NOT REQUIRED
- RECEIVED
- RECEIVED
- RECEIVED


Required Attachments:


The Operator shall attach to this Notice Certification Form all Notice Forms and Certifications of Notice that have been provided to the required parties and/or any associated written waivers. For the Public Notice, the operator shall attach a copy of the Class II Legal Advertisement with publication date verification or the associated Affidavit of Publication. The attached Notice Forms and Certifications of Notice shall serve as proof that the required parties have been noticed as required under West Virginia Code § 22-6A. Pursuant to West Virginia Code § 22-6A-11(b), the Certification of Notice to the person may be made by affidavit of personal service, the return receipt card or other postal receipt for certified mailing.


Office of Oil and Gas
NOV 13 2015
WV Department of
Environmental Protection
01/29/2016

Certification of Notice is hereby given:

THEREFORE, I Kevin Kilstrom, have read and understand the notice requirements within West Virginia Code § 22-6A. I certify that as required under West Virginia Code § 22-6A, I have served the attached copies of the Notice Forms, identified above, to the required parties through personal service, by registered mail or by any method of delivery that requires a receipt or signature confirmation. I certify under penalty of law that I have personally examined and am familiar with the information submitted in this Notice Certification and all attachments, and that based on my inquiry of those individuals immediately responsible for obtaining the information, I believe that the information is true, accurate and complete. I am aware that there are significant penalties for submitting false information, including the possibility of fine and imprisonment.

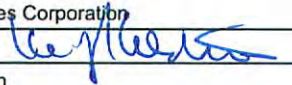Well Operator:	<u>Antero Resources Corporation</u>	Address:	<u>1615 Wynkoop Street</u>
By:	<u>Kevin Kilstrom</u> 		<u>Denver, CO 80202</u>
Its:	<u>VP of Production</u>	Facsimile:	<u>303-357-7315</u>
Telephone:	<u>(303) 357-7310</u>	Email:	<u>asteele@anteroresources.com</u>

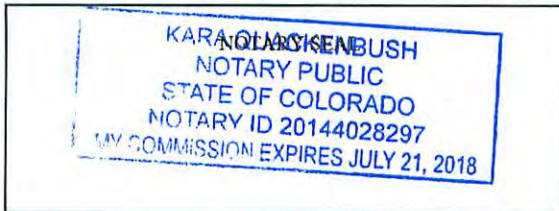

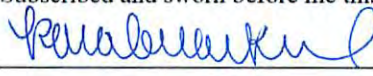Subscribed and sworn before me this 11 day of November 2015

 _____ Notary Public
 My Commission Expires July 21, 2018

Oil and Gas Privacy Notice:

The Office of Oil and Gas processes your personal information, such as name, address and telephone number, as part of our regulatory duties. Your personal information may be disclosed to other State agencies or third parties in the normal course of business or as needed to comply with statutory or regulatory requirements, including Freedom of Information Act requests. Our office will appropriately secure your personal information. If you have any questions about our use or your personal information, please contact DEP's Chief Privacy Officer at deprivacyofficer@wv.gov.

4701706763

RECEIVED
 Office of Oil and Gas
 NOV 13 2015
 WV Department of
 Environmental Protection
 01/29/2016

**STATE OF WEST VIRGINIA
DEPARTMENT OF ENVIRONMENTAL PROTECTION, OFFICE OF OIL AND GAS
NOTICE OF APPLICATION**

Notice Time Requirement: notice shall be provided no later than the **filing date of permit application.**

Date of Notice: 11/12/2015 **Date Permit Application Filed:** 11/12/2015

Notice of:

- PERMIT FOR ANY WELL WORK
- CERTIFICATE OF APPROVAL FOR THE CONSTRUCTION OF AN IMPOUNDMENT OR PIT

Delivery method pursuant to West Virginia Code § 22-6A-10(b)

- PERSONAL SERVICE
- REGISTERED MAIL
- METHOD OF DELIVERY THAT REQUIRES A RECEIPT OR SIGNATURE CONFIRMATION

Pursuant to W. Va. Code § 22-6A-10(b) no later than the filing date of the application, the applicant for a permit for any well work or for a certificate of approval for the construction of an impoundment or pit as required by this article shall deliver, by personal service or by registered mail or by any method of delivery that requires a receipt or signature confirmation, copies of the application, the erosion and sediment control plan required by section seven of this article, and the well plat to each of the following persons: (1) The owners of record of the surface of the tract on which the well is or is proposed to be located; (2) The owners of record of the surface tract or tracts overlying the oil and gas leasehold being developed by the proposed well work, if the surface tract is to be used for roads or other land disturbance as described in the erosion and sediment control plan submitted pursuant to subsection (c), section seven of this article; (3) The coal owner, operator or lessee, in the event the tract of land on which the well proposed to be drilled is located [sic] is known to be underlain by one or more coal seams; (4) The owners of record of the surface tract or tracts overlying the oil and gas leasehold being developed by the proposed well work, if the surface tract is to be used for the placement, construction, enlargement, alteration, repair, removal or abandonment of any impoundment or pit as described in section nine of this article; (5) Any surface owner or water purveyor who is known to the applicant to have a water well, spring or water supply source located within one thousand five hundred feet of the center of the well pad which is used to provide water for consumption by humans or domestic animals; and (6) The operator of any natural gas storage field within which the proposed well work activity is to take place. (c)(1) If more than three tenants in common or other co-owners of interests described in subsection (b) of this section hold interests in the lands, the applicant may serve the documents required upon the person described in the records of the sheriff required to be maintained pursuant to section eight, article one, chapter eleven-a of this code. (2) Notwithstanding any provision of this article to the contrary, notice to a lien holder is not notice to a landowner, unless the lien holder is the landowner. W. Va. Code R. § 35-8-5.7.a requires, in part, that the operator shall also provide the Well Site Safety Plan ("WSSP") to the surface owner and any water purveyor or surface owner subject to notice and water testing as provided in section 15 of this rule.

Application Notice WSSP Notice E&S Plan Notice Well Plat Notice is hereby provided to:

SURFACE OWNER(s)
Name: PLEASE SEE ATTACHMENT
Address: _____

Name: _____
Address: _____

SURFACE OWNER(s) (Road and/or Other Disturbance)
Name: _____
Address: _____

Name: _____
Address: _____

SURFACE OWNER(s) (Impoundments or Pits)
Name: _____
Address: _____

COAL OWNER OR LESSEE
Name: NO DECLARATIONS ON RECORD WITH COUNTY
Address: _____

COAL OPERATOR
Name: 470-706703
Address: _____

WATER PURVEYOR(s)/OWNER(s) OF WATER WELL, SPRING OR OTHER WATER SUPPLY SOURCE
Name: NONE IDENTIFIED WITHIN 1500'
Address: _____

OPERATOR OF ANY NATURAL GAS STORAGE FIELD
Name: _____
Address: _____

*Please attach additional forms if necessary

RECEIVED
Office of Oil and Gas
NOV 13 2015
WV Department of Environmental Protection
01/29/2016

Notice is hereby given:

Pursuant to West Virginia Code § 22-6A-10(b), notice is hereby given that the undersigned well operator has applied for a permit for well work or for a certificate of approval for the construction of an impoundment or pit.

This Notice Shall Include:

Pursuant to W. Va. Code § 22-6A-10(b), this notice shall include: (1) copies of the application; (2) the erosion and sediment control plan required by section seven of this article; and (3) the well plat.

Pursuant to W. Va. Code § 22-6A-10(f), this notice shall include: (1) a statement of the time limits for filing written comments; (2) who may file written comments; (3) the name and address of the secretary for the purpose of filing the comments and obtaining additional information; and (4) a statement that the persons may request, at the time of submitting written comments, notice of the permit decision and a list of persons qualified to test water.

Pursuant to W. Va. Code R. § 35-8-5.7.a, the operator shall provide the Well Site Safety Plan to the surface owner and any water purveyor or surface owner subject to notice and water testing as provided in section 15 of this rule.

Pursuant to W. Va. Code R. § 35-8-15.2.c, this notice shall: (1) contain a statement of the surface owner's and water purveyor's right to request sampling and analysis; (2) advise the surface owner and water purveyor of the rebuttable presumption for contamination or deprivation of a fresh water source or supply; advise the surface owner and water purveyor that refusal to allow the operator to conduct a pre-drilling water well test constitutes a method to rebut the presumption of liability; (3) advise the surface owner and water purveyor of his or her independent right to sample and analyze any water supply at his or her own expense; advise the surface owner and water purveyor whether or not the operator will utilize an independent laboratory to analyze any sample; and (4) advise the surface owner and or water purveyor that he or she can obtain from the Chief a list of water testing laboratories in the subject area capable of and qualified to test water supplies in accordance with standard acceptable methods.

Additional information related to horizontal drilling may be obtained from the Secretary, at the WV Department of Environmental Protection headquarters, located at 601 57th Street, SE, Charleston, WV 25304 (304-926-0450) or by visiting www.dep.wv.gov/oil-and-gas/pages/default.aspx.

Well Location Restrictions

Pursuant to W. Va. Code § 22-6A-12, Wells may not be drilled within two hundred fifty feet measured horizontally from any existing water well or developed spring used for human or domestic animal consumption. The center of well pads may not be located within six hundred twenty-five feet of an occupied dwelling structure, or a building two thousand five hundred square feet or larger used to house or shelter dairy cattle or poultry husbandry. This limitation is applicable to those wells, developed springs, dwellings or agricultural buildings that existed on the date a notice to the surface owner of planned entry for surveying or staking as provided in section ten of this article or a notice of intent to drill a horizontal well as provided in subsection (b), section sixteen of this article was provided, whichever occurs first, and to any dwelling under construction prior to that date. This limitation may be waived by written consent of the surface owner transmitted to the department and recorded in the real property records maintained by the clerk of the county commission for the county in which such property is located. Furthermore, the well operator may be granted a variance by the secretary from these distance restrictions upon submission of a plan which identifies the sufficient measures, facilities or practices to be employed during well site construction, drilling and operations. The variance, if granted, shall include terms and conditions the department requires to ensure the safety and protection of affected persons and property. The terms and conditions may include insurance, bonding and indemnification, as well as technical requirements. (b) No well pad may be prepared or well drilled within one hundred feet measured horizontally from any perennial stream, natural or artificial lake, pond or reservoir, or a wetland, or within three hundred feet of a naturally reproducing trout stream. No well pad may be located within one thousand feet of a surface or ground water intake of a public water supply. The distance from the public water supply as identified by the department shall be measured as follows: (1) For a surface water intake on a lake or reservoir, the distance shall be measured from the boundary of the lake or reservoir. (2) For a surface water intake on a flowing stream, the distance shall be measured from a semicircular radius extending upstream of the surface water intake. (3) For a groundwater source, the distance shall be measured from the wellhead or spring. The department may, in its discretion, waive these distance restrictions upon submission of a plan identifying sufficient measures, facilities or practices to be employed during well site construction, drilling and operations to protect the waters of the state. A waiver, if granted, shall impose any permit conditions as the secretary considers necessary. (c) Notwithstanding the foregoing provisions of this section, nothing contained in this section prevents an operator from conducting the activities permitted or authorized by a Clean Water Act Section 404 permit or other approval from the United States Army Corps of Engineers within any waters of the state or within the restricted areas referenced in this section. (d) The well location restrictions set forth in this section shall not apply to any well on a multiple well pad if at least one of the wells was permitted prior to the effective date of this article. (e) The secretary shall, by December 31, 2012, report to the Legislature on the noise, light, dust and volatile organic compounds generated by the drilling of horizontal wells as they relate to the well location restrictions regarding occupied dwelling structures pursuant to this section. Upon a finding, if any, by the secretary that the well location restrictions regarding occupied dwelling structures are inadequate or otherwise require alteration to address the items

examined in the study required by this subsection, the secretary shall have the authority to propose for promulgation legislative rules establishing guidelines and procedures regarding reasonable levels of noise, light, dust and volatile organic compounds relating to drilling horizontal wells, including reasonable means of mitigating such factors, if necessary.

Water Well Testing:

Pursuant to West Virginia Code § 22-6A-10(d), notification shall be made, with respect to surface landowners identified in subsection (b) or water purveyors identified in subdivision (5), subsection (b) of this section, of the opportunity for testing their water well. The operator shall provide an analysis to such surface landowner or water purveyor at their request.

Water Testing Laboratories:

Pursuant to West Virginia Code § 22-6A-10(i), persons entitled to notice pursuant to subsection (b) of this section may contact the department to ascertain the names and locations of water testing laboratories in the subject area capable and qualified to test water supplies in accordance with standard accepted methods. In compiling that list of names the department shall consult with the state Bureau for Public Health and local health departments. A surface owner and water purveyor has an independent right to sample and analyze any water supply at his or her own expense. The laboratory utilized by the operator shall be approved by the agency as being certified and capable of performing sample analyses in accordance with this section.

Rebuttable Presumption for Contamination or Deprivation of a Fresh Water Source or Supply:

W. Va. Code § 22-6A-18 requires that (b) unless rebutted by one of the defenses established in subsection (c) of this section, in any action for contamination or deprivation of a fresh water source or supply within one thousand five hundred feet of the center of the well pad for horizontal well, there is a rebuttable presumption that the drilling and the oil or gas well or either was the proximate cause of the contamination or deprivation of the fresh water source or supply. (c) In order to rebut the presumption of liability established in subsection (b) of this section, the operator must prove by a preponderance of the evidence one of the following defenses: (1) The pollution existed prior to the drilling or alteration activity as determined by a predrilling or prealteration water well test. (2) The landowner or water purveyor refused to allow the operator access to the property to conduct a predrilling or prealteration water well test. (3) The water supply is not within one thousand five hundred feet of the well. (4) The pollution occurred more than six months after completion of drilling or alteration activities. (5) The pollution occurred as the result of some cause other than the drilling or alteration activity. (d) Any operator electing to preserve its defenses under subdivision (1), subsection (c) of this section shall retain the services of an independent certified laboratory to conduct the predrilling or prealteration water well test. A copy of the results of the test shall be submitted to the department and the surface owner or water purveyor in a manner prescribed by the secretary. (e) Any operator shall replace the water supply of an owner of interest in real property who obtains all or part of that owner's supply of water for domestic, agricultural, industrial or other legitimate use from an underground or surface source with a comparable water supply where the secretary determines that the water supply has been affected by contamination, diminution or interruption proximately caused by the oil or gas operation, unless waived in writing by that owner. (f) The secretary may order the operator conducting the oil or gas operation to: (1) Provide an emergency drinking water supply within twenty-four hours; (2) Provide temporary water supply within seventy-two hours; (3) Within thirty days begin activities to establish a permanent water supply or submit a proposal to the secretary outlining the measures and timetables to be used in establishing a permanent supply. The total time in providing a permanent water supply may not exceed two years. If the operator demonstrates that providing a permanent replacement water supply cannot be completed within two years, the secretary may extend the time frame on case-by-case basis; and (4) Pay all reasonable costs incurred by the real property owner in securing a water supply. (g) A person as described in subsection (b) of this section aggrieved under the provisions of subsections (b), (e) or (f) of this section may seek relief in court... (i) Notwithstanding the denial of the operator of responsibility for the damage to the real property owner's water supply or the status of any appeal on determination of liability for the damage to the real property owner's water supply, the operator may not discontinue providing the required water service until authorized to do so by the secretary or a court of competent jurisdiction.

Written Comment:

Pursuant to West Virginia Code § 22-6A-11(a), all persons described in subsection (b), section ten of this article may file written comments with the secretary as to the location or construction of the applicant's proposed well work within thirty days after the application is filed with the secretary. All persons described in West Virginia Code § 22-6A-10(b) may file written comments as to the location or construction of the applicant's proposed well work to the Secretary at:

Chief, Office of Oil and Gas
Department of Environmental Protection
601 57th St. SE
Charleston, WV 25304
(304) 926-0450

Such persons may request, at the time of submitting written comments, notice of the permit decision and a list of persons qualified to test water. **NOTE: YOU ARE NOT REQUIRED TO FILE ANY COMMENT.**

20160129 03703

RECEIVED
Office of Oil and Gas
NOV 13 2015
WV Department of
Environmental Protection
01/29/2016

Time Limits and Methods for Filing Comments.

The law requires these materials to be served on or before the date the operator files its Application. You have **THIRTY (30) DAYS** after the filing date to file your comments. Comments must be filed in person or received in the mail by the Chief's office by the time stated above. You may call the Chief's office to be sure of the date. Check with your postmaster to ensure adequate delivery time or to arrange special expedited handling. If you have been contacted by the well operator and you have signed a "voluntary statement of no objection" to the planned work described in these materials, then the permit may be issued at any time.

Pursuant to West Virginia Code § 22-6A-11(c)(2), Any objections of the affected coal operators and coal seam owners and lessees shall be addressed through the processes and procedures that exist under sections fifteen, seventeen and forty, article six of this chapter, as applicable and as incorporated into this article by section five of this article. The written comments filed by the parties entitled to notice under subdivisions (1), (2), (4), (5) and (6), subsection (b), section ten of this article shall be considered by the secretary in the permit issuance process, but the parties are not entitled to participate in the processes and proceedings that exist under sections fifteen, seventeen or forty, article six of this chapter, as applicable and as incorporated into this article by section five of this article.

Comment Requirements

Your comments must be in writing and include your name, address and telephone number, the well operator's name and well number and the approximate location of the proposed well site including district and county from the application. You may add other documents, such as sketches, maps or photographs to support your comments.

Disclaimer: All comments received will be placed on our web site <http://www.dep.wv.gov/oil-and-gas/Horizontal-Permits/Pages/default.aspx> and the applicant will automatically be forwarded an email notice that such comments have been submitted. The applicant will be expected to provide a response to comments submitted by any surface owner, water purveyor or natural gas storage operator noticed within the application.

Permit Denial or Condition

The Chief has the power to deny or condition a well work permit. Pursuant to West Virginia Code § 22-6A-8(d), the permit may not be issued or be conditioned, including conditions with respect to the location of the well and access roads prior to issuance if the director determines that:

- (1) The proposed well work will constitute a hazard to the safety of persons;
- (2) The plan for soil erosion and sediment control is not adequate or effective;
- (3) Damage would occur to publicly owned lands or resources; or
- (4) The proposed well work fails to protect fresh water sources or supplies.

A permit may also be denied under West Virginia Code § 22-6A-7(k), the secretary shall deny the issuance of a permit if the secretary determines that the applicant has committed a substantial violation of a previously issued permit for a horizontal well, including the applicable erosion and sediment control plan associated with the previously issued permit, or a substantial violation of one or more of the rules promulgated under this article, and in each instance has failed to abate or seek review of the violation within the time prescribed by the secretary pursuant to the provisions of subdivisions (1) and (2), subsection (a), section five of this article and the rules promulgated hereunder, which time may not be unreasonable.

Pursuant to West Virginia Code § 22-6A-10(g), any person entitled to submit written comments to the secretary pursuant to subsection (a), section eleven of this article, shall also be entitled to receive from the secretary a copy of the permit as issued or a copy of the order modifying or denying the permit if the person requests receipt of them as a part of the written comments submitted concerning the permit application. Such persons may request, at the time of submitting written comments, notice of the permit decision and a list of persons qualified to test water.

4701706763


RECEIVED
Office of Oil and Gas
NOV 13 2015
WV Department of
Environmental Protection
01/29/2016

WW-6A
(8-13)

API NO. 47- 017 - _____
OPERATOR WELL NO. Rainer Unit 2H
Well Pad Name: Color Pad

Notice is hereby given by:


Well Operator: Antero Resources Corporation
Telephone: (303) 357-7310
Email: asteel@anteroresources.com

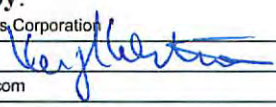

Address: 1615 Wynkoop Street
Denver, CO 80202
Facsimile: 303-357-7315

Oil and Gas Privacy Notice:

The Office of Oil and Gas processes your personal information, such as name, address and telephone number, as part of our regulatory duties. Your personal information may be disclosed to other State agencies or third parties in the normal course of business or as needed to comply with statutory or regulatory requirements, including Freedom of Information Act requests. Our office will appropriately secure your personal information. If you have any questions about our use or your personal information, please contact DEP's Chief Privacy Officer at deprivacyofficer@wv.gov.

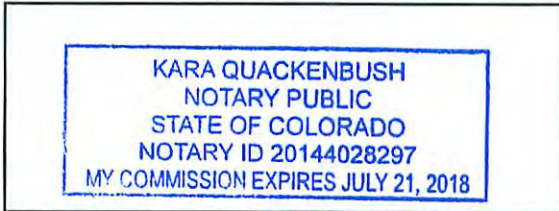

Subscribed and sworn before me this 12 day of November 2015

Kara Quackenbush Notary Public

My Commission Expires July 21, 2018

4701708783

RECEIVED
Office of Oil and Gas
NOV 13 2015
WV Department of
Environmental Protection
01/29/2016

WW-6A Notice of Application Attachment (COFOR PAD):

List of Surface Owner(s) with Proposed Disturbance associated with Cofor Well Pad:

WELL PAD – This owner was notified of all well work permit applications, and has executed a signed Surface Use Agreement with Antero Resources Corporation.

TM 11 PCLS 1 & 12

Owner: Coastal Forrest Resources Co.
Address: PO Box 709
Buckhannon, WV 26201 ✓

ROAD AND/OR OTHER DISTURBANCE – These owners have executed a signed Agreement with Antero Resources Corporation. However, they were only notified if their tract is overlying the oil and gas leasehold being developed by the proposed well work as outlined in WV Code 22-6A-10(b)(2).

TM 7 PCL 5

Owner: Douglas P. Farr, II
Address: 561 Veto Rd.
Little Hocking, OH 45742

TM 4 PCL 39

Owner: Martha A. McConnell
Address: 182 Shorty Ford Rd.
West Union, WV 26456

TM 4 PCL 33

Owner: George D. Lambert
Address: 12 Townridge Acres
Mullens, WV 25882

TM 4 PCLS 35 & 36

Owner: Jonathan L. & Jeffrey W. Davis
Address: 3175 Sam Cavins Rd.
West Union, WV 26456

STATE OF WEST VIRGINIA
DEPARTMENT OF ENVIRONMENTAL PROTECTION, OFFICE OF OIL AND GAS
NOTICE OF ENTRY FOR PLAT SURVEY

Notice Time Requirement: Notice shall be provided at least **SEVEN (7)** days but no more than **FORTY-FIVE (45)** days prior to entry

Date of Notice: 3/14/2014 **Date of Planned Entry:** 3/24/2014

Delivery method pursuant to West Virginia Code § 22-6A-10a

- PERSONAL SERVICE
 REGISTERED MAIL
 METHOD OF DELIVERY THAT REQUIRES A RECEIPT OR SIGNATURE CONFIRMATION

Pursuant to West Virginia Code § 22-6A-10(a), Prior to filing a permit application, the operator shall provide notice of planned entry on to the surface tract to conduct any plat surveys required pursuant to this article. Such notice shall be provided at least seven days but no more than forty-five days prior to such entry to: (1) The surface owner of such tract; (2) to any owner or lessee of coal seams beneath such tract that has filed a declaration pursuant to section thirty-six, article six, chapter twenty-two of this code; and (3) any owner of minerals underlying such tract in the county tax records. The notice shall include a statement that copies of the state Erosion and Sediment Control Manual and the statutes and rules related to oil and gas exploration and production may be obtained from the Secretary, which statement shall include contact information, including the address for a web page on the Secretary's web site, to enable the surface owner to obtain copies from the secretary.

Notice is hereby provided to:

SURFACE OWNER(s)

Name: Coastal Forest Resources Co.

Address: PO Box 709
Buckhannon, WV 26201

Name: _____

Address: _____

Name: _____

Address: _____

COAL OWNER OR LESSEE

Name: NO DECLARATIONS ON RECORD WITH COUNTY

Address: _____

MINERAL OWNER(s)

Name: Maxwell Franklin Heirs Limited Partnership #1 C/O ICG-Bank One

Address: PO Box 659
Buckhannon, WV 26201

*please attach additional forms if necessary

Notice is hereby given:

Pursuant to West Virginia Code § 22-6A-10(a), notice is hereby given that the undersigned well operator is planning entry to conduct a plat survey on the tract of land as follows:

State: <u>West Virginia</u>	Approx. Latitude & Longitude: <u>39.299423, -80.800056 (NAD 83)</u>
County: <u>Doddridge</u>	Public Road Access: <u>CR 11/8</u>
District: <u>West Union</u>	Watershed: <u>Tributary of Arnold Creek</u>
Quadrangle: <u>West Union 7.5'</u>	Generally used farm name: <u>Coastal Forest Resources Company</u>

Copies of the state Erosion and Sediment Control Manual and the statutes and rules related to oil and gas exploration and production may be obtained from the Secretary, at the WV Department of Environmental Protection headquarters, located at 601 57th Street, SE, Charleston, WV 25304 (304-926-0450). Copies of such documents or additional information related to horizontal drilling may be obtained from the Secretary by visiting www.dep.wv.gov/oil-and-gas/pages/default.aspx.

Notice is hereby given by:

Well Operator: <u>Antero Resources Corporation</u>	Address: <u>1615 Wynkoop Street</u>
Telephone: <u>(303) 357- 7323</u>	<u>Denver, CO 80202</u>
Email: <u>asteele@anteroresources.com</u>	Facsimile: <u>(303) 357-7315</u>

Oil and Gas Privacy Notice:

The Office of Oil and Gas processes your personal information, such as name, address and telephone number, as part of our regulatory duties. Your personal information may be disclosed to other State agencies or third parties in the normal course of business or as needed to comply with statutory or regulatory requirements, including Freedom of Information Act requests. Our office will appropriately secure your personal information. If you have any questions about our use or your personal information, please contact DEP's Chief Privacy Officer at depprivacyofficer@wv.gov.

RECEIVED
Office of Oil and Gas
NOV 13 2015
WV Department of Environmental Protection
Tax Map 11 Parcel 12

01/29/2016

STATE OF WEST VIRGINIA
DEPARTMENT OF ENVIRONMENTAL PROTECTION, OFFICE OF OIL AND GAS
NOTICE OF PLANNED OPERATION

Notice Time Requirement: notice shall be provided no later than the **filing date of permit application.**

Date of Notice: 11/12/2015 **Date Permit Application Filed:** 11/12/2015

Delivery method pursuant to West Virginia Code § 22-6A-16(c)

- CERTIFIED MAIL HAND
RETURN RECEIPT REQUESTED DELIVERY

Pursuant to W. Va. Code § 22-6A-16(c), no later than the date for filing the permit application, an operator shall, by certified mail return receipt requested or hand delivery, give the surface owner whose land will be used for the drilling of a horizontal well notice of the planned operation. The notice required by this subsection shall include: (1) A copy of this code section; (2) The information required to be provided by subsection (b), section ten of this article to a surface owner whose land will be used in conjunction with the drilling of a horizontal well; and (3) A proposed surface use and compensation agreement containing an offer of compensation for damages to the surface affected by oil and gas operations to the extent the damages are compensable under article six-b of this chapter. (d) The notices required by this section shall be given to the surface owner at the address listed in the records of the sheriff at the time of notice.

Notice is hereby provided to the SURFACE OWNER(s)

(at the address listed in the records of the sheriff at the time of notice):

Name: Coastal Forest Resources Co.
Address: P.O. Box 709
Buckhannon, WV 26201

Name: _____
Address: _____

Notice is hereby given:

Pursuant to West Virginia Code § 22-6A-16(c), notice is hereby given that the undersigned well operator has developed a planned operation on the surface owner's land for the purpose of drilling a horizontal well on the tract of land as follows:

State:	<u>West Virginia</u>	UTM NAD 83 Easting:	<u>517240m</u>
County:	<u>Doddridge</u>	Northing:	<u>4350010m</u>
District:	<u>West Union</u>	Public Road Access:	<u>CR 11/8</u>
Quadrangle:	<u>West Union 7.5'</u>	Generally used farm name:	<u>Coastal Forest Resources Company</u>
Watershed:	<u>Headwaters Middle Island Creek</u>		

This Notice Shall Include:

Pursuant to West Virginia Code § 22-6A-16(c), this notice shall include: (1) A copy of this code section; (2) The information required to be provided by **W. Va. Code § 22-6A-10(b)** to a surface owner whose land will be used in conjunction with the drilling of a horizontal well; and (3) A proposed surface use and compensation agreement containing an offer of compensation for damages to the surface affected by oil and gas operations to the extent the damages are compensable under article six-b of this chapter. Additional information related to horizontal drilling may be obtained from the Secretary, at the WV Department of Environmental Protection headquarters, located at 601 57th Street, SE, Charleston, WV 25304 (304-926-0450) or by visiting www.dep.wv.gov/oil-and-gas/pages/default.aspx.

Well Operator: Antero Resources Corporation
Telephone: (303) 357-7323
Email: asteelle@anteroresources.com

Address: 1615 Wynkoop Street
Denver, CO 80202
Facsimile: 303-357-7315

Oil and Gas Privacy Notice:

The Office of Oil and Gas processes your personal information, such as name, address and telephone number, as part of our regulatory duties. Your personal information may be disclosed to other State agencies or third parties in the normal course of business or as needed to comply with statutory or regulatory requirements, including Freedom of Information Act requests. Our office will appropriately secure your personal information. If you have any questions about our use or your personal information, please contact DEP's Chief Privacy Officer at depprivacyofficer@wv.gov.

RECEIVED
Office of Oil and Gas
NOV 18 2015
WV Department of
Environmental Protection



WEST VIRGINIA DEPARTMENT OF TRANSPORTATION
Division of Highways

1900 Kanawha Boulevard East • Building Five • Room 110
Charleston, West Virginia 25305-0430 • (304) 558-3505

Earl Ray Tomblin
Governor

Paul A. Mattox, Jr., P. E.
Secretary of Transportation/
Commissioner of Highways

February 20, 2015

James A. Martin, Chief
Office of Oil and Gas
Department of Environmental Protection
601 57th Street, SE
Charleston, WV 25304

4701706763

Subject: DOH Permit for the Cofor Pad, Doddridge County
Rainer Unit 2H Well site

Dear Mr. Martin,

This well site will be accessed from a DOH permit #04-2013-0684 which has been issued to Antero Resources Corporation for access to the State Road for a well site located off of Doddridge County Route 11 SLS.

The operator has signed a STATEWIDE OIL AND GAS ROAD MAINTENANCE BONDING AGREEMENT and provided the required Bond. This operator is currently in compliance with the DOH OIL AND GAS POLICY dated January 3, 2012.

Very Truly Yours,

Gary K. Clayton, P.E.
Regional Maintenance Engineer
Central Office O&G Coordinator

Cc: Megan Darling
Antero Resources Corporation
CH, OM, D-4
File

RECEIVED
Office of Oil and Gas
NOV 13 2015
WV Department of
Environmental Protection

List of Anticipated Additives Used for Fracturing or Stimulating Well

Additives	Chemical Abstract Service Number (CAS #)
Fresh Water	7732-18-5
2 Phosphobutane 1,2,4 tricarboxylic acid	37971-36-1
Ammonium Persulfate	7727-54-0
Anionic copolymer	proprietary
Anionic polymer	proprietary
BTEX Free Hydrotreated Heavy Naphtha	64742-48-9
Cellulase enzyme	(Proprietary)
Demulsifier Base	(Proprietary)
Ethoxylated alcohol blend	Mixture
Ethoxylated Nonylphenol	68412-54-4
Ethoxylated oleylamine	26635-93-8
Ethylene Glycol	107-21-1
Glycol Ethers	111-76-2
guar gum	9000-30-0
Hydrogen Chloride	7647-01-0
Hydrotreated light distillates, non-aromatic, BTEX free	64742-47-8
Isopropyl alcohol	67-63-0
liquid, 2,2-dibromo-3-nitrilopropionamide	10222-01-2
Microparticle	proprietary
Petroleum Distillates (BTEX Below Detect)	64742-47-8
Polyacrylamide	57-55-6
Propargyl Alcohol	107-19-7
Propylene Glycol	57-55-6
Quartz	14808-60-7
Sillica, crystalline quartz	7631-86-9
Sodium Chloride	7647-14-5
Sodium Hydroxide	1310-73-2
Sugar	57-50-1
Surfactant	68439-51-0
Suspending agent (solid)	14808-60-7
Tar bases, quinoline derivs, benzyl chloride-quaternized	72480-70-7

01/29/2016

RECEIVED
Office of Oil and Gas

NOV 13 2015

WV Department of
Environmental Protection

01/29/2016

LOCATION COORDINATES:

ACCESS ROAD ENTRANCE
 LATITUDE: 39.286222 LONGITUDE: -80.709541 (NAD 83)
 N 4349565.05 E 517235.49 (UTM ZONE 17 METERS)

CENTROID OF COFOR WELL PAD
 LATITUDE: 39.284823 LONGITUDE: -80.800506 (NAD 83)
 N 4350623.78 E 517240.30 (UTM ZONE 17 METERS)

CENTER OF WATER CONTAINMENT TANK
 LATITUDE: 39.283990 LONGITUDE: -80.810564 (NAD 83)
 N 4350528.69 E 516233.18 (UTM ZONE 17 METERS)

CENTROID OF ROCK RUN WELL PAD
 LATITUDE: 39.284823 LONGITUDE: -80.814548 (NAD 83)
 N 4350623.78 E 517240.30 (UTM ZONE 17 METERS)

GENERAL DESCRIPTION:

THE ACCESS ROADS, WELL PAD, AND WATER CONTAINMENT PAD HAVE BEEN CONSTRUCTED TO AID IN THE DEVELOPMENT OF INDIVIDUAL MARCELLUS SHALE GAS WELLS.

FLOODPLAIN NOTES:

THE SITE IS LOCATED IN FLOODZONE "X" PER FEMA FLOOD MAPS #54017C011C & #54017C012C

ENVIRONMENTAL NOTES:

WETLAND DELINEATIONS WERE PERFORMED BETWEEN OCTOBER, 2013 & FEBRUARY, 2014 BY ALLSTAR ECOLOGY, LLC TO REVIEW THE SITE FOR WATERS AND WETLANDS THAT ARE MOST LIKELY WITHIN THE REGULATORY JURISDICTION OF THE U.S. ARMY CORPS OF ENGINEERS (USACE) AND/OR THE WEST VIRGINIA DEPARTMENT OF ENVIRONMENTAL PROTECTION (WVDEP). THE FEBRUARY 04, 2013 ROCK RUN & COFOR JURISDICTIONAL STREAMS AND WETLANDS MAPS WERE PREPARED BY ALLSTAR ECOLOGY, LLC AND SUMMARIZE THE RESULTS OF THE FIELD DELINEATION. THE MAPS DO NOT, IN ANY WAY, REPRESENT A JURISDICTIONAL DETERMINATION OF THE LANDWARD LIMITS OF WATERS AND WETLANDS WHICH MAY BE REGULATED BY THE USACE OR THE WVDEP.

ROCK RUN & COFOR EPHEMERAL STREAM IMPACT (LINEAR FEET)			
Stream and Impact Cause	Fill (LF)	Culvert (LF)	Total Impact (LF)
Epheermal Stream 04 (Access Road "A")	2	N/A	2
Epheermal Stream 05 (Access Road "A")	0	52	52

GEOTECHNICAL NOTES:

A GEOTECHNICAL INVESTIGATION OF THE SITE WAS PERFORMED BY PENNSYLVANIA SOIL & ROCK, INC. BETWEEN JANUARY 15, 2014 & FEBRUARY 4, 2014. THE REPORT PREPARED BY PENNSYLVANIA SOIL & ROCK, INC. DATED FEBRUARY 17, 2014, REFLECTS THE RESULTS OF THE BURNSPRING INVESTIGATION. THE INFORMATION AND RECOMMENDATIONS CONTAINED IN THIS REPORT WAS USED IN THE PREPARATION OF THESE PLANS. PLEASE REFER TO THE GEOTECHNICAL INVESTIGATION REPORT BY PENNSYLVANIA SOIL & ROCK, INC. FOR ADDITIONAL INFORMATION, AS REFERRED.

PROJECT CONTACTS:

OPERATION:

ANTERO RESOURCES CORPORATION
 255 WHITE OAK BLVD
 BRIDGEPORT, WV 26330
 PHONE: (304) 462-4100
 FAX: (304) 462-4102

ELI WADZONER - ENVIRONMENTAL ENGINEER
 OFFICE: (304) 842-4288 CELL: (304) 478-0770

JOHN KAWCAK - OPERATIONS SUPERINTENDENT
 CELL: (817) 368-1553

AARON KUNZLER - CONSTRUCTION SUPERVISOR
 OFFICE: (405) 227-8344

ANTHONY SMITH - FIELD ENGINEER
 OFFICE: (304) 842-4208 CELL: (304) 673-6196

MARK JOHNSON - SURVEYING COORDINATOR
 (304) 842-4162 CELL: (304) 719-6449

DAVE CAVA - LAND AGENT
 (304) 641-0614

RESTRICTIONS NOTES:

- THERE ARE NO PERENNIAL STREAMS, WETLANDS, LAKES, PONDS, OR RESERVOIRS WITHIN 100 FEET OF THE WELL PADS AND LOD.
- THERE ARE NO NATURALLY PRODUCING TROUT STREAMS WITHIN 500 FEET OF THE WELL PADS AND LOD.
- THERE ARE NO GROUNDWATER INTAKE OR PUBLIC WATER SUPPLY FACILITIES WITHIN 1000 FEET OF THE WELL PADS AND LOD.
- THERE ARE NO APPARENT EXISTING WATER WELLS OR DEVELOPED SPRINGS WITHIN 250 FEET OF THE WELLS BEING DRILLED.
- THERE ARE NO OCCUPIED DWELLING STRUCTURES WITHIN 625 FEET OF THE CENTER OF THE WELL PADS.
- THERE ARE NO AGRICULTURAL BUILDINGS LARGER THAN 2,500 SQUARE FEET WITHIN 625 FEET OF THE CENTER OF THE WELL PADS.


NOTES:

- ALL BMP'S MUST REMAIN IN PLACE AND FUNCTIONAL UNTIL ALL AREAS WITHIN THE LIMIT OF DISTURBANCE ARE COMPLETE AND PERMANENTLY STABILIZED. MAINTENANCE MUST INCLUDE INSPECTION OF ALL EROSION AND SEDIMENT CONTROLS AFTER EACH RAINFALL EVENT IN EXCESS OF 0.5" AND ON A BIWEEKLY BASIS.
- THE CONSTRUCTION SITE SHOULD BE STABILIZED AS SOON AS POSSIBLE AFTER COMPLETION. ESTABLISHMENT OF FINAL STABILIZATION MUST BE INITIATED NO LATER THAN 7 DAYS AFTER REACHING FINAL GRADE. FINAL STABILIZATION SHALL BE COMPLETED WITHIN 90 DAYS OF COMPLETION, AND THAT EITHER A PERMANENT VEGETATIVE COVER WITH A DENSITY OF 70% OR GREATER HAS BEEN ESTABLISHED OR THAT THE SURFACE HAS BEEN STABILIZED BY HARD COVER SUCH AS PAVEMENT OR BUILDINGS. IT SHOULD BE NOTED THAT THE 70% REQUIREMENT REFERS TO THE TOTAL AREA VEGETATED AND NOT JUST A PERCENT OF THE SITE.
- ALL PERMANENT SEDIMENT CONTROL MEASURES CAN BE REMOVED AFTER THE SITE IS PERMANENTLY STABILIZED AND APPROVAL IS RECEIVED FROM THE WVDEP.
- ANY AREAS DISTURBED BY REMOVAL OF CONTROLS SHALL BE REPAIRED, STABILIZED, AND PERMANENTLY SEED.

Well API Numbers for Rock Run & Cofor
 1706476, 1706494, 1706509
 1706518, 1706519, 1706559, 1706560

ROCK RUN & COFOR WELL PADS & WATER CONTAINMENT PAD AS-BUILT AND EROSION & SEDIMENT CONTROL IMPROVEMENT PLAN CENTRAL & WEST UNION DISTRICTS, DODDRIDGE COUNTY, WEST VIRGINIA NUTTER FORK - MIDDLE ISLAND CREEK & ARNOLD CREEK WATERSHEDS


USGS 7.5 WEST UNION QUAD MAP

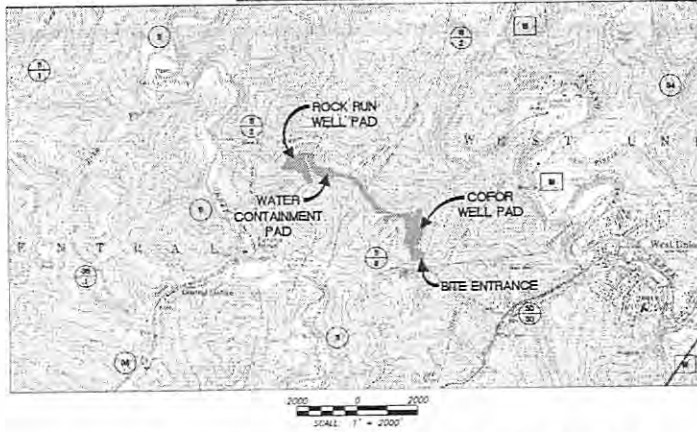

WEST VIRGINIA COUNTY MAP



WVDOH COUNTY ROAD MAP

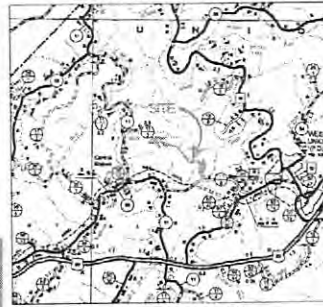

WVDEP OGC
 ACCEPTED AS-BUILT
 1/21 429-2016

MISS Utility of West Virginia
 1-800-245-4848
 West Virginia State Law
 (Section XIV, Chapter 24-C)
 Requires that you call two
 business days before you dig in
 the state of West Virginia.
 IT'S THE LAW!!

AS-BUILT CERTIFICATION:
 THE DRAWINGS, CONSTRUCTION NOTES, AND REFERENCE DIAGRAMS ATTACHED HERETO HAVE BEEN PREPARED IN ACCORDANCE WITH THE WEST VIRGINIA CODE OF STATE RULES, DIVISION OF ENVIRONMENTAL PROTECTION, CHAPTER 60.10, AND GAS ERS 35-B.

SHEET INDEX:

- COVER SHEET
- LEGEND
- OVERALL PLAN SHEET INDEX
- ACCESS ROAD & STAGING AREA "A" AS-BUILT PLAN
- ACCESS ROAD & COFOR WELL PAD AS-BUILT PLAN
- ACCESS ROAD AS-BUILT PLAN
- ACCESS ROAD & WATER CONTAINMENT PAD AS-BUILT PLAN
- ACCESS ROAD & ROCK RUN WELL PAD AS-BUILT PLAN
- ACCESS ROAD PROFILES
- COFOR WELL PAD, ROCK RUN WELL PAD, & WATER CONTAINMENT PAD SECTIONS

ROCK RUN WELL PAD					
Proposed Well Name	WV North NAD 27	WV North NAD 83	UTM (METERS) Zone 17	NAD 83 Lat & Long	
Future Well	N 294973.44	N 295008.93	E 435025.20	LAT 39-18-17.8429	
Future Well	E 162791.56	E 158632.38	N 435025.12	LAT 39-18-17.8429	
Development Unit 2H	N 294973.44	N 295008.93	E 435025.20	LAT 39-18-17.8429	
Development Unit 2H	E 162791.56	E 158632.38	N 435025.12	LAT 39-18-17.8429	
Wertz Unit 2H (Drilled Well) API# 47-017-06379	N 294973.44	N 295008.93	E 435025.20	LAT 39-18-17.8429	
Wertz Unit 2H (Drilled Well) API# 47-017-06379	E 162791.56	E 158632.38	N 435025.12	LAT 39-18-17.8429	
Teaford Unit 2H (Drilled Well) API# 47-017-06412	N 294973.44	N 295008.93	E 435025.20	LAT 39-18-17.8429	
Teaford Unit 2H (Drilled Well) API# 47-017-06412	E 162791.56	E 158632.38	N 435025.12	LAT 39-18-17.8429	
Well Pad Elevation	1170.1-1170.1				

COFOR WELL PAD					
Proposed Well Name	WV North NAD 27	WV North NAD 83	UTM (METERS)	NAD 83 Lat & Long	
Outback Unit 1H (Drilled Well) API# 47-017-05815	N 294973.44	N 295008.93	E 435025.20	LAT 39-18-17.8429	
Outback Unit 2H (Drilled Well) API# 47-017-05815	E 162791.56	E 158632.38	N 435025.12	LAT 39-18-17.8429	
Marston Unit 1H (Drilled Well) API# 47-017-05830	N 294973.44	N 295008.93	E 435025.20	LAT 39-18-17.8429	
Marston Unit 2H (Drilled Well) API# 47-017-05830	E 162791.56	E 158632.38	N 435025.12	LAT 39-18-17.8429	
Notes Unit 1H	N 294973.44	N 295008.93	E 435025.20	LAT 39-18-17.8429	
Notes Unit 2H	E 162791.56	E 158632.38	N 435025.12	LAT 39-18-17.8429	
Graps Unit 1H	N 294973.44	N 295008.93	E 435025.20	LAT 39-18-17.8429	
Graps Unit 2H	E 162791.56	E 158632.38	N 435025.12	LAT 39-18-17.8429	
Blower Unit 1H	N 294973.44	N 295008.93	E 435025.20	LAT 39-18-17.8429	
Blower Unit 2H	E 162791.56	E 158632.38	N 435025.12	LAT 39-18-17.8429	
Well Pad Elevation	1189.4-1189.1				

ROCK RUN & COFOR LIMITS OF DISTURBANCE AREA (A/C)	
Access Road "A" (4 750')	16.40
Access Road "B" (1 253')	0.35
Access Road "C" (322')	1.26
Staging Area "A"	1.39
Rock Run Well Pad	6.81
Cofor Well Pad	3.70
Water Containment Pad	2.27
Excess/Topsoil Material Stockpiles	11.86
Total Affected Area	50.15
Total Wooded Acres Disturbed	43.82
Impacts to Coastal Forest Resources Co. TM 11-12	
Access Road "A" (2 156')	7.75
Access Road "C" (123')	1.36
Staging Area "A"	1.39
Cofor Well Pad	3.70
Excess/Topsoil Material Stockpiles	7.63
Total Affected Area	22.13
Total Wooded Acres Disturbed	19.02
Impacts to Coastal Forest Resources Co. TM 11-1	
Access Road "A" (1 400')	0.55
Total Affected Area	5.55
Total Wooded Acres Disturbed	4.72

Impacts to Douglas P. Farr E TM 7-6	
Access Road "A" (215')	1.39
Water Containment Pad	1.03
Excess/Topsoil Material Stockpiles	0.09
Total Affected Area	2.51
Total Wooded Acres Disturbed	2.55
Impacts to Martha E. McConnell TM 4-29	
Access Road "A" (755')	1.71
Access Road "B" (1 253')	5.79
Rock Run Well Pad	0.54
Water Containment Pad	1.24
Excess/Topsoil Material Stockpiles	0.50
Total Affected Area	9.77
Total Wooded Acres Disturbed	6.02
Impacts to George D. Lambert TM 4-33	
Access Road "B" (0')	0.25
Rock Run Well Pad	4.06
Excess/Topsoil Material Stockpiles	0.32
Total Affected Area	7.63
Total Wooded Acres Disturbed	5.32
Impacts to Jonathan L. & Jeffrey W. Davis TM 4-36	
Rock Run Well Pad	2.10
Total Affected Area	2.10
Total Wooded Acres Disturbed	2.10
Impacts to Jonathan L. & Jeffrey W. Davis TM 4-35	
Rock Run Well Pad	0.12
Total Affected Area	0.12
Total Wooded Acres Disturbed	0.11

NOTES:

- THE AS-BUILT INFORMATION SHOWN HEREON REFLECTS FIELD DATA COLLECTED RELATING TO THE FINAL GRADING OF THE DISTURBED AREA AS OF JANUARY 15, 2015. NAVITUS ENGINEERING IS NOT RESPONSIBLE FOR ANY CHANGES MADE TO THE SITE AFTER THE ABOVE MENTIONED DATE.
- THE EXISTING CONTAINMENT BERM AROUND THE WELL PAD SHALL BE REPAIRED AS NECESSARY TO ENSURE 100% CONTAINMENT OF ALL FILLS PRIOR TO DRILLING OPERATIONS.
- THE EXISTING EGRESS TO THE WELL PAD SHALL HAVE THE MOUNTABLE BEAMS REPAIRED AS NECESSARY TO ENSURE 100% CONTAINMENT OF ALL FILLS PRIOR TO DRILLING OPERATIONS.

NAVITUS ENERGY ENGINEERING
 Telephone: (800) 627-4105 www.navituseng.com

COVER SHEET

ROCK RUN & COFOR
 WELL PADS & WATER CONTAINMENT PAD
 CENTRAL & WEST UNION DISTRICTS
 DODDRIDGE COUNTY, WEST VIRGINIA

DATE: 02/16/2015
 SCALE: AS SHOWN
 SHEET 1 OF 11


THIS DOCUMENT WAS PREPARED FOR ANTERO RESOURCES CORPORATION

ACCESS ROAD & ROCK RUN WELL PAD AS-BUILT PLAN

- NOTES:**
1. THE EXISTING CONTAINMENT BEEM AROUND THE WELL PAD SHALL BE REPAIRED AS NECESSARY TO ENSURE 100% CONTAINMENT OF ALL FLUIDS PRIOR TO DRILLING OPERATIONS
 2. THE EXISTING EGRESSOR TO THIS WELL PAD SHALL HAVE THE MOUNTABLE BEEM REPAIRED AS NECESSARY TO ENSURE 100% CONTAINMENT OF ALL FLUIDS PRIOR TO DRILLING OPERATIONS.

**WYDEP OOG
ACCEPTED AS-BUILT**
4/21 4-23-2015

- WELLHEAD INDEX**
- (A) FUTURE WELL
 - (B) FUTURE WELL
 - (C) DEVONIAN UNIT 2H
 - (D) DEVONIAN UNIT 1H
 - (E) FRONT UNIT 2H (DRILLED WELL)
 - (F) FRONT UNIT 1H (DRILLED WELL)
 - (G) TRIVECTOR UNIT 2H (DRILLED WELL)

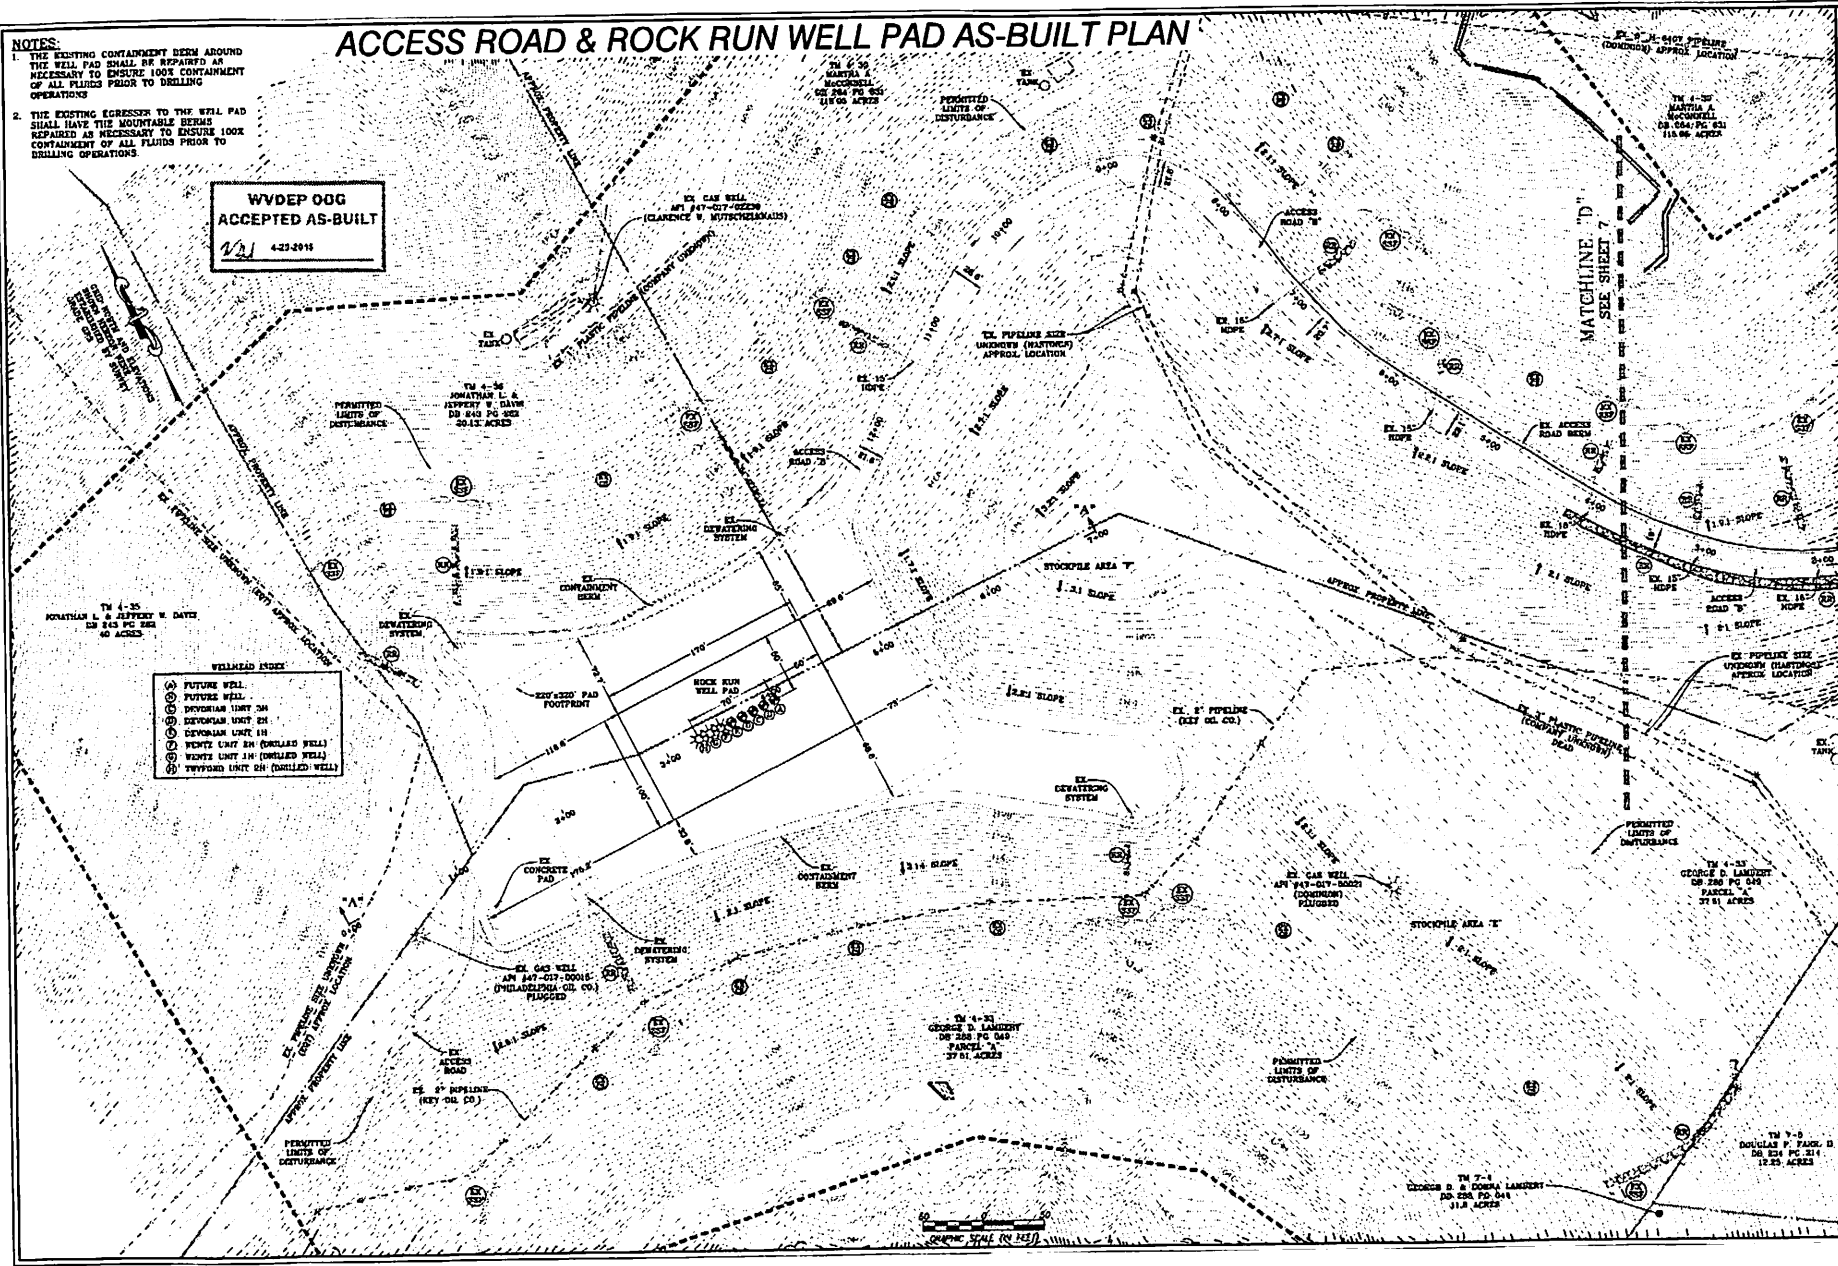

NAVITUS
ENERGY ENGINEERING

REVISION	DATE



THIS DOCUMENT WAS PREPARED FOR ANTERO RESOURCES CORPORATION

ROCK RUN & COFOR
WELL PADS & WATER CONTAINMENT PAD
CENTRAL & WEST UNION DISTRICTS
DODDRIDGE COUNTY, WEST VIRGINIA



DATE: 02/16/2015
SCALE: 1" = 50'
SHEET 8 OF 11

LOCATION COORDINATES:

ACCESS ROAD ENTRANCE
LATITUDE: 39.296222 LONGITUDE: -80.799541 (NAD 83)
N 4349688.65 E 517285.49 (UTM ZONE 17 METERS)

CENTROID OF COFOR WELL PAD
LATITUDE: 39.299423 LONGITUDE: -80.800056 (NAD 83)
N 4350023.78 E 517240.30 (UTM ZONE 17 METERS)

CENTER OF WATER CONTAINMENT TANK
LATITUDE: 39.303990 LONGITUDE: -80.810564 (NAD 83)
N 4350528.67 E 516333.18 (UTM ZONE 17 METERS)

CENTROID OF ROCK RUN WELL PAD
LATITUDE: 39.304923 LONGITUDE: -80.814648 (NAD 83)
N 4350831.48 E 515980.84 (UTM ZONE 17 METERS)

GENERAL DESCRIPTION:

THE ACCESS ROAD(S), WELL PADS, AND WATER CONTAINMENT PAD HAVE BEEN CONSTRUCTED TO AID IN THE DEVELOPMENT OF INDIVIDUAL MARCELLUS SHALE GAS WELLS.

FLOODPLAIN NOTES:

THE SITE IS LOCATED IN FLOODZONE "X" PER FEMA FLOOD MAPS #54017C0115C & #54017C0120C

ENVIRONMENTAL NOTES:

WETLAND DELINEATIONS WERE PERFORMED BETWEEN OCTOBER, 2013 & FEBRUARY, 2014 BY ALLSTAR ECOLOGY, LLC TO REVIEW THE SITE FOR WATERS AND WETLANDS THAT ARE MOST LIKELY WITHIN THE REGULATORY PURVIEW OF THE U.S. ARMY CORPS OF ENGINEERS (USACE) AND/OR THE WEST VIRGINIA DEPARTMENT OF ENVIRONMENTAL PROTECTION (WVDEP). THE FEBRUARY 06, 2013 ROCK RUN & COFOR JURISDICTIONAL STREAMS & WETLANDS MAPS WERE PREPARED BY ALLSTAR ECOLOGY, LLC AND SUMMARIZE THE RESULTS OF THE FIELD DELINEATION. THE MAPS DO NOT, IN ANY WAY, REPRESENT A JURISDICTIONAL DETERMINATION OF THE LANDWARD LIMITS OF WATERS AND WETLANDS WHICH MAY BE REGULATED BY THE USACE OR THE WVDEP.

ROCK RUN & COFOR EPHEMERAL STREAM IMPACT (LINEAR FEET)				
Stream and Impact Cause	Fill (LF)	Culvert (LF)	Inlets/Outlets Structures (LF)	Total Impact (LF)
Ephemeral Stream 04 (Access Road "A")	2	N/A	N/A	2
Ephemeral Stream 05 (Access Road "A")	0	52	14	66

GEOTECHNICAL NOTES:

A GEOTECHNICAL INVESTIGATION OF THE SITE WAS PERFORMED BY PENNSYLVANIA SOIL & ROCK, INC. BETWEEN JANUARY 15, 2014 & FEBRUARY 5, 2014. THE REPORT PREPARED BY PENNSYLVANIA SOIL & ROCK, INC. DATED FEBRUARY 17, 2014, REFLECTS THE RESULTS OF THE SUBSURFACE INVESTIGATION. THE INFORMATION AND RECOMMENDATIONS CONTAINED IN THIS REPORT WAS USED IN THE PREPARATION OF THESE PLANS. PLEASE REFER TO THE GEOTECHNICAL INVESTIGATION REPORT BY PENNSYLVANIA SOIL & ROCK, INC. FOR ADDITIONAL INFORMATION, AS NEEDED.

PROJECT CONTACTS:

OPERATOR:

ANTERO RESOURCES CORPORATION
535 WHITE OAKS BLVD.
BRIDGEPORT, WV 28330
PHONE: (304) 842-4100
FAX: (304) 842-4102

ELI WAGONER - ENVIRONMENTAL ENGINEER
OFFICE: (304) 842-4068 CELL: (304) 476-0770

JOHN KAWCAK - OPERATIONS SUPERINTENDENT
CELL: (617) 368-1553

AARON KUNZLER - CONSTRUCTION SUPERVISOR
CELL: (405) 227-8344

ANTHONY SMITH - FIELD ENGINEER
OFFICE: (304) 842-4208 CELL: (304) 673-6198

MARK JOHNSON - SURVEYING COORDINATOR
(304) 842-4162 CELL: (304) 719-6449

DAVE CAVA - LAND AGENT
(304) 641-5814

ENGINEER/SURVEYOR:

NAVITUS ENGINEERING, INC.
CYRUS S. KUMP, PE - PROJECT
MANAGER/ENGINEER
OFFICE: (888) 662-4185 CELL: (540) 688-8747

ENVIRONMENTAL:

ALLSTAR ECOLOGY, LLC
RYAN L. WARD - ENVIRONMENTAL SCIENTIST
(866) 213-2886 CELL: (304) 692-7477

GEOTECHNICAL:

PENNSYLVANIA SOIL & ROCK, INC.
CHRISTOPHER W. SAMIOS - PROJECT ENGINEER
(412) 372-4000 CELL: (412) 589-0682

RESTRICTIONS NOTES:

1. THERE ARE NO PERENNIAL STREAMS, WETLANDS, LAKES, PONDS, OR RESERVOIRS WITHIN 100 FEET OF THE WELL PADS AND LOD.
2. THERE ARE NO NATURALLY PRODUCING TROUT STREAMS WITHIN 300 FEET OF THE WELL PADS AND LOD.
3. THERE ARE NO GROUNDWATER INTAKE OR PUBLIC WATER SUPPLY FACILITIES WITHIN 1000 FEET OF THE WELL PADS AND LOD.
4. THERE ARE NO APPARENT EXISTING WATER WELLS OR DEVELOPED SPRINGS WITHIN 250 FEET OF THE WELL(S) BEING DRILLED.
5. THERE ARE NO OCCUPIED DWELLING STRUCTURES WITHIN 625 FEET OF THE CENTER OF THE WELL PADS.
6. THERE ARE NO AGRICULTURAL BUILDINGS LARGER THAN 2,500 SQUARE FEET WITHIN 625 FEET OF THE CENTER OF THE WELL PADS.


NOTES:

1. ALL BMP'S MUST REMAIN IN PLACE AND FUNCTIONAL UNTIL ALL AREAS WITHIN THE LIMIT OF DISTURBANCE ARE COMPLETE AND PERMANENTLY STABILIZED. MAINTENANCE MUST INCLUDE INSPECTION OF ALL EROSION AND SEDIMENT CONTROLS AFTER EACH RUNOFF EVENT IN EXCESS OF 0.5" AND ON A BIWEEKLY BASIS.
2. THE CONSTRUCTION SITE SHOULD BE STABILIZED AS SOON AS POSSIBLE AFTER COMPLETION. ESTABLISHMENT OF FINAL STABILIZATION MUST BE INITIATED NO LATER THAN 7 DAYS AFTER REACHING FINAL GRADE. FINAL STABILIZATION MEANS THAT ALL SOIL-DISTURBING ACTIVITIES ARE COMPLETED, AND THAT EITHER A PERMANENT VEGETATIVE COVER WITH A DENSITY OF 70% OR GREATER HAS BEEN ESTABLISHED OR THAT THE SURFACE COVER HAS BEEN STABILIZED BY HARD COVER SUCH AS PAVEMENT OR BUILDINGS. IT SHOULD BE NOTED THAT THE 70% REQUIREMENT REFERS TO THE TOTAL AREA VEGETATED AND NOT JUST A PERCENT OF THE SITE.
3. ALL PERMANENT SEDIMENT CONTROL MEASURES CAN BE REMOVED AFTER THE SITE IS PERMANENTLY STABILIZED AND APPROVAL IS RECEIVED FROM THE WVDEP.
4. ANY AREAS DISTURBED BY REMOVAL OF CONTROLS SHALL BE REPAIRED, STABILIZED, AND PERMANENTLY SEEDED.

ROCK RUN & COFOR WELL PADS & WATER CONTAINMENT PAD AS-BUILT AND EROSION CONTROL IMPROVEMENT

CENTRAL & WEST UNION DISTRICTS, DODD RIVER
NUTTER FORK - MIDDLE ISLAND CREEK & ALLEY

USGS 7.5 WEST UNION

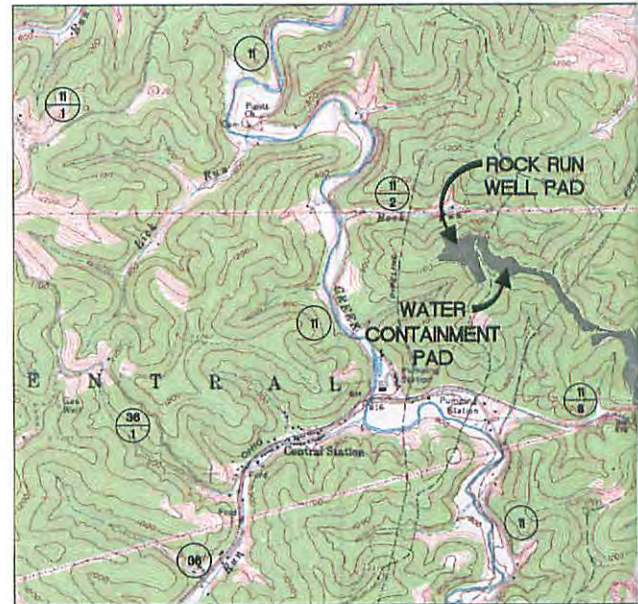

WEST VIRGINIA COUNTY MAP



MISS Utility of West Virginia
1-800-245-4848
West Virginia State Law
(Section XIV: Chapter 24-C)
Requires that you call two
business days before you dig in
the state of West Virginia.
IT'S THE LAW!!


COFOR CONTAINMENT PAD & SEDIMENT MENT PLAN

LOGE COUNTY, WEST VIRGINIA
MOLD CREEK WATERSHEDS

QUAD MAP



WVDOH COUNTY ROAD MAP

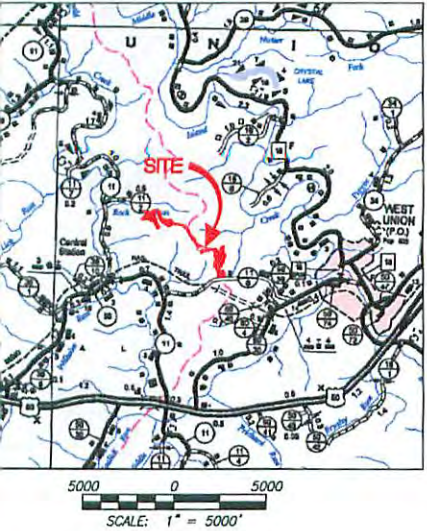

AS-BUILT CERTIFICATION:
THE DRAWINGS, CONSTRUCTION NOTES, AND REFERENCE DIAGRAMS ATTACHED HERETO HAVE BEEN PREPARED IN ACCORDANCE WITH THE WEST VIRGINIA CODE OF STATE RULES, DIVISION OF ENVIRONMENTAL PROTECTION, OFFICE OF OIL AND GAS CRS 35-8.

WEST VIRGINIA STATE PLANE COORDINATE SYSTEM
NORTH ZONE, NAD83
ELEVATION BASED ON NAVD83
ESTABLISHED BY SURVEY GRADE GPS & OPUS
POST-PROCESSING

SHEET INDEX:

- 1 - COVER SHEET
- 2 - LEGEND
- 3 - OVERALL PLAN SHEET INDEX
- 4 - ACCESS ROAD & STAGING AREA "A" AS-BUILT PLAN
- 5 - ACCESS ROAD & COFOR WELL PAD AS-BUILT PLAN
- 6 - ACCESS ROAD AS-BUILT PLAN
- 7 - ACCESS ROAD & WATER CONTAINMENT PAD AS-BUILT PLAN
- 8 - ACCESS ROAD & ROCK RUN WELL PAD AS-BUILT PLAN
- 9-10 - ACCESS ROAD PROFILES
- 11 - COFOR WELL PAD, ROCK RUN WELL PAD, & WATER CONTAINMENT PAD SECTIONS

Duane O'Hain
11-16-15

ROCK RUN WELL PAD				
Proposed Well Name	WV North NAD 27	WV North NAD 83	UTM (METERS) Zone 17	NAD 83 Lat & Long
Future Well	N 295873.44	N 295908.52	N 4350635.20	LAT 39-18-17.8429
	E 1627981.56	E 1596540.38	E 515991.08	LONG -80-48-52.3053
Future Well	N 295873.29	N 295908.37	N 4350635.10	LAT 39-18-17.8400
	E 1627971.56	E 1596530.38	E 515988.03	LONG -80-48-52.4325
Devonian Unit 3H	N 295873.14	N 295908.22	N 4350635.01	LAT 39-18-17.8370
	E 1627961.57	E 1596520.38	E 515984.98	LONG -80-48-52.5596
Devonian Unit 2H	N 295872.99	N 295908.07	N 4350634.91	LAT 39-18-17.8341
	E 1627951.57	E 1596510.38	E 515981.94	LONG -80-48-52.6868
Devonian Unit 1H	N 295872.83	N 295907.92	N 4350634.81	LAT 39-18-17.8311
	E 1627941.57	E 1596500.38	E 515978.89	LONG -80-48-52.8140
Wentz Unit 2H (Drilled Well) API# 47-017-06509	N 295872.66	N 295907.76	N 4350634.72	LAT 39-18-17.8282
	E 1627931.57	E 1596490.39	E 515975.85	LONG -80-48-52.9411
Wentz Unit 1H (Drilled Well) API# 47-017-06476	N 295872.53	N 295907.61	N 4350634.62	LAT 39-18-17.8252
	E 1627921.57	E 1596480.39	E 515972.80	LONG -80-48-53.0683
Twyford Unit 2H (Drilled Well) API# 47-017-06402	N 295872.38	N 295907.46	N 4350634.52	LAT 39-18-17.8223
	E 1627911.57	E 1596470.39	E 515969.76	LONG -80-48-53.1954
Well Pad Elevation	1170.7-1170.9			

COFOR WELL PAD				
Proposed Well Name	WV North NAD 27	WV North NAD 83	UTM (METERS)	NAD 83 Lat & Long
Outback Unit 1H (Drilled Well) API# 47-017-06518	N 293842.73	N 293877.91	N 4350037.13	LAT 39-17-58.3563
	E 1632026.37	E 1600585.17	E 517233.64	LONG -80-48-00.4783
Outback Unit 2H (Drilled Well) API# 47-017-06519	N 293832.93	N 293868.12	N 4350034.16	LAT 39-17-58.2599
	E 1632028.39	E 1600587.19	E 517234.31	LONG -80-48-00.4568
Morton Unit 1H (Drilled Well) API# 47-017-06559	N 293823.14	N 293858.33	N 4350031.19	LAT 39-17-58.1633
	E 1632030.41	E 1600585.21	E 517234.97	LONG -80-48-00.4233
Morton Unit 2H (Drilled Well) API# 47-017-06560	N 293813.35	N 293848.53	N 4350028.21	LAT 39-17-58.0669
	E 1632032.44	E 1600591.24	E 517235.64	LONG -80-48-00.3957
Nova Unit 1H	N 293803.55	N 293838.74	N 4350025.24	LAT 39-17-57.9703
	E 1632034.46	E 1600593.26	E 517236.31	LONG -80-48-00.3682
Nova Unit 2H	N 293793.76	N 293828.95	N 4350022.27	LAT 39-17-57.8738
	E 1632036.48	E 1600595.28	E 517236.97	LONG -80-48-00.3407
Grape Unit 1H	N 293783.97	N 293819.15	N 4350019.29	LAT 39-17-57.7773
	E 1632038.51	E 1600597.30	E 517237.64	LONG -80-48-00.3131
Grape Unit 2H	N 293774.17	N 293809.36	N 4350016.32	LAT 39-17-57.6809
	E 1632040.53	E 1600599.33	E 517238.30	LONG -80-48-00.2856
Rainier Unit 1H	N 293764.38	N 293799.57	N 4350013.35	LAT 39-17-57.5843
	E 1632042.55	E 1600601.35	E 517238.97	LONG -80-48-00.2580
Rainier Unit 2H	N 293754.59	N 293789.77	N 4350010.37	LAT 39-17-57.4879
	E 1632044.58	E 1600603.37	E 517239.64	LONG -80-48-00.2305
Well Pad Elevation	1189.4-1189.7			

ROCK RUN & COFOR LIMITS OF DISTURBANCE AREA (AC)	
Total Site	
Access Road "A" (4,792')	16.40
Access Road "B" (1,253')	6.36
Access Road "C" (523')	1.36
Staging Area "A"	1.39
Rock Run Well Pad	6.81
Cofor Well Pad	3.70
Water Containment Pad	2.27
Excess/Topsoil Material Stockpiles	11.86
Total Affected Area	50.15
Total Wooded Acres Disturbed	43.52
Impacts to Coastal Forest Resources Co. TM 11-12	
Access Road "A" (2,356')	7.75
Access Road "C" (523')	1.36
Staging Area "A"	1.39
Cofor Well Pad	3.70
Excess/Topsoil Material Stockpiles	7.93
Total Affected Area	22.13
Total Wooded Acres Disturbed	19.00
Impacts to Coastal Forest Resources Co. TM 11-1	
Access Road "A" (1,460')	5.55
Total Affected Area	5.55
Total Wooded Acres Disturbed	4.72

Impacts to Douglas P. Farr, # TM 7-5	
Access Road "A" (218')	1.39
Access Road "B" (0')	0.32
Water Containment Pad	1.03
Excess/Topsoil Material Stockpiles	0.09
Total Affected Area	2.83
Total Wooded Acres Disturbed	2.65
Impacts to Martha A. McConnell TM 4-39	
Access Road "A" (758')	1.71
Access Road "B" (1,253')	5.79
Rock Run Well Pad	0.53
Water Containment Pad	1.24
Excess/Topsoil Material Stockpiles	0.50
Total Affected Area	9.77
Total Wooded Acres Disturbed	8.62
Impacts to George D. Lambert TM 4-33	
Access Road "B" (0')	0.25
Rock Run Well Pad	4.06
Excess/Topsoil Material Stockpiles	3.34
Total Affected Area	7.65
Total Wooded Acres Disturbed	6.32
Impacts to Jonathan L. & Jeffery W. Davis TM 4-36	
Rock Run Well Pad	2.10
Total Affected Area	2.10
Total Wooded Acres Disturbed	2.10
Impacts to Jonathan L. & Jeffery W. Davis TM 4-35	
Rock Run Well Pad	0.12
Total Affected Area	0.12
Total Wooded Acres Disturbed	0.11

NOTES:

1. THE AS-BUILT INFORMATION SHOWN HEREON REFLECTS FIELD DATA COLLECTED RELATING TO THE FINAL GRADING OF THE DISTURBED AREA AS OF JANUARY 15, 2015. NAVITUS ENGINEERING IS NOT RESPONSIBLE FOR ANY CHANGES MADE TO THE SITE AFTER THE ABOVE MENTIONED DATE.
2. THE EXISTING CONTAINMENT BERM AROUND THE WELL PAD SHALL BE REPAIRED AS NECESSARY TO ENSURE 100% CONTAINMENT OF ALL FLUIDS PRIOR TO DRILLING OPERATIONS
3. THE EXISTING EGRESSES TO THE WELL PAD SHALL HAVE THE MOUNTABLE BERMS REPAIRED AS NECESSARY TO ENSURE 100% CONTAINMENT OF ALL FLUIDS PRIOR TO DRILLING OPERATIONS.

NAVITUS
ENERGY ENGINEERING

Telephone: (888) 662-4185 | www.NavitusEng.com

Received
NOV 20 2015
Office of Oil and Gas
WV Dept. of Environmental Protection



THIS DOCUMENT WAS PREPARED FOR: ANTERO RESOURCES CORPORATION

COVER SHEET

ROCK RUN & COFOR
WELL PADS & WATER CONTAINMENT PAD
CENTRAL & WEST UNION DISTRICTS
DODDRIDGE COUNTY, WEST VIRGINIA



DATE: 02/16/2015

SCALE: AS SHOWN

SHEET 1 OF 11

01/29/2016