

LATITUDE 39°20'00"


7,060'

LATITUDE 39°17'30" 1,097' TO BOTTOM HOLE

Antero Resources Corporation Well No. Clipper Unit 1H

AS DRILLED DATA: WELL 1H TOP HOLE INFORMATION: N: 296,512ft E: 1,651,033ft LAT: 39°18'27.09" LON: 80°43'59.81" BOTTOM HOLE INFORMATION: N: 283,733ft E: 1,656,824ft LAT: 39°16'21.57" LON: 80°42'43.94" WEST VIRGINIA COORDINATE SYSTEM OF 1927 NORTH ZONE. ZONE WAS DERIVED FROM MEASUREMENTS TAKEN WITH TRIMBLE GEOXT SUBMETER MAPPING GRADE GPS UNIT. PLAT ORIENTATION, CORNER, AND WELL REFERENCE TIE LINES ARE BASED ON GRID NORTH.

(NAD) 83 (UTM) ZONE 17 COORDS: WELL 1H TOP HOLE INFORMATION: N: 4,350,947m E: 523,010m BOTTOM HOLE INFORMATION: N: 4,347,083m E: 524,840m

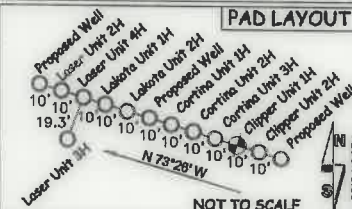

1 WATER WELL WAS LOCATED WITHIN 2000' OF CENTER OF PAD

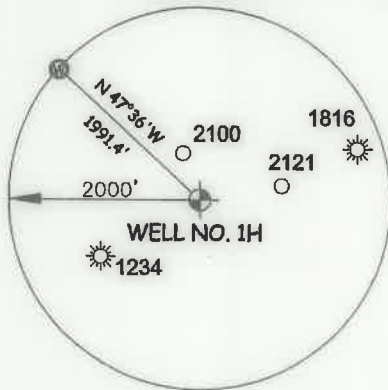


Table listing landowners and lease information for West Union District - Doddridge County, including names like Paul Smith, George Wyckoff, Robert Holland, etc.

Table listing landowners and lease information for West Union District - Doddridge County, including names like David Moore, Doddridge Co. Commission, Ratrie Realty LLC, etc.


Table listing landowners and lease information for West Union District - Doddridge County, including names like Lucien Sammons, David Mitchell, Big "D" Enterp., LLC, etc.

I THE UNDERSIGNED, HEREBY CERTIFY THAT THIS PLAT IS CORRECT TO THE BEST OF MY KNOWLEDGE AND BELIEF AND SHOWS ALL THE INFORMATION REQUIRED BY LAW AND THE RULES ISSUED AND PERSCRIBED BY THE DEPARTMENT OF ENVIRONMENTAL PROTECTION.



STATE OF WEST VIRGINIA, DIVISION OF ENVIRONMENTAL PROTECTION, OFFICE OF OIL AND GAS

WILLOW LAND SURVEYING PLLC 220 MASONIC AVE. PENNSBORO WEST VIRGINIA 26415

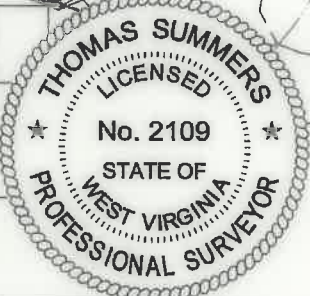

JOB # 18-035WA DRAWING # CLIPPER1HAD SCALE 1" = 2000' MINIMUM DEGREE OF ACCURACY SUBMETER PROVEN SOURCE OF ELEV. SUBMETER MAPPING GRADE GPS.

LEGEND: Surface Owner Boundary Lines +/- Interior Surface Tracts +/- Proposed Well Path As Drilled Well Path

THOMAS SUMMERS P.S. 2109

DATE 06/18/20 OPERATOR'S WELL# CLIPPER UNIT #1H

- NOTE: 1. NO OCCUPIED DWELLINGS OR BUILDINGS TWO THOUSAND FIVE HUNDRED (2,500) SQUARE FEET OR LARGER USED TO HOUSE OR SHELTER DAIRY CATTLE OR POULTRY HUSBANDRY ARE LOCATED WITHIN SIX HUNDRED TWENTY-FIVE (625) FEET OF THE CENTER OF THE WELL PAD. 2. TOP HOLE DATA SHOWN HEREON WAS PROVIDED BY ANTERO RESOURCES CORPORATION. 3. AS DRILLED DATA WAS PROVIDED BY ANTERO RESOURCES CORPORATION. 4. WLS IS NOT CERTIFYING THE DATA AND INFORMATION PROVIDED LISTED IN NOTES 2 AND 3, ONLY THE RELATIONSHIP TO THE DATA AND INFORMATION PROVIDED TO THE LEASE BOUNDARIES. 5. WLS IS BY NO MEANS RESPONSIBLE FOR ANY ERRORS OR INACCURACIES WITH THE DATA AND INFORMATION THAT HAS BEEN PROVIDED.

WELL TYPE: OIL \_\_\_ GAS X LIQUID INJECTION \_\_\_ WASTE DISPOSAL \_\_\_ 47 \_\_\_ 017 \_\_\_ 06887 (IF "GAS") PRODUCTION X STORAGE \_\_\_ DEEP \_\_\_ SHALLOW X STATE COUNTY PERMIT LOCATION: ELEVATION 1,283' -AS-BUILT WATERSHED HEADWATERS MIDDLE ISLAND CREEK QUADRANGLE SMITHBURG 7.5' DISTRICT WEST UNION COUNTY DODDRIDGE

SURFACE OWNER GEORGE S. WYCKOFF ACREAGE 70.58 ACRES +/- OIL & GAS ROYALTY OWNERS: Y.B. CHAPMAN ET UX; JOHNSON B. SMITH ET UX; FANNIE A. COULLEHAN; B.F. HEFLIN JR. ET UX; LEASE ACREAGE 158 AC +/-; 234.94 AC +/-; 82 AC +/-; E.C. JONES ET AL; LEWIS MAXWELL OIL & GAS LLC; MARY F. JONES; WYDNR; FOUR LEAF LAND COMPANY; HOWARD D. SPURLOCK II, ET UX; 300 AC +/-; 54.94 AC +/-; 194 AC +/-; 8.9 AC +/-; 6.24 AC +/-; 1.41 AC +/-; WVSRA; SPERRY HARWOODS; RONALD G. STUTLER; A. E. FITZWILLIAMS ET AL; HUGH SPENCER ET UX; 301.19 AC +/-; 29.83 AC +/-; 25.56 AC +/-; 138.5 AC +/-; 132 AC +/-

PROPOSED WORK: DRILL \_\_\_ CONVERT \_\_\_ DRILL DEEPER \_\_\_ REDRILL \_\_\_ FRACTURE OR STIMULATE \_\_\_ PLUG OFF OLD FORMATION \_\_\_ PERFORATE NEW FORMATION \_\_\_ OTHER PHYSICAL CHANGE IN WELL (SPECIFY) AS DRILLED PLUG & ABANDON CLEAN OUT & REPLUG TARGET FORMATION MARCELLUS ESTIMATED DEPTH 6,933' TVD 21,415' MD WELL OPERATOR ANTERO RESOURCES CORP. DESIGNATED AGENT DIANNA STAMPER - CT CORPORATION SYSTEM ADDRESS 1615 WYNKOOP ST. ADDRESS 5400 D BIG TYLER ROAD FORM WW-6 DENVER, CO 80202 CHARLESTON, WV 25313

WV NORTH ZONE GRID NORTH

6,924' TO BOTTOM HOLE

9,401'

LONGITUDE 80°42'30"

LONGITUDE 80°42'30"

COUNTY NAME

PERMIT

LATITUDE 39°20'00"


7,060'

LATITUDE 39°17'30" 1,097' TO BOTTOM HOLE

Antero Resources Corporation Well No. Clipper Unit 1H

AS DRILLED DATA: WELL 1H TOP HOLE INFORMATION: N: 296,512ft E: 1,651,033ft LAT: 39°18'27.09" LON: 80°43'59.81" BOTTOM HOLE INFORMATION: N: 283,733ft E: 1,656,824ft LAT: 39°16'21.57" LON: 80°42'43.94" WEST VIRGINIA COORDINATE SYSTEM OF 1927 NORTH ZONE. ZONE WAS DERIVED FROM MEASUREMENTS TAKEN WITH TRIMBLE GEOXT SUBMETER MAPPING GRADE GPS UNIT. PLAT ORIENTATION, CORNER, AND WELL REFERENCE TIE LINES ARE BASED ON GRID NORTH.

(NAD) 83 (UTM) ZONE 17 COORDS: WELL 1H TOP HOLE INFORMATION: N: 4,350,947m E: 523,010m BOTTOM HOLE INFORMATION: N: 4,347,083m E: 524,840m

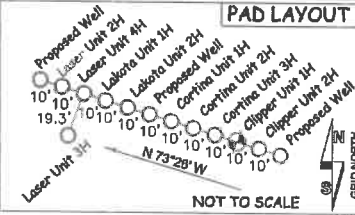

1 WATER WELL WAS LOCATED WITHIN 2000' OF CENTER OF PAD

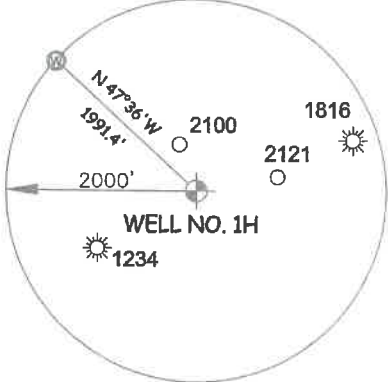



Table listing lease owners and well numbers in the West Union District - Doddridge County, including names like Paul Smith, George Wyckoff, and Spencer Enterp. LLC.

Table listing lease owners and well numbers in the West Union District - Doddridge County, including names like Lucien Sammons, David Mitchell, and Robert Bland.

I THE UNDERSIGNED, HEREBY CERTIFY THAT THIS PLAT IS CORRECT TO THE BEST OF MY KNOWLEDGE AND BELIEF AND SHOWS ALL THE INFORMATION REQUIRED BY LAW AND THE RULES ISSUED AND PERSCRIBED BY THE DEPARTMENT OF ENVIRONMENTAL PROTECTION.



STATE OF WEST VIRGINIA, DIVISION OF ENVIRONMENTAL PROTECTION, OFFICE OF OIL AND GAS. WILLOW LAND SURVEYING PLLC 220 MASONIC AVE. PENNSBORO WEST VIRGINIA 26415

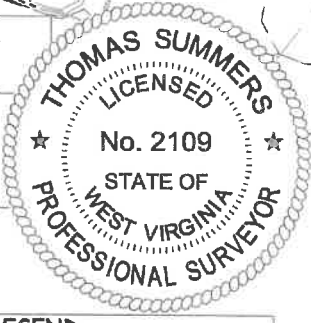

JOB # 18-035WA DRAWING # CLIPPER1HAD SCALE 1" = 2000' MINIMUM DEGREE OF ACCURACY SUBMETER PROVEN SOURCE OF ELEV. SUBMETER MAPPING GRADE GPS STATE OF WEST VIRGINIA DEPARTMENT OF ENERGY DIVISION OF OIL AND GAS

LEGEND: Surface Owner Boundary Lines +/-, Interior Surface Tracts +/-, Proposed Well Path, As Drilled Well Path. THOMAS SUMMERS P.S. 2109 DATE 06/18/20 OPERATOR'S WELL# CLIPPER UNIT #1H

- NOTES: 1. NO OCCUPIED DWELLINGS OR BUILDINGS TWO THOUSAND FIVE HUNDRED (2,500) SQUARE FEET OR LARGER USED TO HOUSE OR SHELTER DAIRY CATTLE OR POULTRY HUSBANDRY ARE LOCATED WITHIN SIX HUNDRED TWENTY-FIVE (625) FEET OF THE CENTER OF THE WELL PAD. 2. TOP HOLE DATA SHOWN HEREON WAS PROVIDED BY ANTERO RESOURCES CORPORATION. 3. AS DRILLED DATA WAS PROVIDED BY ANTERO RESOURCES CORPORATION. 4. WLS IS NOT CERTIFYING THE DATA AND INFORMATION PROVIDED LISTED IN NOTES 2 AND 3, ONLY THE RELATIONSHIP TO THE DATA AND INFORMATION PROVIDED TO THE LEASE BOUNDARIES. 5. WLS IS BY NO MEANS RESPONSIBLE FOR ANY ERRORS OR INACCURACIES WITH THE DATA AND INFORMATION THAT HAS BEEN PROVIDED.

WELL TYPE: OIL GAS X LIQUID INJECTION WASTE DISPOSAL 47 017 06887 (IF "GAS") PRODUCTION X STORAGE DEEP SHALLOW X STATE COUNTY PERMIT LOCATION: ELEVATION 1,283' -AS-BUILT WATERSHED HEADWATERS MIDDLE ISLAND CREEK QUADRANGLE SMITHBURG 7.5 DISTRICT WEST UNION COUNTY DODDRIDGE SURFACE OWNER GEORGE S. WYCKOFF ACREAGE 70.58 ACRES +/- OIL & GAS ROYALTY OWNER V.B. CHAPMAN ET UX; JOHNSON B. SMITH ET UX; FANNIE A. COULEHAN; B. F. HEFLIN JR. ET UX; LEASE ACREAGE 156 AC +/-; 180 AC +/-; 234.94 AC +/-; 82 AC +/-; E.C. JONES ET AL.; LEWIS MAXWELL OIL & GAS LLC; MARY F. JONES; WVDNR; FOUR LEAF LAND COMPANY; HOWARD D. SPURLOCK II ET UX 300 AC +/-; 54.94 AC +/-; 194 AC +/-; 8.9 AC +/-; 6.24 AC +/-; 1.41 AC +/-; WVSRA; SPERRY HARWOODS; RONALD G. STUTLER; A. E. FITZWILLIAMS ET AL.; HUGH SPENCER ET UX 301.19 AC +/-; 29.63 AC +/-; 25.56 AC +/-; 138.5 AC +/-; 132 AC +/- PROPOSED WORK: DRILL CONVERT DRILL DEEPER REDRILL FRACTURE OR STIMULATE PLUG OFF OLD FORMATION PERFORATE NEW FORMATION OTHER PHYSICAL CHANGE IN WELL (SPECIFY) AS DRILLED PLUG & ABANDON CLEAN OUT & REPLUG TARGET FORMATION MARCELLUS ESTIMATED DEPTH 6,933' TVD 21,415' MD WELL OPERATOR ANTERO RESOURCES CORP. DESIGNATED AGENT DIANNA STAMPER - CT CORPORATION SYSTEM ADDRESS 1615 WYNKOOP ST. ADDRESS 5400 D BIG TYLER ROAD DENVER, CO 80202 CHARLESTON, WV 25313

6,924' TO BOTTOM HOLE

LONGITUDE 80°42'30"

LONGITUDE 80°42'30"

COUNTY NAME PERMIT