



4701706993

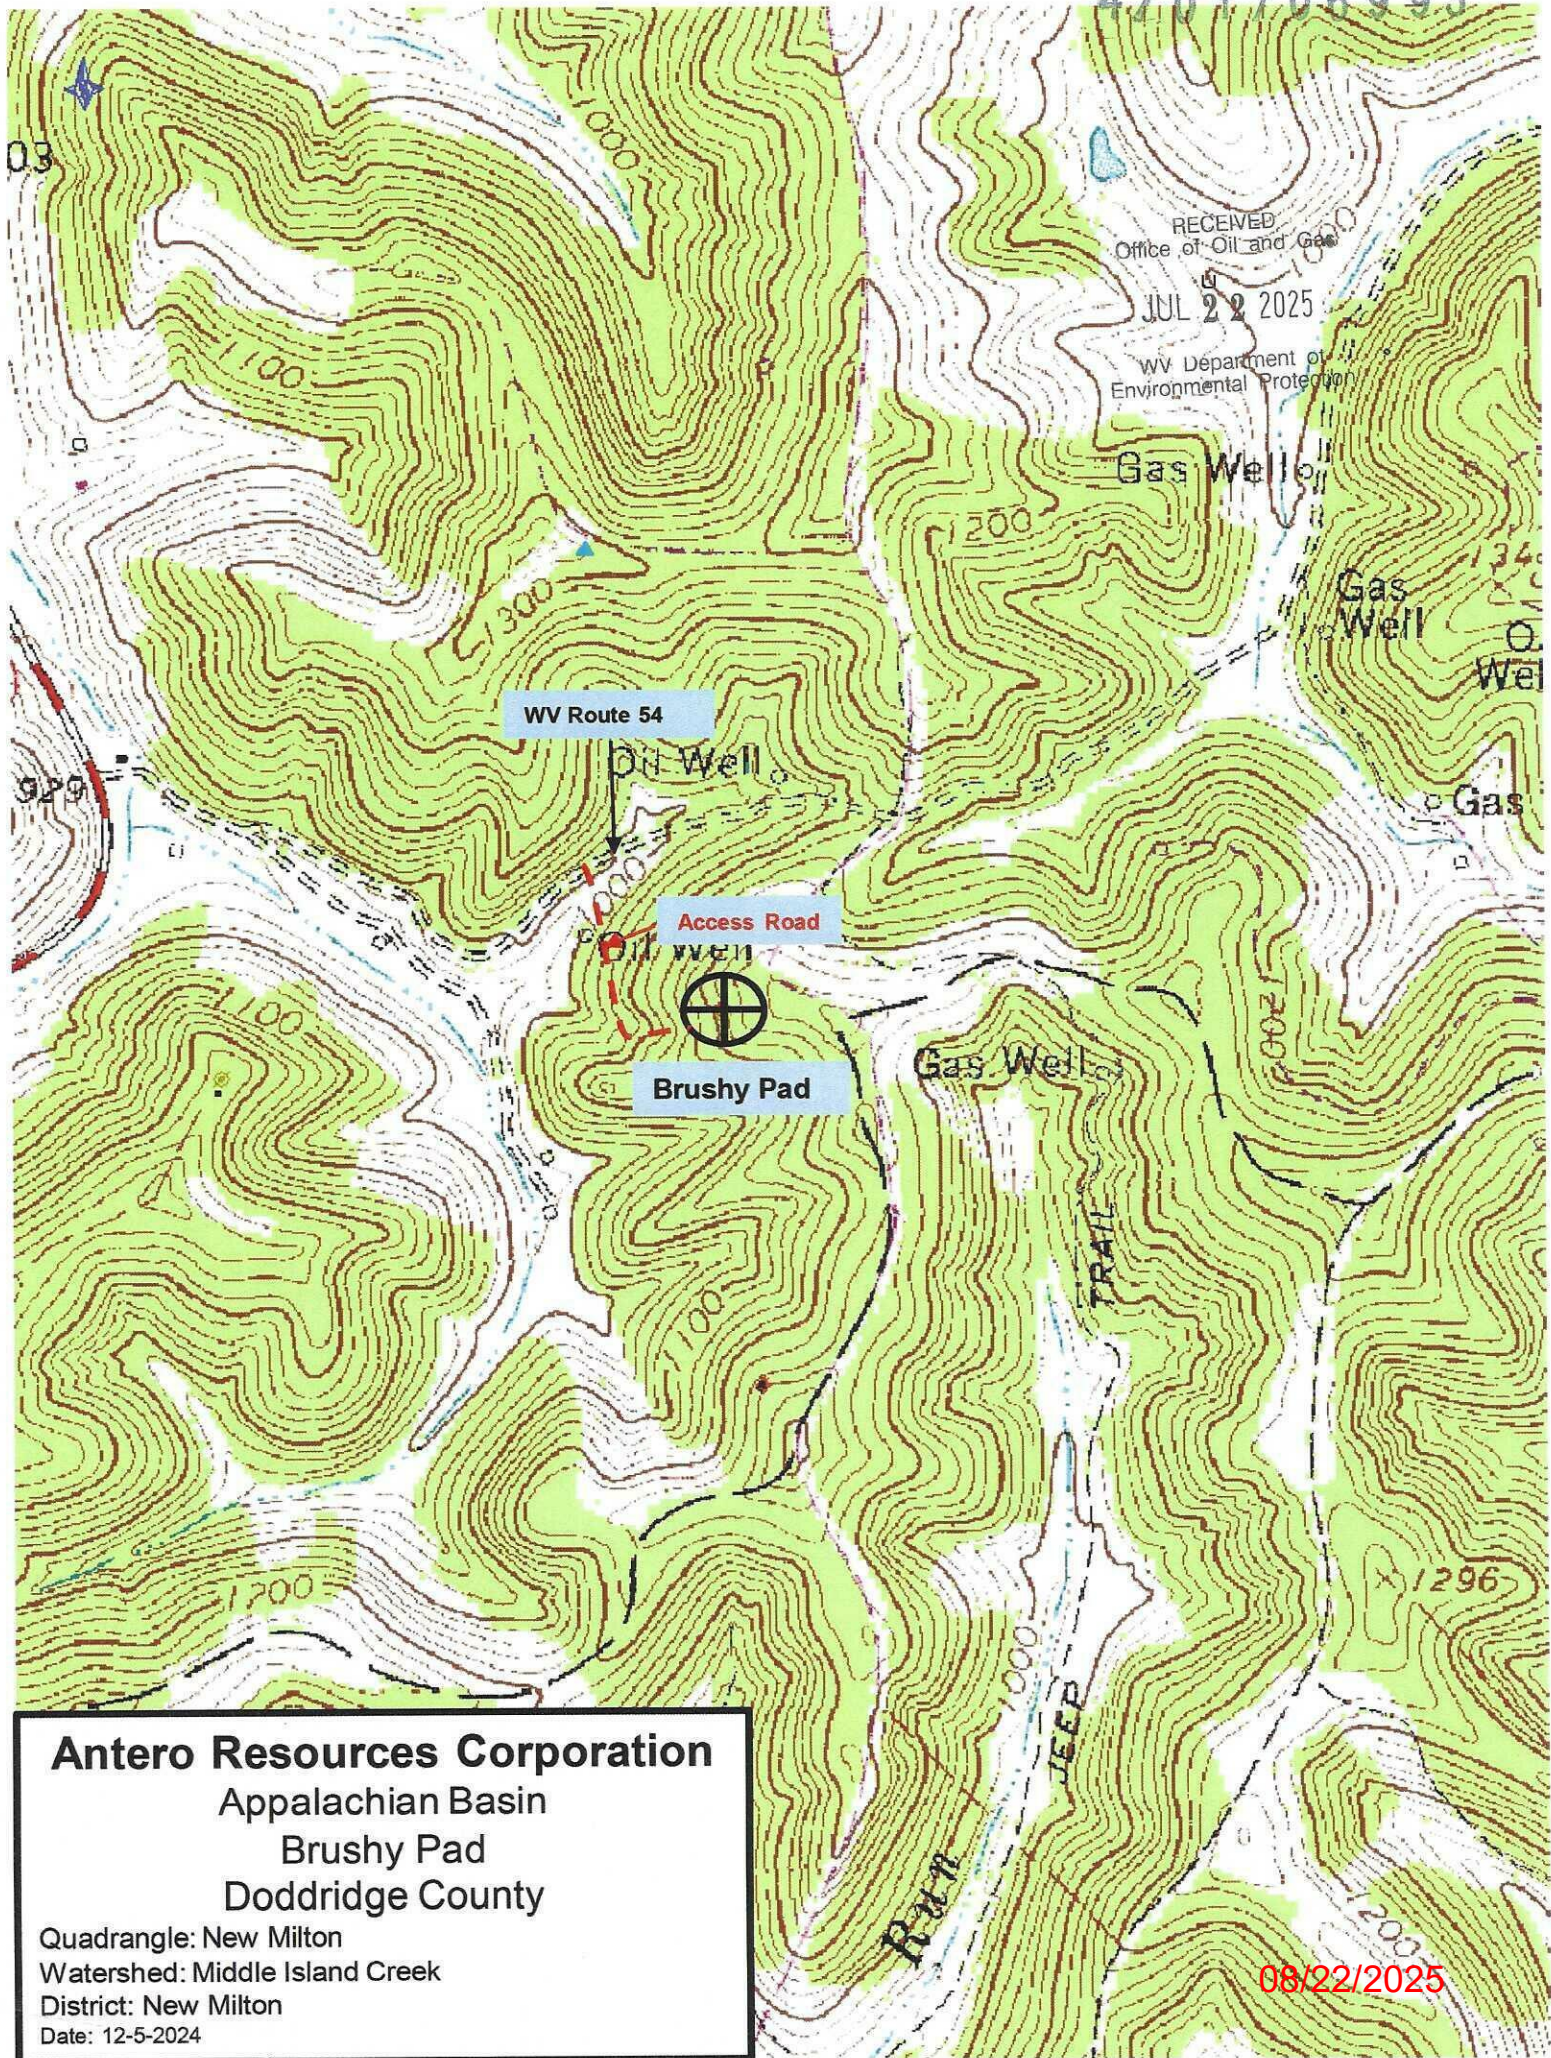

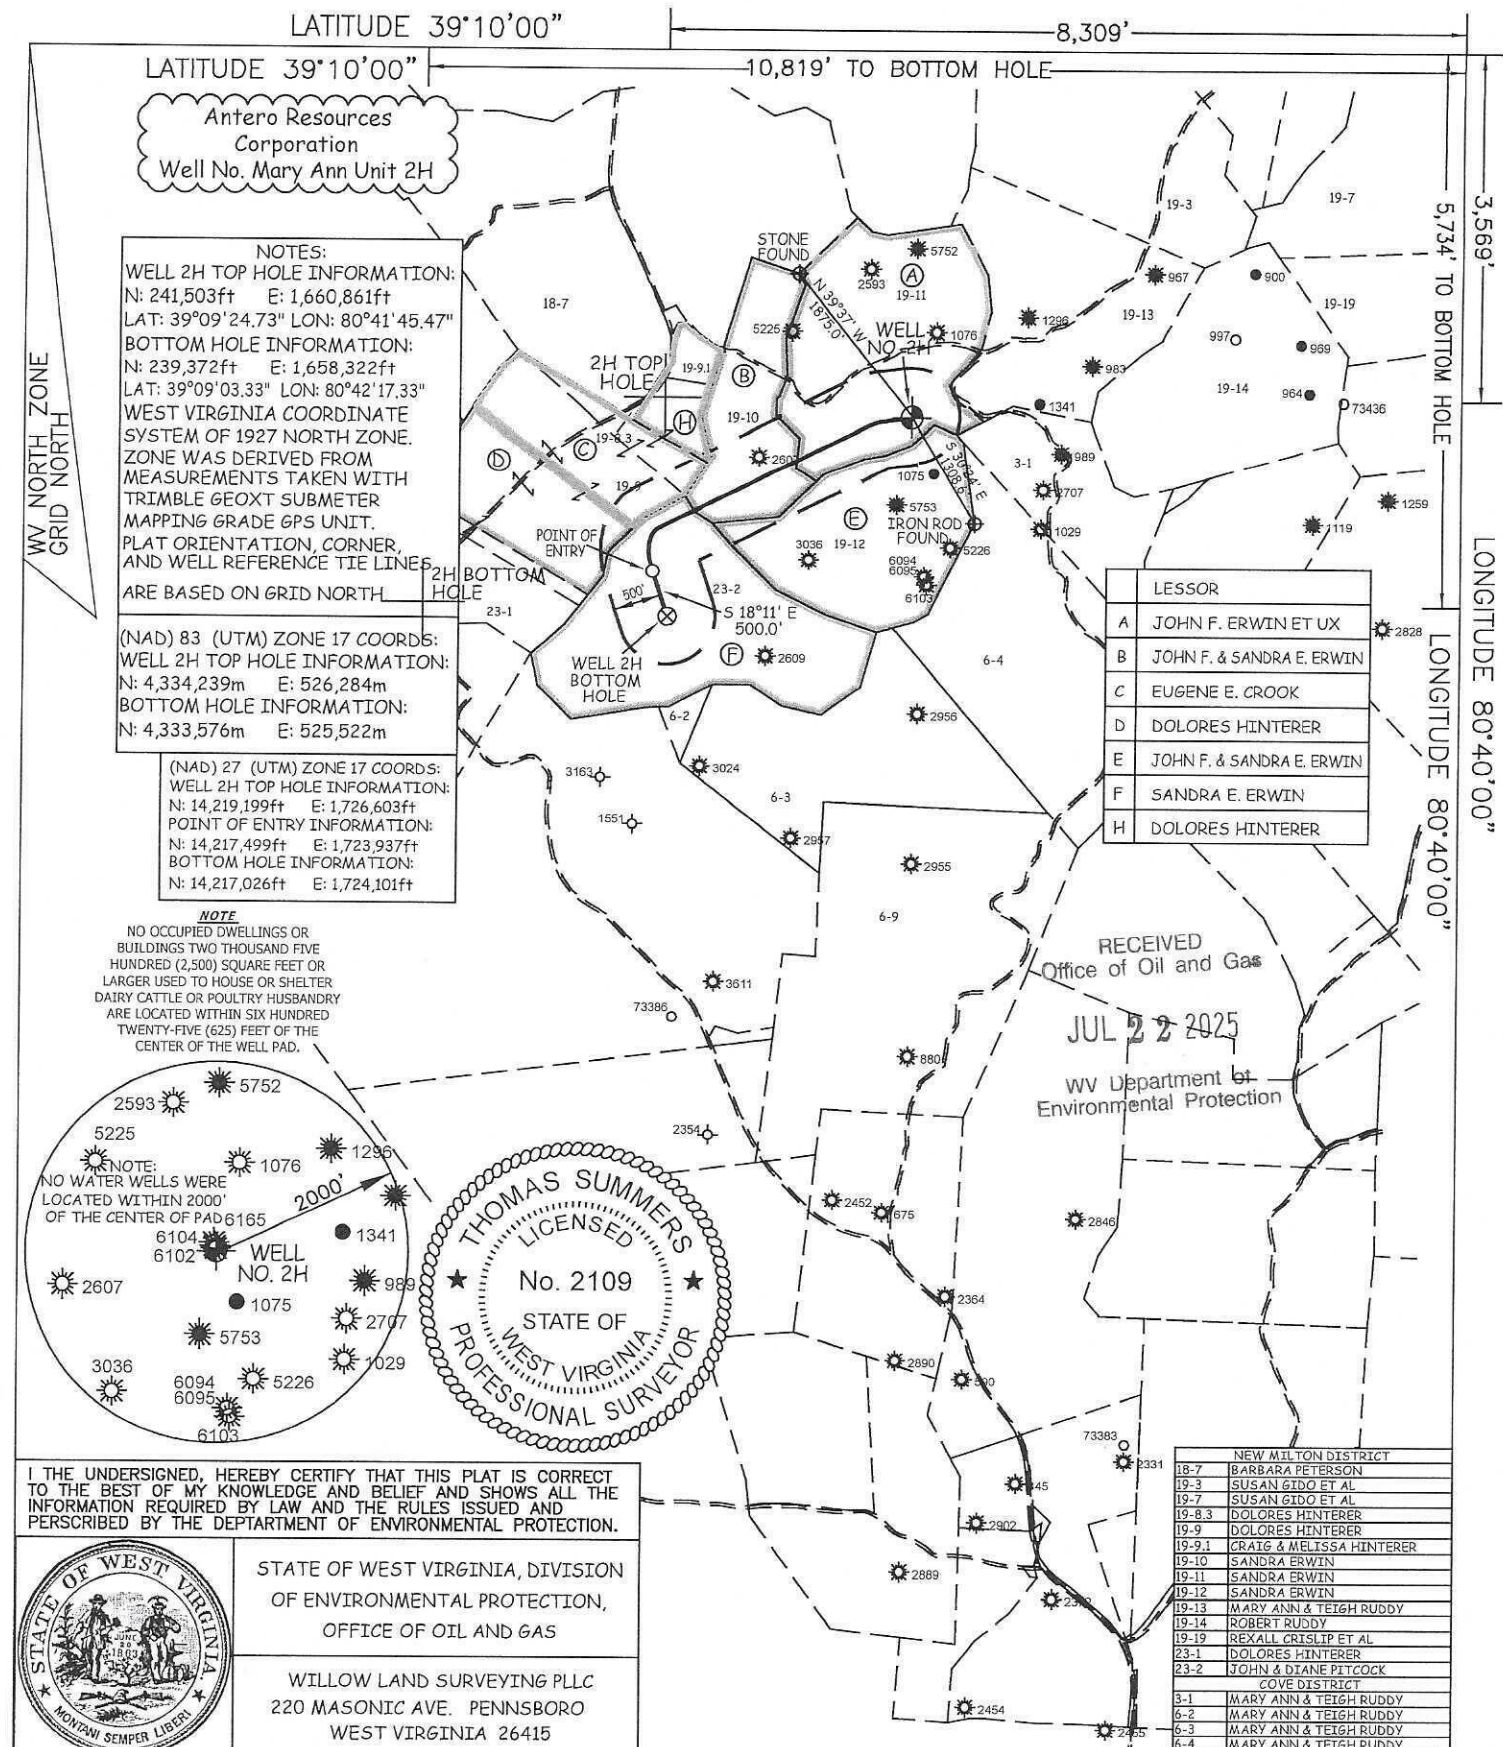

JOB # 25-015WA  
DRAWING # MARYANN2H  
SCALE 1" = 2000'  
MINIMUM DEGREE OF ACCURACY SUBMETER  
PROVEN SOURCE OF ELEV. SUBMETER MAPPING GRADE GPS

STATE OF WEST VIRGINIA  
DEPARTMENT OF ENERGY  
DIVISION OF OIL AND GAS

LEGEND

- Surface Owner Boundary Lines +/-
- Adjoining Surface Tracts +/-
- Found monument, as noted

THOMAS SUMMERS P.S. 2109

DATE 07/16/25  
OPERATOR'S WELL# MARY ANN UNIT #2H

PAD LAYOUT

NOT TO SCALE

REFERENCES

STAKE/NAIL, SET

WELL NO. 2H

STAKE/NAIL, SET 1" = 300'

WELL TYPE: OIL ☐ GAS ☒ LIQUID INJECTION ☐ WASTE DISPOSAL ☐  
(IF "GAS") PRODUCTION ☒ STORAGE ☐ DEEP ☐ SHALLOW ☒  
LOCATION: ELEVATION ASBUILT - 1,213' WATERSHED HEADWATERS MIDDLE ISLAND CREEK STATE COUNTY PERMIT  
QUADRANGLE NEW MILTON 7.5' DISTRICT NEW MILTON COUNTY DODDRIDGE  
SURFACE OWNER SANDRA E. ERWIN ACREAGE 104 ACRES +/-  
OIL & GAS ROYALTY OWNER JOHN F. ERWIN ET UX LEASE ACREAGE 104 ACRES+  
PROPOSED WORK: DRILL ☒ CONVERT ☐ DRILL DEEPER ☐ REDRILL ☐ FRACTURE OR  
STIMULATE ☒ PLUG OFF OLD FORMATION ☐ PERFORATE NEW FORMATION ☒  
OTHER PHYSICAL CHANGE IN WELL (SPECIFY)  
PLUG & ABANDON ☐ CLEAN OUT & REPLUG ☐ ESTIMATED DEPTH 7,700' TVD 11,800' MD  
TARGET FORMATION MARCELLUS  
WELL OPERATOR ANTERO RESOURCES CORP. DESIGNATED AGENT CONRAD BASTON  
ADDRESS 1615 WYNKOOP STREET ADDRESS 535 WHITE OAK BLVD.  
DENVER, CO 80202 BRIDGEPORT, WV 26330

FORM WW-6