

4701706994

RECEIVED
Office of Oil and Gas

JUL 22 2025

WV Department of
Environmental Protection

Gas Well

Gas Well

Well

Gas

WV Route 54

Oil Well

Access Road

WV 7

Brushy Pad

Gas Well

TRAIL

1296

Antero Resources Corporation

Appalachian Basin

Brushy Pad

Doddridge County

Quadrangle: New Milton

Watershed: Middle Island Creek

District: New Milton

Date: 12-5-2024

08/22/2025

RECEIVED
Office of Oil and Gas

JUL 22 2025

WV Department of
Environmental Protection



Antero Resources
Corporation
Well No. Wysong Unit 1H

NOTES:
WELL 1H TOP HOLE INFORMATION:
N: 241,488ft E: 1,660,864ft
LAT: 39°09'24.59" LON: 80°41'45.43"
BOTTOM HOLE INFORMATION:
N: 238,179ft E: 1,659,578ft
LAT: 39°08'51.71" LON: 80°42'01.19"
WEST VIRGINIA COORDINATE
SYSTEM OF 1927 NORTH ZONE.
ZONE WAS DERIVED FROM
MEASUREMENTS TAKEN WITH
TRIMBLE GEOXT SUBMETER
MAPPING GRADE GPS UNIT.
PLAT ORIENTATION, CORNER,
AND WELL REFERENCE TIE LINES
ARE BASED ON GRID NORTH.

(NAD) 83 (UTM) ZONE 17 COORDS:
WELL 1H TOP HOLE INFORMATION:
N: 4,334,234m E: 526,285m
BOTTOM HOLE INFORMATION:
N: 4,333,219m E: 525,910m

(NAD) 27 (UTM) ZONE 17 COORDS:
WELL 1H TOP HOLE INFORMATION:
N: 14,219,184ft E: 1,726,606ft
POINT OF ENTRY INFORMATION:
N: 14,216,327ft E: 1,725,212ft
BOTTOM HOLE INFORMATION:
N: 14,215,855ft E: 1,725,376ft

NOTE
NO OCCUPIED DWELLINGS OR
BUILDINGS TWO THOUSAND FIVE
HUNDRED (2,500) SQUARE FEET OR
LARGER USED TO HOUSE OR SHELTER
DAIRY CATTLE OR POULTRY HUSBANDRY
ARE LOCATED WITHIN SIX HUNDRED
TWENTY-FIVE (625) FEET OF THE
CENTER OF THE WELL PAD.

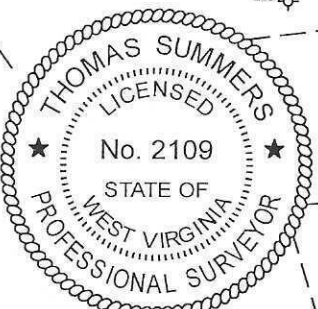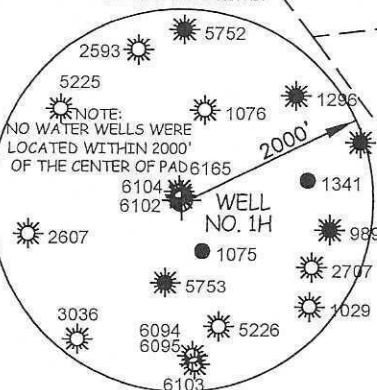

I THE UNDERSIGNED, HEREBY CERTIFY THAT THIS PLAT IS CORRECT
TO THE BEST OF MY KNOWLEDGE AND BELIEF AND SHOWS ALL THE
INFORMATION REQUIRED BY LAW AND THE RULES ISSUED AND
PRESCRIBED BY THE DEPARTMENT OF ENVIRONMENTAL PROTECTION.





STATE OF WEST VIRGINIA, DIVISION
OF ENVIRONMENTAL PROTECTION,
OFFICE OF OIL AND GAS

WILLOW LAND SURVEYING PLLC
220 MASONIC AVE. PENNSBORO
WEST VIRGINIA 26415

JOB # 25-011WA
DRAWING # WYSONG1H
SCALE 1" = 2000'
MINIMUM DEGREE OF
ACCURACY SUBMETER
PROVEN SOURCE OF ELEV.
SUBMETER MAPPING GRADE GPS

LEGEND
— — — Surface Owner Boundary Lines +/-
- - - - - Adjoining Surface Tracts +/-
⊕ Found monument, as noted
THOMAS SUMMERS P.S. 2109

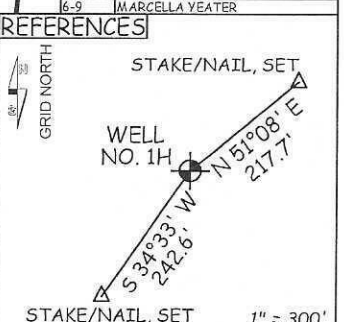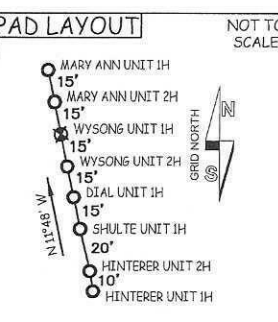

STATE OF WEST VIRGINIA
DEPARTMENT OF ENERGY
DIVISION OF OIL AND GAS

DATE 07/16/25
OPERATOR'S WELL# WYSONG UNIT #1H

WELL TYPE: OIL ☐ GAS ☒ LIQUID INJECTION ☐ WASTE DISPOSAL ☐	API WELL # 47 - 017 - 06994
(IF "GAS") PRODUCTION ☒ STORAGE ☐ DEEP ☐ SHALLOW ☒	
LOCATION: ELEVATION ASBUILT - 1,213' WATERSHED HEADWATERS MIDDLE ISLAND CREEK STATE COUNTY PERMIT	
QUADRANGLE NEW MILTON 7.5' DISTRICT NEW MILTON COUNTY DODDRIDGE	
SURFACE OWNER SANDRA E. ERWIN ACREAGE 104 ACRES +/-	
OIL & GAS ROYALTY OWNER JOHN F. ERWIN ET UX LEASE ACREAGE 104 ACRES +/-	08/22/2025
PROPOSED WORK: DRILL ☒ CONVERT ☐ DRILL DEEPER ☐ REDRILL ☐ FRACTURE OR STIMULATE ☒ PLUG OFF OLD FORMATION ☐ PERFORATE NEW FORMATION ☒	
OTHER PHYSICAL CHANGE IN WELL (SPECIFY)	
PLUG & ABANDON ☐ CLEAN OUT & REPLUG ☐ ESTIMATED DEPTH 7,700' TVD 11,900' MD	
TARGET FORMATION MARCELLUS	
WELL OPERATOR ANTERO RESOURCES CORP. DESIGNATED AGENT CONRAD BASTON	
ADDRESS 1615 WYNKOOP STREET ADDRESS 535 WHITE OAK BLVD.	
DENVER, CO 80202 BRIDGEPORT, WV 26330	