


Antero Resources Corporation
 Appalachian Basin
 Brushy Pad
 Doddridge County

Quadrangle: New Milton
 Watershed: Middle Island Creek
 District: New Milton
 Date: 12-5-2024

Quadrangle: New Milton
Watershed: Middle Island Creek
District: New Milton
Date: 12-5-2024

09/05/2025

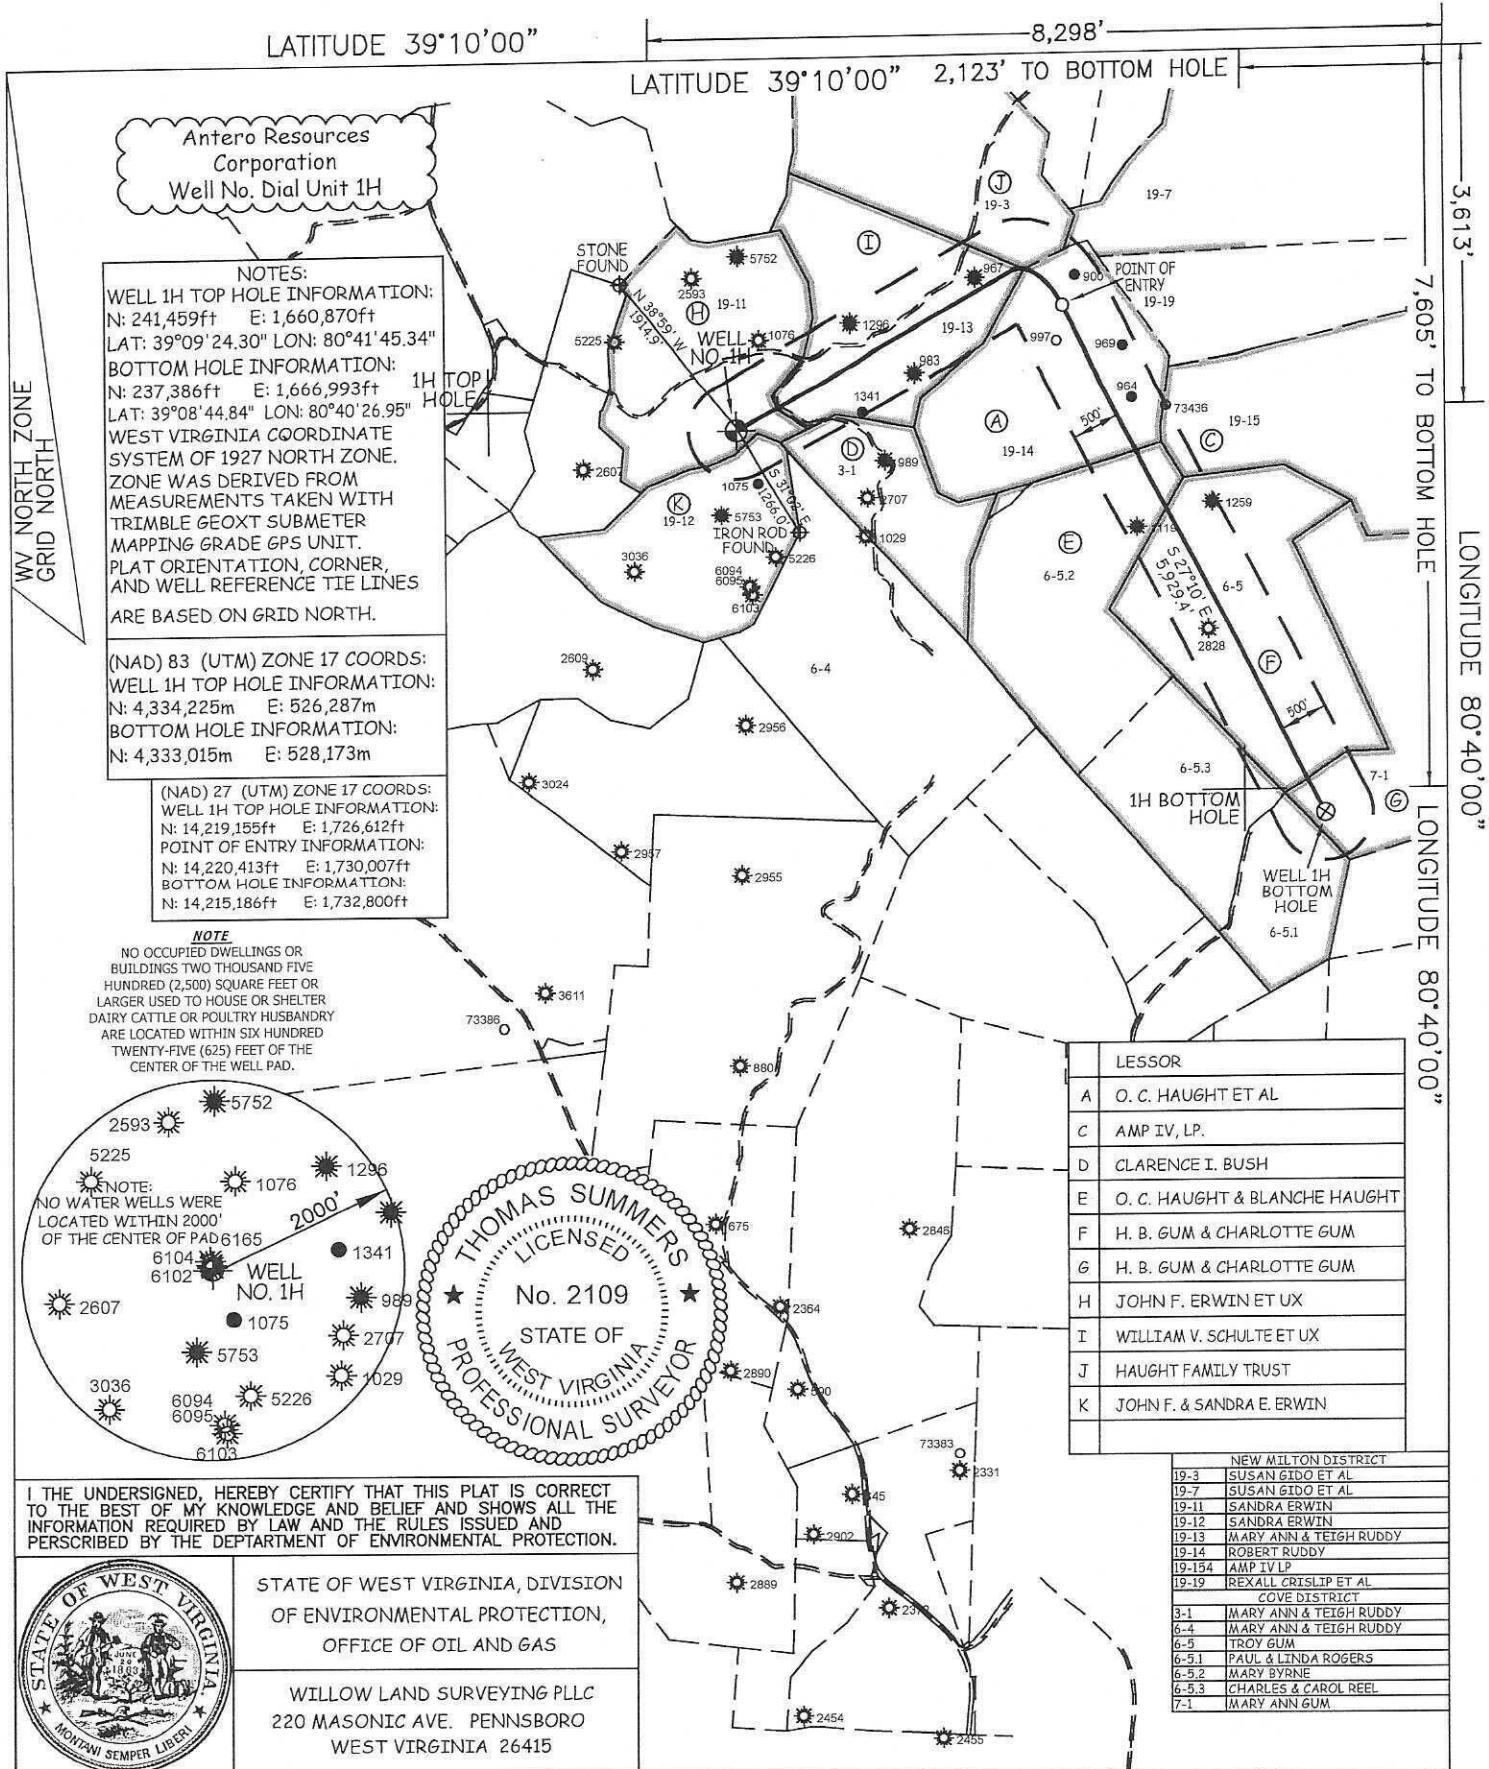

JOB # 25-011WA DRAWING # DIAL 1H SCALE 1" = 2000' MINIMUM DEGREE OF ACCURACY SUBMETER PROVEN SOURCE OF ELEV. SUBMETER MAPPING GRADE GPS	LEGEND — Surface Owner Boundary Lines +/- --- Adjoining Surface Tracts +/- ⊕ Found monument, as noted THOMAS SUMMERS P.S. 2109 DATE 07/23/25 OPERATOR'S WELL# DIAL UNIT #1H	PAD LAYOUT 	NOT TO SCALE GRID NORTH STAKE/NAIL, SET WELL NO. 1H STAKE/NAIL, SET 1" = 300'	REFERENCES STAKE/NAIL, SET WELL NO. 1H STAKE/NAIL, SET 1" = 300'
WELL TYPE: OIL ☐ GAS ☒ LIQUID INJECTION ☐ WASTE DISPOSAL ☐ (IF "GAS") PRODUCTION ☒ STORAGE ☐ DEEP ☐ SHALLOW ☒ LOCATION: ELEVATION ASBUILT - 1,213' WATERSHED HEADWATERS MIDDLE ISLAND CREEK STATE COUNTY PERMIT QUADRANGLE NEW MILTON 7.5' DISTRICT NEW MILTON COUNTY DODDRIDGE SURFACE OWNER SANDRA E. ERWIN ACREAGE 104 ACRES +/- OIL & GAS ROYALTY OWNER JOHN F. ERWIN ET UX LEASE ACREAGE 104 ACRES PROPOSED WORK: DRILL ☒ CONVERT ☐ DRILL DEEPER ☐ REDRILL ☐ FRACTURE OR STIMULATE ☒ PLUG OFF OLD FORMATION ☐ PERFORATE NEW FORMATION ☒ OTHER PHYSICAL CHANGE IN WELL (SPECIFY) PLUG & ABANDON ☐ CLEAN OUT & REPLUG ☐ ESTIMATED DEPTH 7,700' TVD 18,200' MD TARGET FORMATION MARCELLUS WELL OPERATOR ANTERO RESOURCES CORP. DESIGNATED AGENT CONRAD BASTON ADDRESS 1615 WYNKOOP STREET ADDRESS 535 WHITE OAK BLVD. DENVER, CO 80202 BRIDGEPORT, WV 26330				

FORM WW-6