


Latitude 39° 20'

Longitude 80° 15'

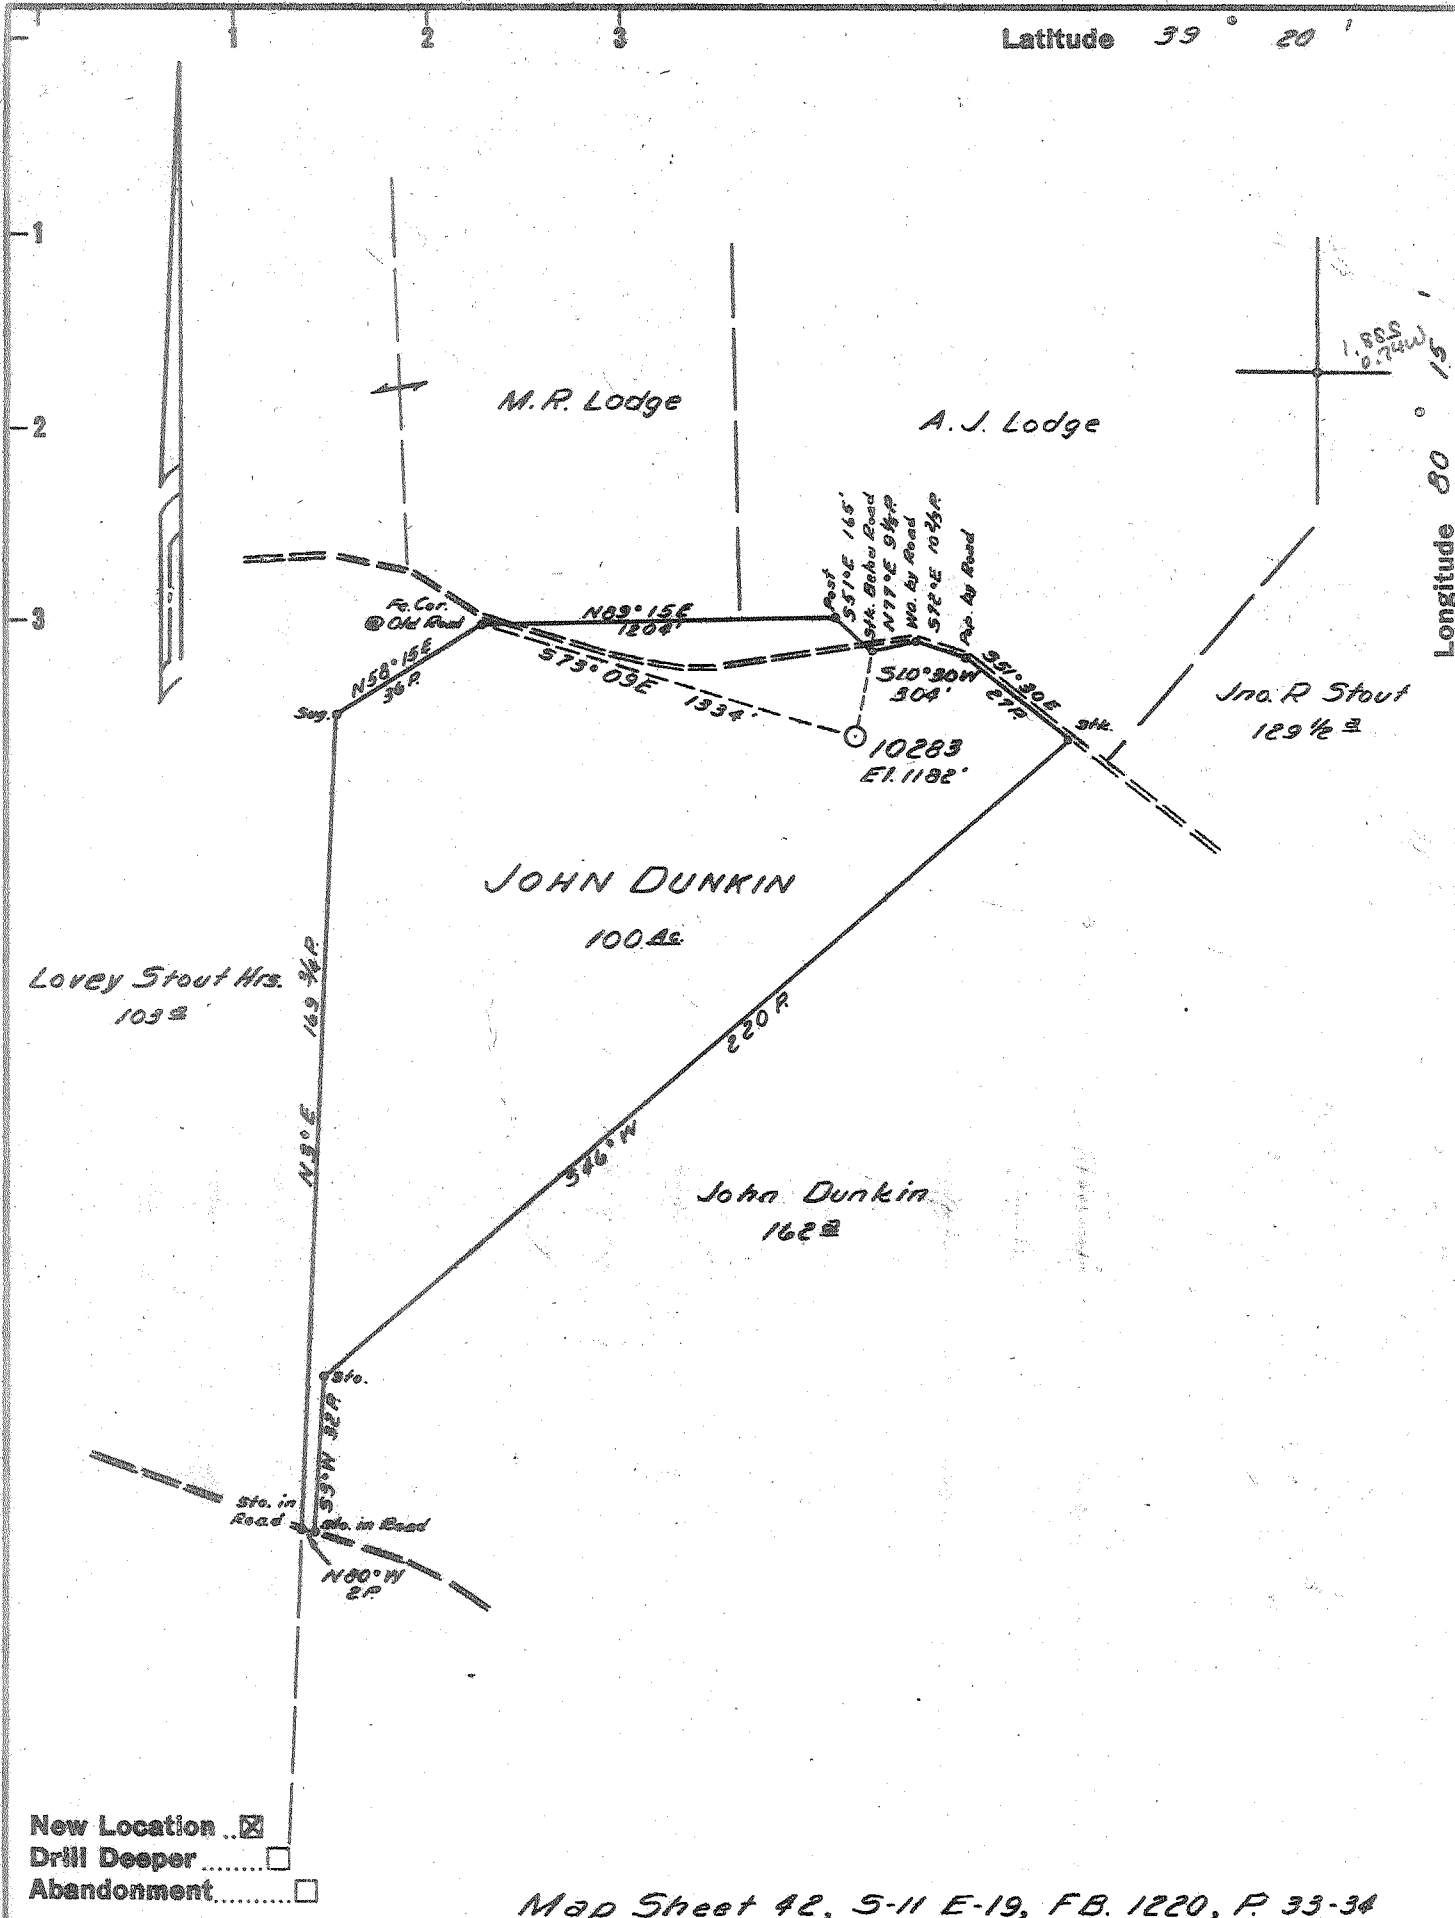

Map Sheet 42, 5-11 E-19, F.B. 1220, P. 33-34

Company HOPE NATURAL GAS CO.
 Address CLARKSBURG, W.VA.
 Farm JOHN DUNKIN
 Tract _____ Acres 100 Lease No. 17566
 Well (Farm) No. _____ Serial No. 10283
 Elevation (Spirit Level) 1182'
 Quadrangle CLARKSBURG - (SE)
 County HARRISON District SIMPSON
 Engineer Guy H. Bradley
 Engineer's Registration No. 2425
 File No. _____ Drawing No. _____
 Date 4/22/60 Scale 1" = 40 FEET

STATE OF WEST VIRGINIA
 DEPARTMENT OF MINES
 OIL AND GAS DIVISION
 CHARLESTON

WELL LOCATION MAP

FILE NO. HAR-218 -

Cancelled

+ Denotes location of well on United States Topographic Maps, scale 1 to 62,500, latitude and longitude lines being represented by border lines as shown.

- Denotes one inch spaces on border line of original tracing.