


12-1-71-1547

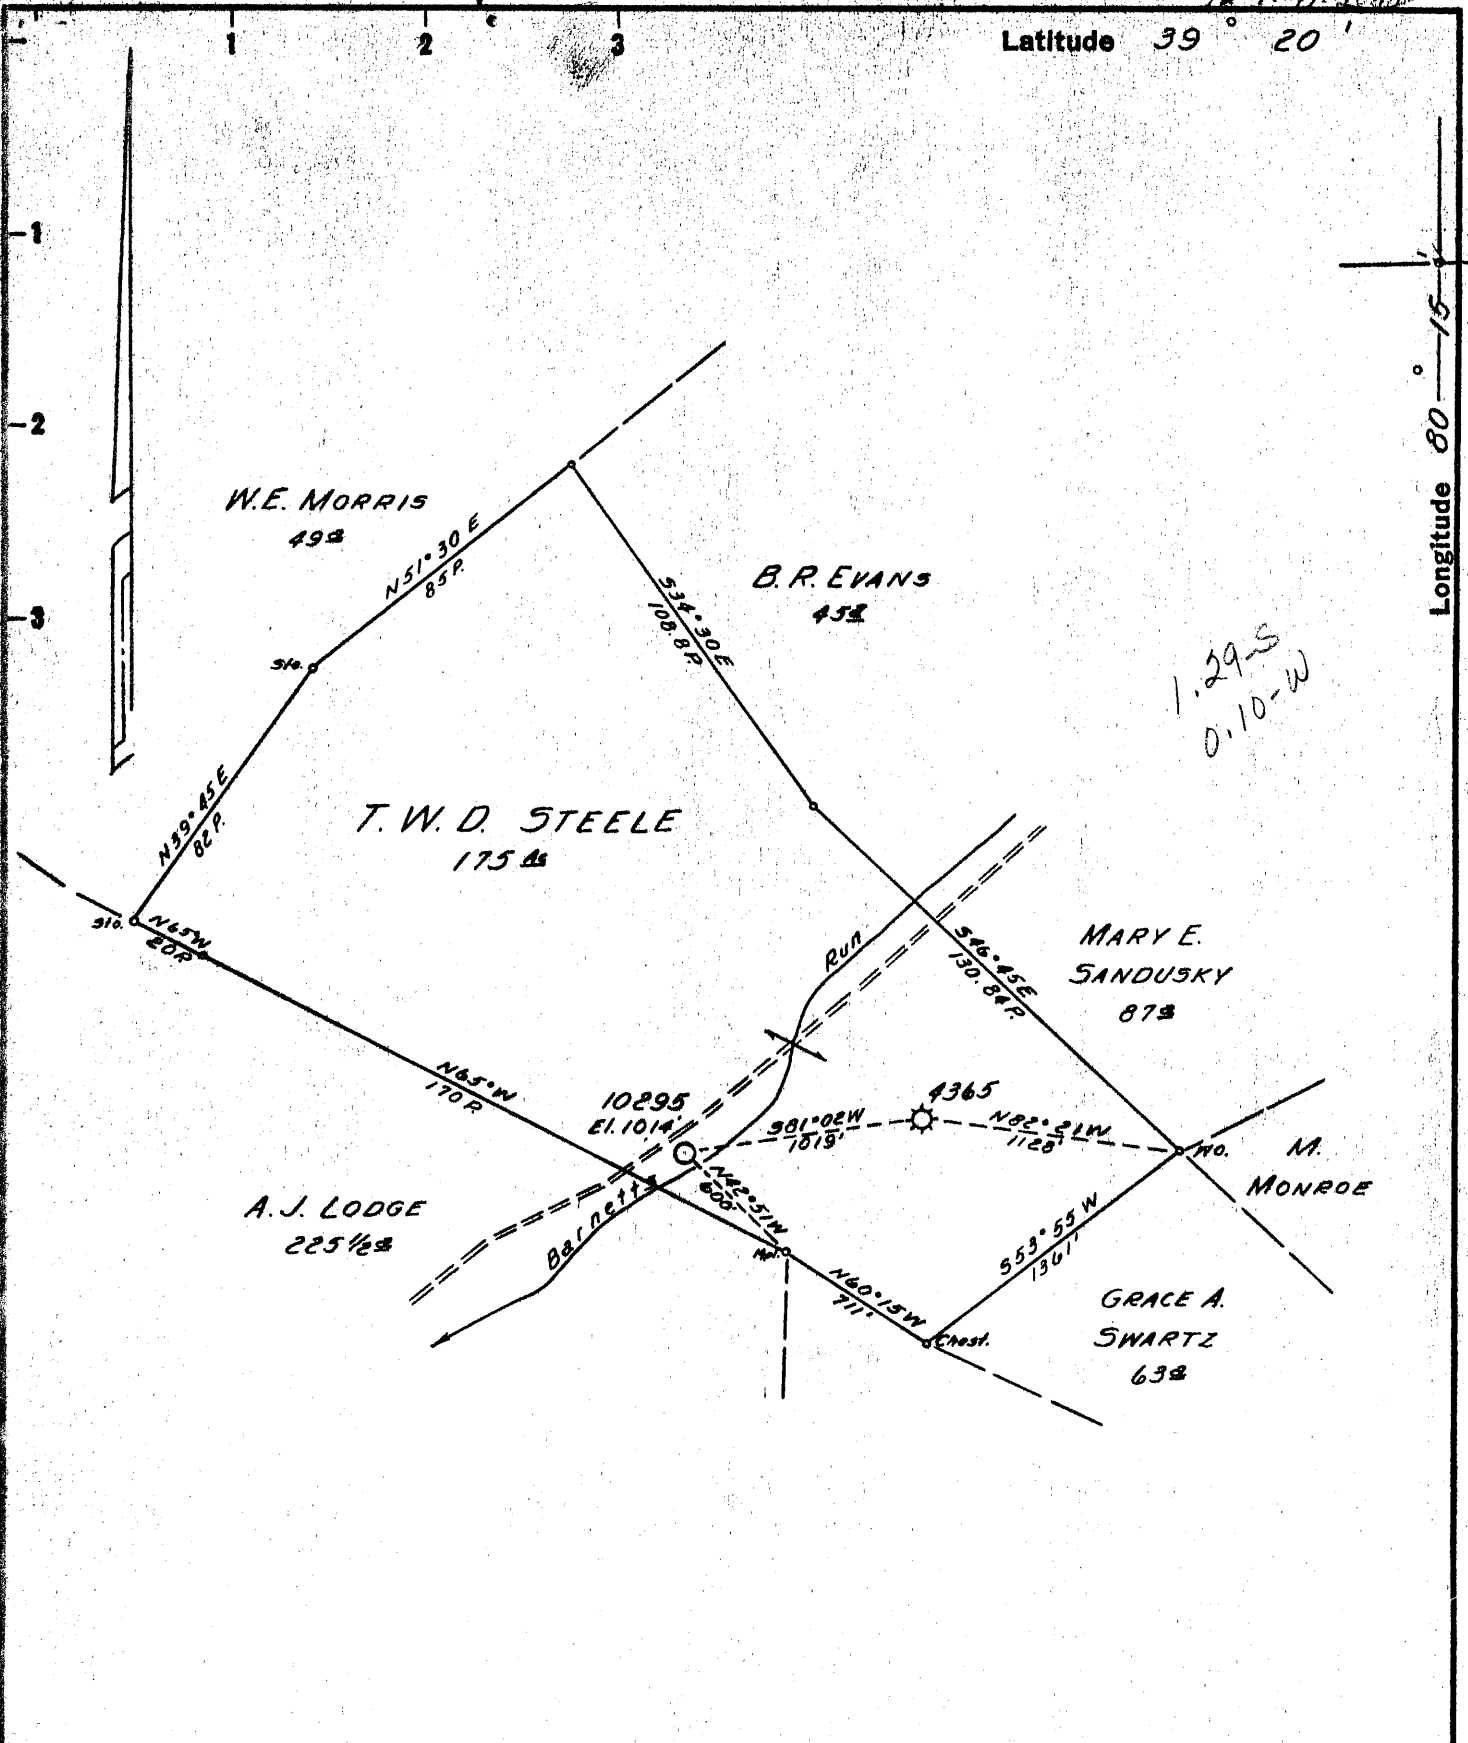

1.29-5
0.10-W

~~Now Location~~
 Drill Deeper
 Abandonment issued 12-1-71
 Map Sheet 42, S-10 E-20, F.B. 1233 P 143

Company Consolidated Gas Supply Corp.
Home NAT GAS CO.
 Address CLARKSBURG W.VA. 26301

Farm T.W.D. STEELE

Tract _____ Acres 175 Lease No. 13073

Well (Farm) No. _____ Serial No. 10295

Elevation (Split Level) 1014'

Quadrangle CLARKSBURG SE

County HARRISON District SIMPSON

Engineer Guy H Bradley

Engineer's Registration No. 2425

File No. _____ Drawing No. _____

Date 7/14/60 Scale 1"=50 Poles


STATE OF WEST VIRGINIA
 DEPARTMENT OF MINES
 OIL AND GAS DIVISION
 CHARLESTON

WELL LOCATION MAP
 FILE NO. HAR-221-P

+ Denotes location of well on United States Topographic Maps, scale 1 to 62,500, latitude and longitude lines being represented by border lines as shown.

- Denotes one inch spaces on border line of original tracing.

M

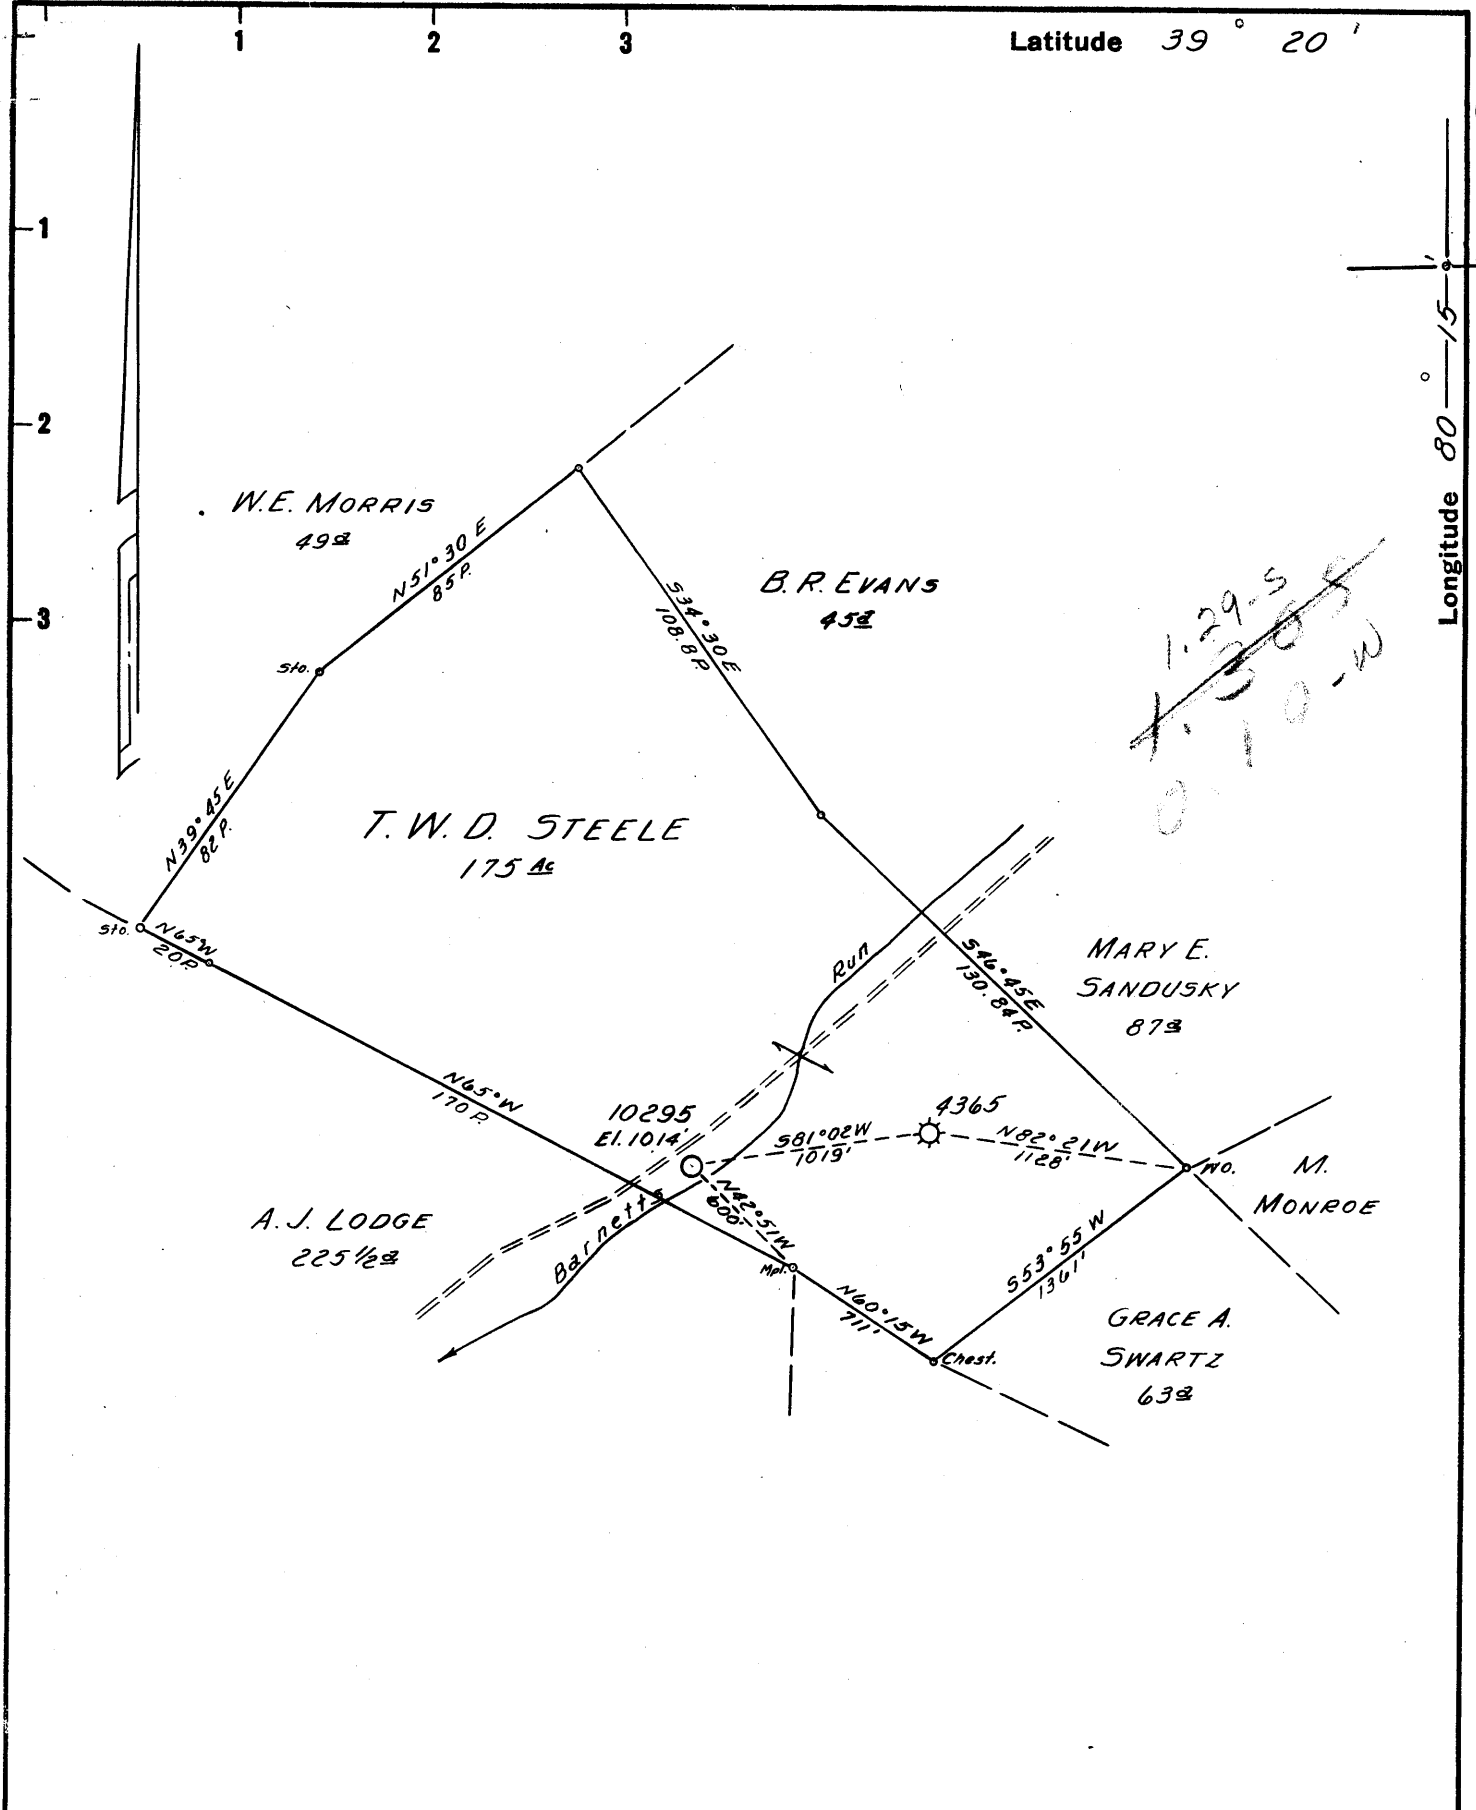

New Location
 Drill Deeper
 Abandonment

Map Sheet 42, S-10 E-20, F.B. 1233 P. 1 & 3

Company HOPE NATURAL GAS CO.
 Address CLARKSBURG W.VA.
 Farm T.W.D. STEELE
 Tract _____ Acres 175 Lease No. 13073
 Well (Farm) No. _____ Serial No. 10295
 Elevation (Spirit Level) 1014'
 Quadrangle CLARKSBURG SE
 County HARRISON District SIMPSON
 Engineer Guy H. Bradley
 Engineer's Registration No. 2425
 File No. _____ Drawing No. _____
 Date 7/14/60 Scale 1"=50 Poles

STATE OF WEST VIRGINIA
 DEPARTMENT OF MINES
 OIL AND GAS DIVISION
 CHARLESTON

WELL LOCATION MAP
 FILE NO. HAR-221

+ Denotes location of well on United States Topographic Maps, scale 1 to 62,500, latitude and longitude lines being represented by border lines as shown.

- Denotes one inch spaces on border line of original tracing.



STATE OF WEST VIRGINIA
DEPARTMENT OF MINES
OIL AND GAS DIVISION 14

Quadrangle CLARKSBURG

Permit No. HAR - 221

WELL RECORD

Oil or Gas Well Gas

Company Hope Natural Gas Company
 Address Clarksburg, W. Va.
 Farm T.W.D. Steele Acres 175
 Location (waters) _____
 Well No. 10295 Elev. 1014
 District Simpson County Harrison
 The surface of tract is owned in fee by _____
 Address _____
 Mineral rights are owned by _____
 Address _____
 Drilling commenced 8-12-60
 Drilling completed 10-27-60
 Date Shot 10-31-60 From 1764 To 1800
 With 56 Qts. Glycerin
 Open Flow /10ths Water in _____ Inch
 _____/10ths Merc. in _____ Inch
 Volume 2,568 M Cu. Ft.
 Rock Pressure 220 lbs. 24 hrs.
 Oil ~~None~~ None bbls., 1st 24 hrs.
 WELL ACIDIZED No
 WELL FRACTURED No

Casing and Tubing	Used in Drilling	Left in Well	Packers
Size			Kind of Packer
16			
13	18	18	
10	290	290	Size of
8 1/4	1022	1022	
6 3/8	1741	1741	Depth set
5 3/16			
3			Perf. top
2			Perf. bottom
Liners Used			Perf. top
			Perf. bottom

CASING CEMENTED _____ SIZE _____ No. Ft. _____ Date _____
8-5/8" csg. cemented w/200 bgs. 7" csg. cemented
with 180 bags.
 COAL WAS ENCOUNTERED AT _____ FEET _____ INCHES
43 FEET 12 INCHES FEET _____ INCHES
 _____ FEET _____ INCHES FEET _____ INCHES

RESULT AFTER TREATMENT 3,011 M.
 ROCK PRESSURE AFTER TREATMENT Same
 Fresh Water 17 Feet _____ Salt Water 495-500 560 Feet _____

Formation	Color	Hard or Soft	Top	Bottom	Oil, Gas or Water	Depth	Remarks
Clay			0	5			
Slate			5	43	Water	17'	H.F.Fresh
Coal			43	44			
Slate			44	60			
Red Rock			60	75			
Slate & Shells			75	108			
Sand			108	145			
Red Rock			145	156			
Slate & Red Rock			156	207			
Lime			207	240			
Slate & Shells			240	265			
Sand			265	274			
Slate & Shells			274	302			
Lime			302	322			
Sand			322	358	Gas	347'	
Gritty Lime			358	393			
Slate & Shells			393	399			
Lime			399	428			
Slate & Shells			428	495			
Sand			495	500	Water	495-500	100'-2hrs.10"
Slate & Shells			500	530			Hole.3 1/2 blrs.pr
GAS SAND			530	604			hr. salty
Slate & Shells			604	647	Water	560'	Hole Full
FIRST SALT			647	723			
Slate & Shells			723	757			
SECOND SALT			757	779			
Slate & Shells			779	785			
Gritty Lime			785	837			
Black Slate			837	857			

Formation	Color	Hard or Soft	Top 14	Bottom	Oil, Gas or Water	Depth Found	Remarks
Lime			857	869			
Red Rock			869	875			
Lime			875	882			
Red Rock			882	1052			
Lime			1052	1106			
Red Rock			1106	1172			
Slate			1172	1187			
LITTLE LIME			1187	1193			
Slate			1193	1212			
BIG LIME			1212	1236	Gas	1213'	Show
BIG LIME			1236	1315			
BIG INJUN			1315	1382			
Slate & Shells			1382	1758		1762-97'	
50 FOOT			1758	1888	Gas	1800	
Total Depth				1888			Abandoned 60' of hole with cement.

Date November 25, 19 60

APPROVED Hope Natural Gas Company, Owner

By [Signature]
(Title)