

New Location  NOTE:  
 Drill Deeper  Hugh Garrett Mrs. own in Fee.  
 Abandonment

Company	SWADLEY OIL & GAS CO.	
Address	70 WALDO CIGAR STAND CLARKSBURG, W. VA.	
Farm	HUGH GARRETT MRS.	
Tract	Acres 175	Lease No.
Well (Farm) No.	6	Serial No.
Elevation (Spirit Level)	1223'	
Quadrangle	CLARKSBURG SW	
County	HARRISON	District CLARK
Engineer	JOHN W. HAMILTON	
Engineer's Registration No.	2274	
File No.	Drawing No.	
Date	JAN. 2, 1961	Scale 1"=500'

STATE OF WEST VIRGINIA  
 DEPARTMENT OF MINES  
 OIL AND GAS DIVISION  
 CHARLESTON

**WELL LOCATION MAP**  
 FILE NO. HAR-228

+ Denotes location of well on United States Topographic Maps, scale 1 to 62,500, latitude and longitude lines being represented by border lines as shown.

- Denotes one inch spaces on border line of original tracing.



STATE OF WEST VIRGINIA  
DEPARTMENT OF MINES  
OIL AND GAS DIVISION

Quadrangle Clarksburg

Permit No. HAR-228

WELL RECORD

Oil or Gas Well Gas  
(KIND)


Company Swadley Oil & Gas Co.  
Address Waldo Hotel Building, Clarksburg, W. Va.  
Farm Hugh Garrett Heirs Acres 175  
Location (waters) Limestone creek  
Well No. 6 Elev. 1223  
District Clark County Harrison  
The surface of tract is owned in fee by Hugh Garrett Heirs,  
Reynoldsville Address W. Va.  
Mineral rights are owned by Same  
Address \_\_\_\_\_  
Drilling commenced 1/16/61  
Drilling completed 2/2/61  
Date Shot - From - To -  
With ---  
Open Flow /10ths Water in \_\_\_\_\_ Inch  
50/10ths Merc. in 1 1/2" Inch  
Volume 462,000 Cu. Ft.  
Rock Pressure - lbs. - hrs.  
Oil none bbls., 1st 24 hrs.  
WELL ACIDIZED ---  
WELL FRACTURED ---

Casing and Tubing	Used in Drilling	Left in Well	Packers
Size			Kind of Packer
16			
13			
10			Size of
8 1/4	1000'		
6 5/8	1414'	1414'	Depth set
5 3/16			
3			Perf. top
2			Perf. bottom
Liners Used			Perf. top
			Perf. bottom

CASING CEMENTED \_\_\_\_\_ SIZE \_\_\_\_\_ No. Ft. \_\_\_\_\_ Date \_\_\_\_\_  
COAL WAS ENCOUNTERED AT \_\_\_\_\_ FEET \_\_\_\_\_ INCHES  
\_\_\_\_\_ FEET \_\_\_\_\_ INCHES FEET \_\_\_\_\_ INCHES  
\_\_\_\_\_ FEET \_\_\_\_\_ INCHES FEET \_\_\_\_\_ INCHES

RESULT AFTER TREATMENT ---  
ROCK PRESSURE AFTER TREATMENT \_\_\_\_\_  
Fresh Water none Feet none Salt Water none Feet none

Formation	Color	Hard or Soft	Top	Bottom	Oil, Gas or Water	Depth	Remarks
Clay	brown	soft	0	15			
Blue Clay	brown	soft	15	30			
White Clay	light	soft	30	55			
Red Rock	brown	soft	55	65			
Slate	dark	soft	65	105			
Red Rock	brown	hard	105	140			
Sand	light	soft	140	150			
Slate	dark	soft	150	218			
Red Rock	brown	hard	218	229			
Slate & shells	dark	hard	229	475			
Sand - Big Sand	light	hard	475	545			
Slate & Shells	dark	soft	545	660			
Sand - Gas Sand	light	soft	660	720			
Slate	dark	hard	720	750			
hard sand	light	hard	750	782			
Slate	dark	hard	782	895			
Sand	light	hard	895	955			
Slate	dark	soft	955	960			
Lime	light	hard	960	986			
Slate & shells	dark	hard	986	1210			
Sand	light	hard	1210	1240			
Red Rock	dark	hard	1240	1295			
Slate & 311	dark	soft	1295	1349			
Big Lime	light	hard	1349	1407			
Big Injun sand	light	hard	1407	1507			
Slate & shells	dark	soft	1507	1837			show of gas at 1440'
Berea sand	light	hard	1837	1855			
Slate	dark	hard	1855	1892			
50' sand	light	hard	1892	1918			gas at 1915'
Slate	dark	hard	1918	1930			

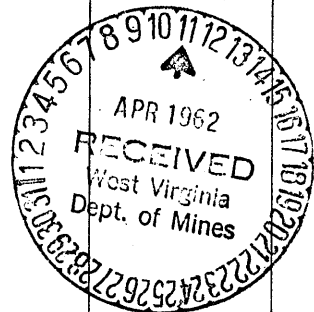

Total Depth 1930' (over)