

West Virginia Department of Environmental Protection
Office of Oil & Gas
WELL LOCATION FORM: GPS


API: 47- 033 - 0388 P WELL NO: No.1
FARM NAME: Hallie Haught
RESPONSIBLE PARTY NAME: HG Energy, LLC
COUNTY: Harrison DISTRICT: Clay
QUADRANGLE: Fairmont West 7.5'
SURFACE OWNER: Jack Van Slyke Sr. & Milligan Tamara
ROYALTY OWNER: HG Energy LLC et al.
UTM GPS NORTHING: 4,361,374
UTM GPS EASTING: 566,438 GPS ELEVATION: 386 m.

The Responsible Party named above has chosen to submit GPS coordinates in lieu of preparing a new well location plat for a plugging permit on the above well. The Office of Oil & Gas will not accept GPS coordinates that do not meet the following requirements:

1. Datum: NAD 1983, Zone:17 North, Coordinate Units: meters, Altitude: height above mean sea level (MSL) - meters.
2. Accuracy to Datum - 3.05 meters
3. Data Collection Method:

Survey Grade GPS Post Processed Differential
 Real-Time Differential
Mapping Grade GPS Post Processed Differential
 Real-Time Differential


I the undersigned, hereby certify this data is correct to the best of my knowledge and belief and shows all the information required by law and the regulations issued and prescribed by the Office of Oil and Gas.

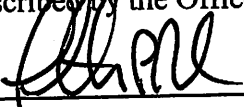
Signature Timothy P. Roush

Professional Surveyor
Title

October 3, 2012
Date

SUBJECT WELL
Hallie Haught No. 1
47-033-0388

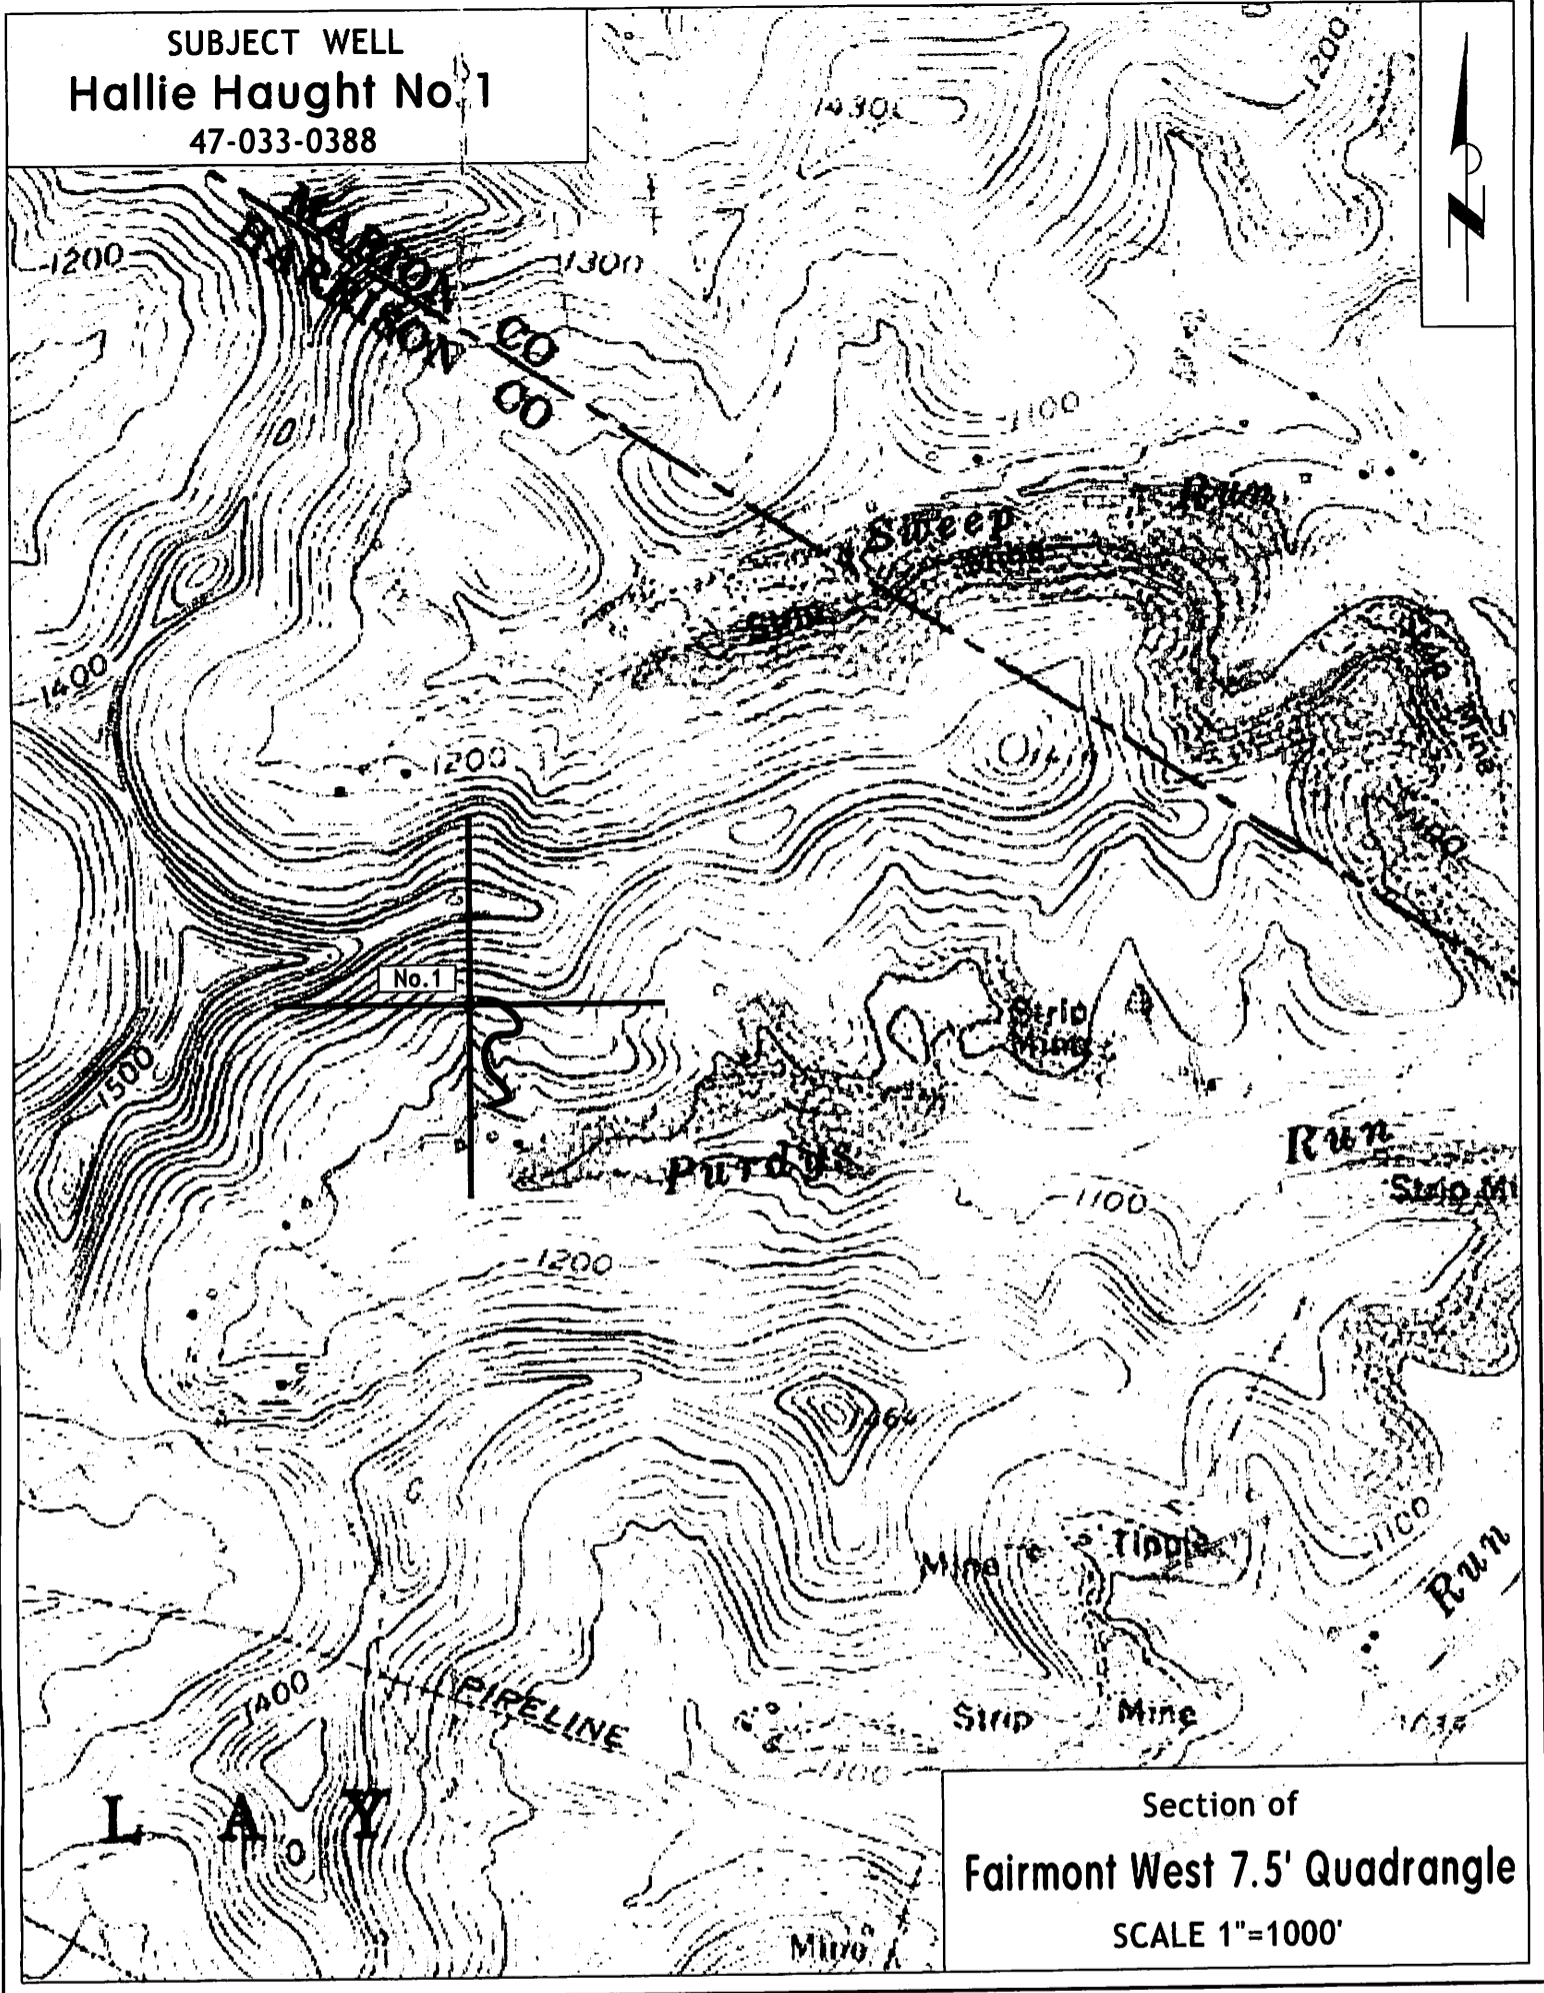

Section of
Fairmont West 7.5' Quadrangle
SCALE 1"=1000'