

WW-7
8-30-06



West Virginia Department of Environmental Protection
Office of Oil and Gas

WELL LOCATION FORM: GPS

API: 47-033-00453 WELL NO.: 3584
 FARM NAME: A.B. Cropp
 RESPONSIBLE PARTY NAME: Eastern Gas Transmission and Storage, Inc
 COUNTY: Harrison DISTRICT: Simpson
 QUADRANGLE: Rosemont
 SURFACE OWNER: Metro Rentals LLC
 ROYALTY OWNER: Hugh Jarvis, etal
 UTM GPS NORTHING: 4352912
 UTM GPS EASTING: 566284 GPS ELEVATION: 386 m ^(1266')

The Responsible Party named above has chosen to submit GPS coordinates in lieu of preparing a new well location plat for a plugging permit or assigned API number on the above well. The Office of Oil and Gas will not accept GPS coordinates that do not meet the following requirements:

1. Datum: NAD 1983, Zone: 17 North, Coordinate Units: meters, Altitude: height above mean sea level (MSL) – meters.
2. Accuracy to Datum – 3.05 meters
3. Data Collection Method:

Survey grade GPS ____ : Post Processed Differential ____

Real-Time Differential ____

Mapping Grade GPS ____ : Post Processed Differential ____

Real-Time Differential ____

4. **Letter size copy of the topography map showing the well location.**

I the undersigned, hereby certify this data is correct to the best of my knowledge and belief and shows all the information required by law and the regulations issued and prescribed by the Office of Oil and Gas.

Richard C. Blaine Project Manager 06/16/2021
 Signature Title Date

07/16/2021

RECEIVED
Office of Oil and Gas


JUN 23 2021

WV Department of
Environmental Protection




CIVIL & ENVIRONMENTAL CONSULTANTS, INC.
120 GENESIS BOULEVARD
BRIDGEPORT, WV 26330
304-933-3119

GRID NORTH
UTM, NAD83 DATUM, ZONE 17, US FT

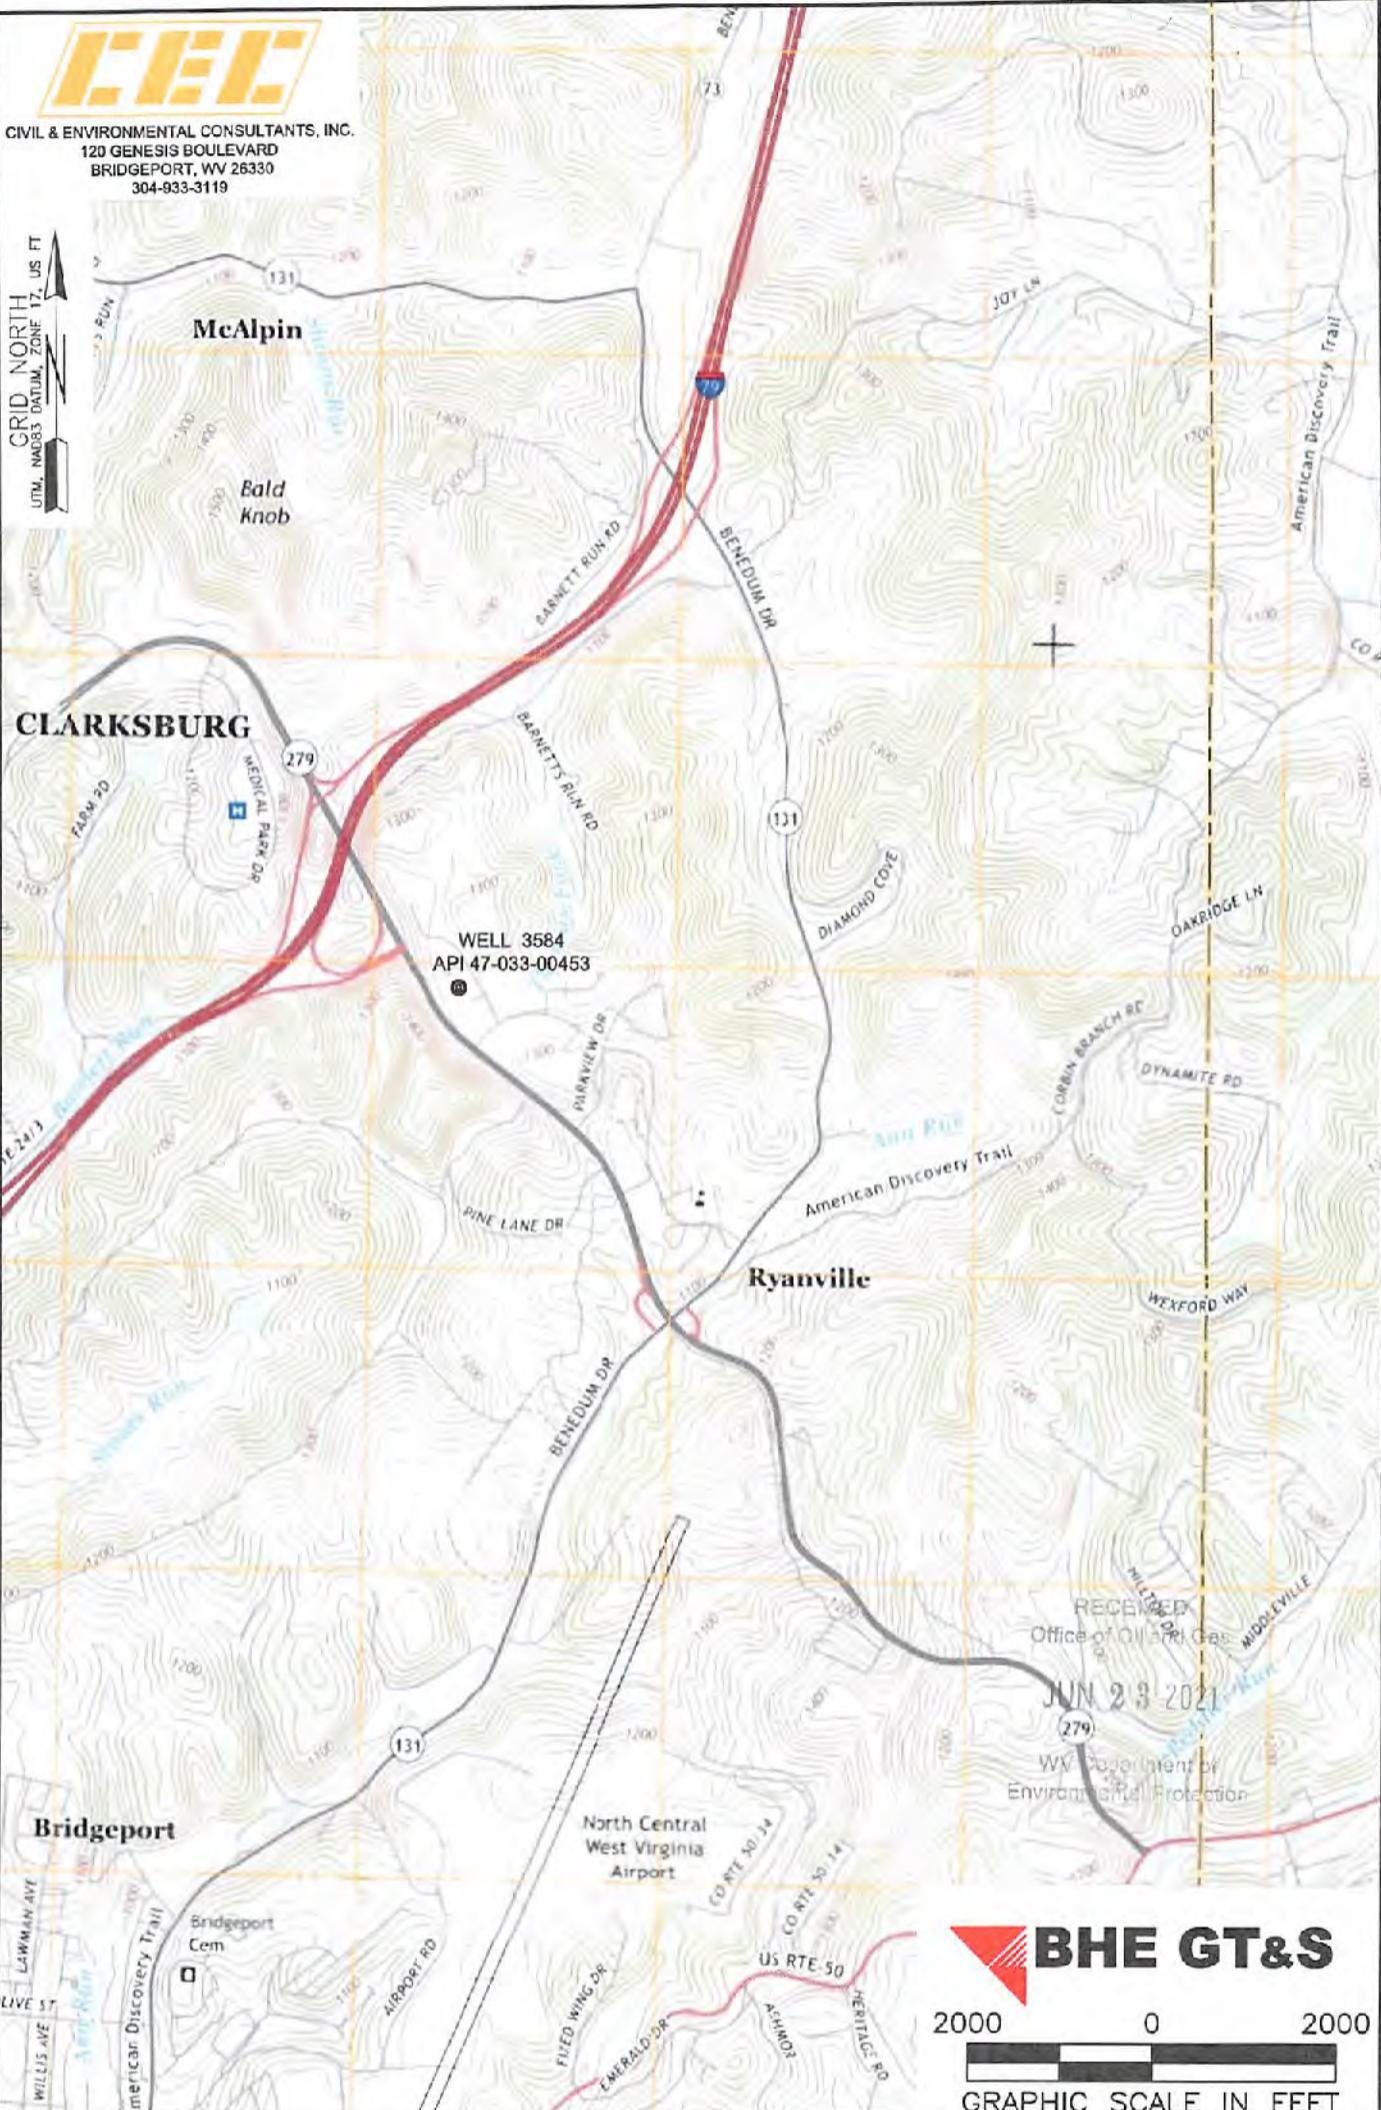

RECEIVED
Office of Oil and Gas
JUN 23 2021
WV Department of
Environmental Protection

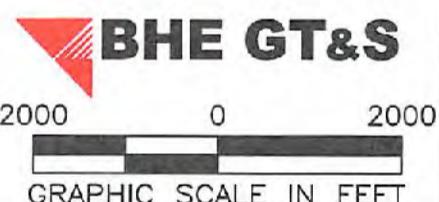

NOTES ON SURVEY			
1. SURFACE AND ROYALTY OWNER INFORMATION AND THEIR BOUNDARIES SHOWN HEREON WERE PLOTTED FROM DEEDS AND/OR TAX PARCEL MAPS PROVIDED BY CLIENT AND/OR FIELD LOCATIONS.			
2. THIS PLAN DOES NOT REPRESENT A BOUNDARY SURVEY OF THE PARCELS SHOWN HEREON.			
4. ALL INSETS ARE GRID NORTH UNLESS OTHERWISE DEPICTED.			
LEGEND:		ACCESS ROAD	
○	PROPOSED SURFACE HOLE / BOTTOM HOLE	---	PUBLIC ROAD
⊗	EXISTING / PRODUCING WELLHEAD	---	ACCESS ROAD TO PREV. SITE
LPL*	LANDING POINT LOCATION	=====	LEASE BOUNDARY
🌊	FLOOD PLAIN	---	PROPOSED PATH
WELL OPERATOR: EASTERN GAS TRANSMISSION AND STORAGE, INC. ADDRESS: 925 WHITE OAKS BLVD, BRIDGEPORT, WV 26330		WELL (FARM) NAME: A. B. CROPP	
SURFACE OWNER: METRO RENTALS LLC		WELL # 3584	
		SERIAL # XXXX	
		COUNTY - CODE HARRISON - 033	
		DISTRICT; SIMPSON DISTRICT	
		USGS 7 1/2 QUADRANGLE MAP NAME ROSEMONT, WV	

07/16/2021