

Minimum Error of Closure 1' IN 200'  
 Source of Elevation U.S.G.S. TRIANGULATION STATION - BALD KNOB -  
(ROSEMONT 7 1/2' TOPO MAP) ELEV. 1553'  
 "I, the undersigned, hereby certify that this map is correct to the best of my knowledge and belief and shows all the information required by paragraph 6 of the rules and regulations of the oil and gas section of the mining laws of West Virginia."

Re-Drill...   
 New Location.....   
 Drill Deeper.....   
 Abandonment.....   
 ISSUED 5-2-68

MAP SHEET 42 S-10, E-20 F.B. 1476 Pg. 7-8

Company CONSOLIDATED GAS SUPPLY CORP.  
 Address CLARKSBURG, W.VA.  
 Farm MARY E. SANDUSKY (HAZEL S. WILLIS)  
 Tract \_\_\_\_\_ Acres 52± Lease No. 53929  
 Well (Farm) No. \_\_\_\_\_ Serial No. 3774  
 Elevation (Spirit Level) 1105'  
 Quadrangle FAIRMONT S.W.  
 County HARRISON District SIMPSON  
 Engineer JACKSON M. JARVIS  
 Engineer's Registration No. 2397  
 File No. \_\_\_\_\_ Drawing No. \_\_\_\_\_  
 Date 4-19-68 Scale 1" = 660'

STATE OF WEST VIRGINIA  
 DEPARTMENT OF MINES  
 OIL AND GAS DIVISION  
 CHARLESTON

WELL LOCATION MAP  
 FILE NO. HAAR-499-Red-P-CANC.  
1-23-69

+ Denotes location of well on United States Topographic Maps, scale 1 to 62,500, latitude and longitude lines being represented by border lines as shown.  
 - Denotes one inch spaces on border line of original tracing.



STATE OF WEST VIRGINIA  
DEPARTMENT OF MINES  
OIL AND GAS DIVISION

Rotary     
 Spudder   
 Cable Tools  Storage observation well  
 Storage   *Gas*  
 Oil or Gas Well  (KIND)

Quadrangle FAIRMONT  
 Permit No. HAR-179-RFD

WELL RECORD


Company Consolidated Gas Supply Corporation  
 Address Clarksburg, W. Va.  
 Farm Mary E. Sandusky Acres 52  
 Location (waters) \_\_\_\_\_  
 Well No. 3771 Elev. 1105'  
 District Simpson County Harrison  
 The surface of tract is owned in fee by \_\_\_\_\_  
 Address \_\_\_\_\_  
 Mineral rights are owned by \_\_\_\_\_  
 Address \_\_\_\_\_  
 Drilling commenced 5-22-68  
 Drilling completed 5-31-68  
 Date Shot Not shot From \_\_\_\_\_ To \_\_\_\_\_  
 With \_\_\_\_\_  
 Open Flow None /10ths Water in \_\_\_\_\_ Inch  
 /10ths Merc. in \_\_\_\_\_ Inch  
 Volume None Cu. Ft.  
 Pressure 325 lbs. 90 hrs.  
None bbls., 1st 24 hrs.  
 L ACIDIZED (DETAILS) No  
 WELL FRACTURED (DETAILS) 6-1-68

Casing and Tubing	Used in Drilling	Left in Well	Packers
Size			Kind of Packer
16			
13			
10	9 1/2	9 1/2	Size of
8 1/4			
6 3/8			Depth set
5 3/16			
4 1/2	15 1/2	15 1/2	
3			Perf. top
2			Perf. bottom
Liners Used			Perf. top
			Perf. bottom

Attach copy of cementing record. 1 1/2" with 760 bags  
 CASING CEMENTED \_\_\_\_\_ SIZE \_\_\_\_\_ No. Ft. \_\_\_\_\_ Date \_\_\_\_\_  
 Amount of cement used (bags) 760 Bags  
 Name of Service Co. Halliburton  
 COAL WAS ENCOUNTERED AT None FEET \_\_\_\_\_ INCHES  
 \_\_\_\_\_ FEET \_\_\_\_\_ INCHES  
 \_\_\_\_\_ FEET \_\_\_\_\_ INCHES

RESULT AFTER TREATMENT (Initial open Flow or bbls.) 133 Mc  
 ROCK PRESSURE AFTER TREATMENT 312# XXXXX 1 1/2 Days 133000  
 Fresh Water No record Feet \_\_\_\_\_ Salt Water No record Feet \_\_\_\_\_  
 Producing sand Injun (Storage Observation) Depth 1120-30'

Formation	Color	Hard or Soft	Top	Bottom	Oil, Gas or Water	Depth	Remarks
THIS RECORD TAKEN FROM GAMMA RAY SURVEY							
Little Dunkard			315	371			
Big Dunkard			393	438			
1st Salt			719	892			
Maxton			1134	1200			
Little Lime			1215	1262			
Big Lime			1288	1382			
Big Injun			1382	1455	Gas	1120-30'	
50' Sand			1829	1891			
30' Sand			1904	1967			
TOTAL DEPTH REDRILLED				2050'			
Cemented solid back to				1532'	Present total depth		

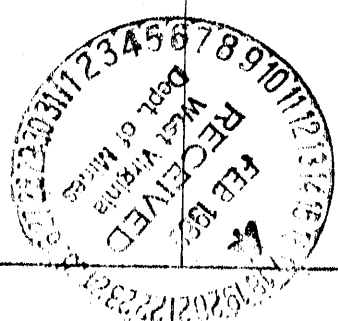

Consolidated Gas Supply Corporation  
 145 West Main Street  
 Clarksburg, W. Va.