

3300707A

WW-7  
5-02



West Virginia Department of Environmental Protection  
Office of Oil and Gas  
WELL LOCATION FORM: GPS

API: 47-033-00707 WELL NO.: 8143

FARM NAME: G. P. MCCONKEY

RESPONSIBLE PARTY NAME: CNX GAS COMPANY LLC

COUNTY: HARRISON DISTRICT: UNION

QUADRANGLE: WEST MILFORD 7.5 MIN.

SURFACE OWNER: JOHN H. ZIRKLE

ROYALTY OWNER: WV WESLEYAN COLLEGE

UTM GPS NORTHING: 4,337,355.79 METERS

UTM GPS EASTING: 546,122.10 METERS GPS ELEVATION: 336.97 METERS 1105.59 FT

The Responsible Party named above has chosen to submit GPS coordinates in lieu of preparing a new well location plat for a plugging permit on the above well. The Office of Oil and Gas will not accept GPS coordinates that do not meet the following requirements:

1. Datum: NAD 1983, Zone: 17 Coordinate Units: meters Altitude: Height above mean sea level (MSL) - meters
2. Accuracy to Datum - 3.05 meters
3. Data Collection Method: Survey Grade GPS  : Post Processed Differential  Real-Time Differential   
Mapping Grade GPS  : Post Processed Differential  Real-Time Differential


I the undersigned hereby state this data is correct to the best of my knowledge and belief and shows all the information required by law and the regulation issued and prescribed by the Office of Oil and Gas.

Signature   
Stephen D. Losh, PS #674


Title WV Professional Surveyor #674

Date 05/06/13

Received

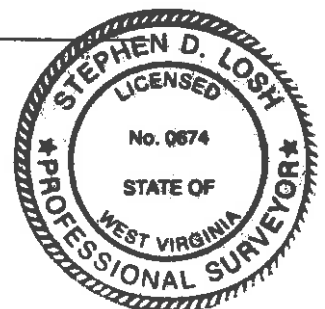

CNX USE: NAD 27 WV NORTH SPC: 8143 = 250,646.51' 1,726,130.10' ELEV. = 1,105.55'

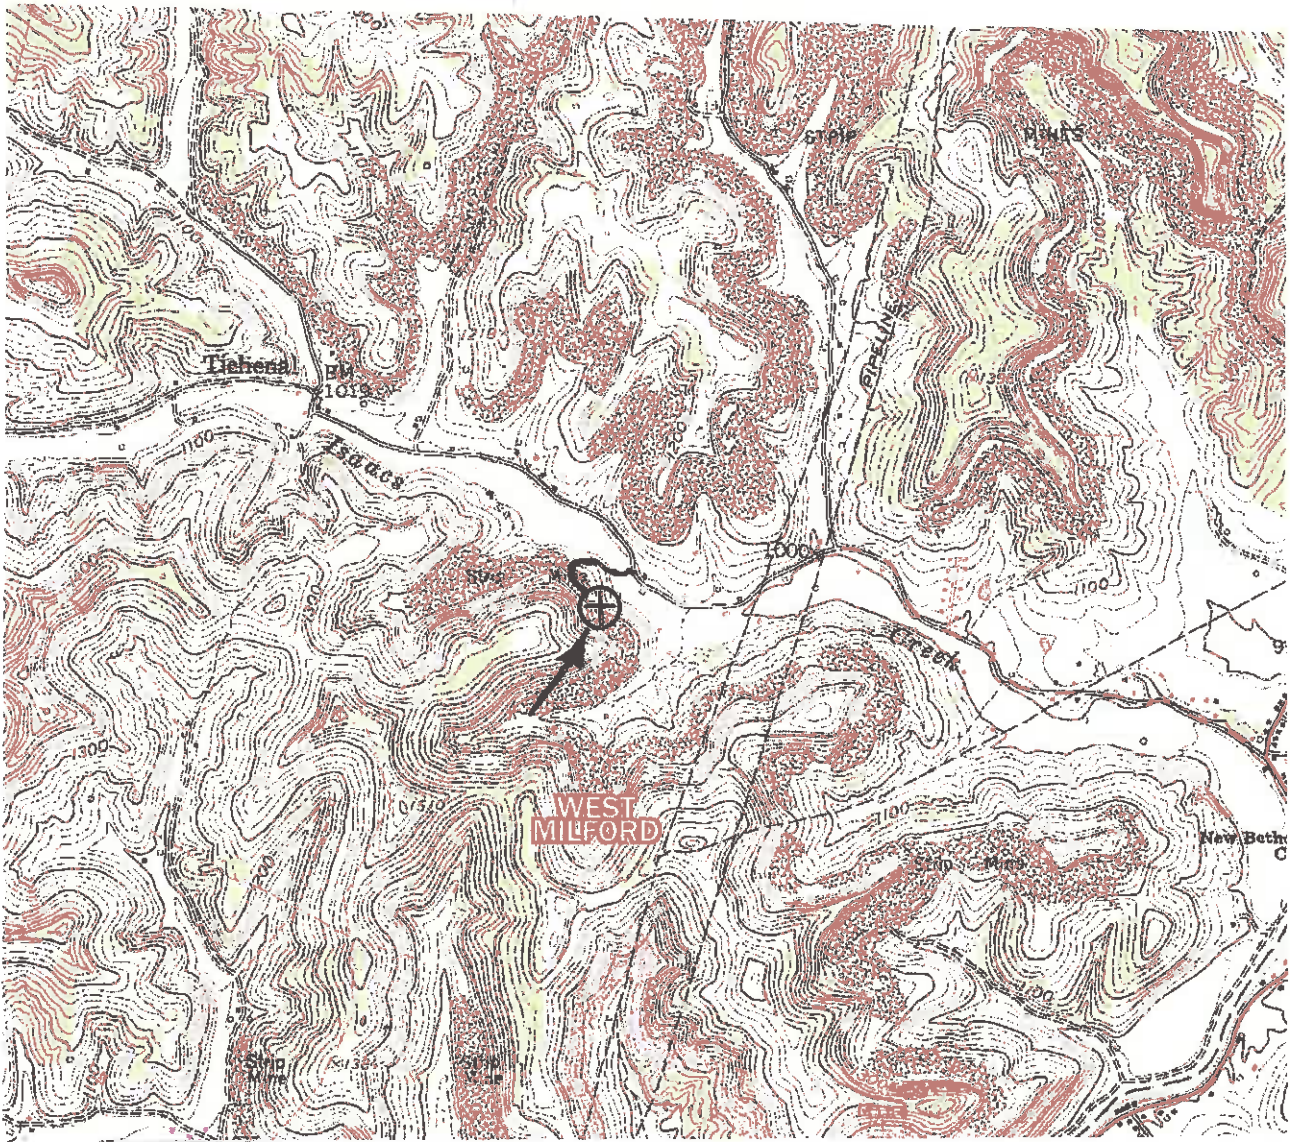

DRAWINGS TO ACCOMPANY FORM WW-9

---

CNX GAS COMPANY LLC

---

P. O. BOX 1248

---

JANE LEW, WV 26378

---

WATERSHED: ISAACS CREEK

---

DISTRICT: UNION COUNTY: HARRISON

---

QUADRANGLE: WEST MILFORD WELL NO.: 8143

---

DATE: 05/06/13 PAGE      of     

Received  
AUG - 1 2013

LAND SURVEYING SERVICES  
21 CEDAR LANE  
BRIDGEPORT, WV 26330  
PHONE: 304-842-2018 OR 5762

Office of Oil and Gas  
WV Dept. of Environmental Protection