


POST LEASE
283 ACRES±

DOMINION TRANSMISSION INC.
WELL 8122
47-033-00728
(S.P.C. NORTH ZONE) (UTM(M) ZONE 17 NORTH)
NAD'27 S.P.C.(FT) N. 249,258 E. 1,731,787
NAD'27 GEO. LAT-(N) 39.180482 LONG-(W) 80.446154
NAD'83 UTM (M) N. 4,336,961 E. 547,853

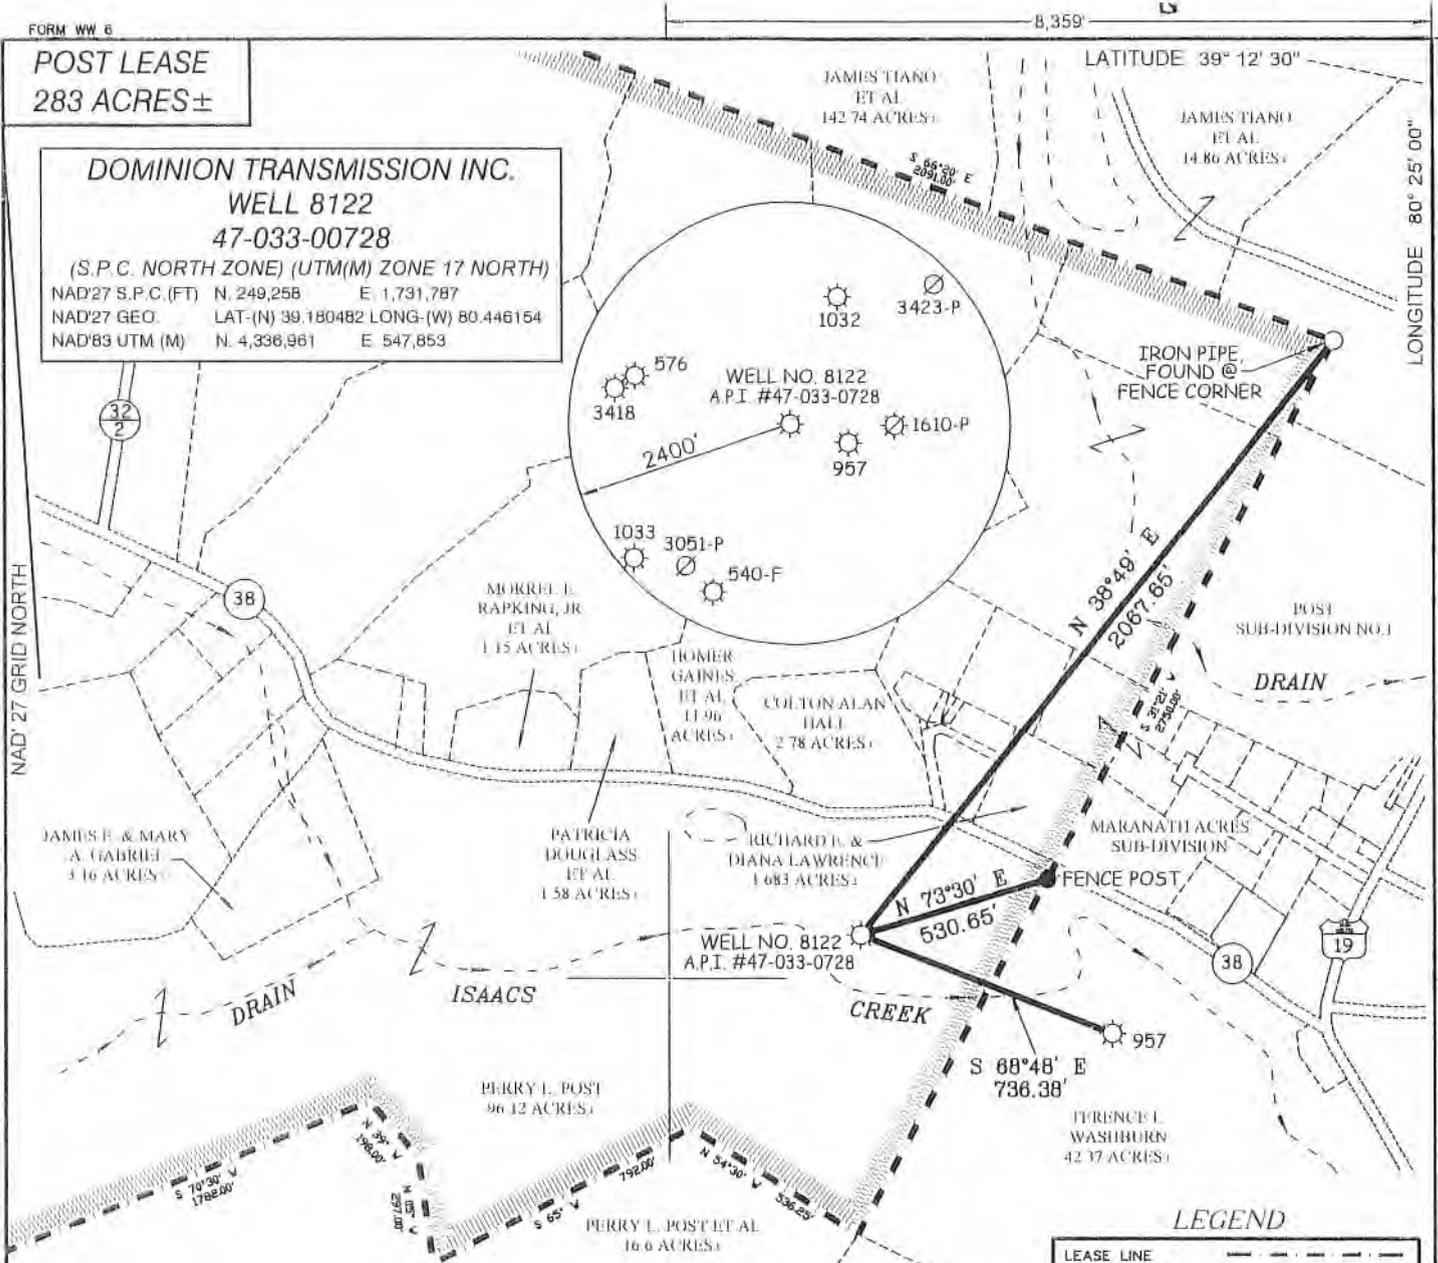

NOTES ON SURVEY

1. TIES TO WELLS AND CORNERS ARE BASED ON GRID NORTH FOR THE WV STATE PLANE COORDINATE SYSTEM NORTH ZONE NAD '27.
2. LEASE BOUNDARY SHOWN HEREON TAKEN FROM A PLAT DATED 08/08/1973 FOR WELL A.P.I. #47-033-0728, DEED BOOK 1329 PAGE 346.
3. SURFACE OWNER AND ADJOINER INFORMATION TAKEN FROM THE ASSESSOR AND COUNTY CLERK RECORDS OF HARRISON COUNTY IN AUGUST, 2020.
4. WELL LAT./LONG. (NAD'27) ESTABLISHED BY DGPS(SUBMETER MAPPING GRADE).

LEGEND


LEASE LINE	---
SURFACE LINE	----
WELL LATERAL
OFFSET LINE	-----
TIE LINE	=====
CREEK	~~~~~
ROAD	=====
FENCE LINE	-----
COUNTY ROUTE	-----
STATE ROUTE	-----
PROPOSED WELL	☉
EXISTING WELL	⊙
PERMITTED WELL	⊙



12 Vroman Drive | Box 100 | Glenville, WV 26031 | 304-682-9031
442 Canastota Circle, East | Charleston, WV 25301 | 304-333-3952
29-2 E. Kentucky Drive | Ashby, WV 26801 | 304-253-3298
www.sls.com

I THE UNDERSIGNED, HEREBY CERTIFY THAT THIS PLAT IS CORRECT TO THE BEST OF MY KNOWLEDGE AND BELIEF AND SHOWS ALL THE INFORMATION REQUIRED BY LAW AND THE REGULATIONS ISSUED AND PRESCRIBED BY THE DIVISION OF ENVIRONMENTAL PROTECTION.

P.S. 849 *C. Victor Moyers*

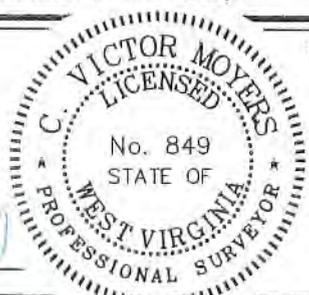

(+) DENOTES LOCATION OF WELL ON UNITED STATES TOPOGRAPHIC MAPS.
DATE APRIL 20, 20 11
REVISED 8-10-2017 & 8-18-2020
OPERATORS WELL NO. 8122
API WELL NO. 47-033-00728
STATE COUNTY PERMIT

MINIMUM DEGREE OF ACCURACY 1 / 2500 FILE NO. 8707P8122R.DWG
HORIZONTAL & VERTICAL CONTROL DETERMINED BY DGPS (SUBMETER MAPPING GRADE TIE TO CORS NETWORK) SCALE 1" = 500'

STATE OF WEST VIRGINIA
DIVISION OF ENVIRONMENTAL PROTECTION
OFFICE OF OIL AND GAS


WELL TYPE:	OIL <input type="checkbox"/>	GAS <input checked="" type="checkbox"/>	LIQUID INJECTION <input type="checkbox"/>	WASTE DISPOSAL <input type="checkbox"/>	IF "GAS" PRODUCTION <input checked="" type="checkbox"/>	STORAGE <input type="checkbox"/>	DEEP <input type="checkbox"/>	SHALLOW <input checked="" type="checkbox"/>	
LOCATION:	ELEVATION <u>980'</u>	WATERSHED <u>ISAACS CREEK</u>	DISTRICT <u>UNION</u>	COUNTY <u>HARRISON</u>	QUADRANGLE <u>WEST MILFORD 7.5'</u>				
SURFACE OWNER	<u>PERRY LEE POST</u>			ACREAGE	<u>96.12±</u>				
ROYALTY OWNER	<u>C.W. POST</u>			ACREAGE	<u>283±</u>				
PROPOSED WORK:				LEASE NO.	<u>52902</u>				
DRILL <input type="checkbox"/>	CONVERT <input type="checkbox"/>	DRILL DEEPER <input type="checkbox"/>	REDRILL <input type="checkbox"/>	FRACTURE OR STIMULATE <input type="checkbox"/>	PLUG OFF OLD FORMATION <input type="checkbox"/>	PERFORATE NEW FORMATION <input type="checkbox"/>	PLUG AND ABANDON <input checked="" type="checkbox"/>	CLEAN OUT AND REPLUG <input type="checkbox"/>	OTHER <input type="checkbox"/>
PHYSICAL CHANGE IN WELL (SPECIFY)				TARGET FORMATION	<u>BALLTOWN</u>				
				ESTIMATED DEPTH	<u>3079'</u>				
WELL OPERATOR	<u>DOMINION TRANSMISSION INC.</u>			DESIGNATED AGENT	<u>JOHN M. LOVE</u>				
ADDRESS	<u>925 WHITE OAKS BOULEVARD</u>			ADDRESS	<u>925 WHITE OAKS BOULEVARD</u>				
	<u>BRIDGEPORT, WV 26330</u>				<u>BRIDGEPORT, WV 26330</u>				

COUNTY NAME
PERMIT

Form WW-9

**POST LEASE
47-033-00728**

page of

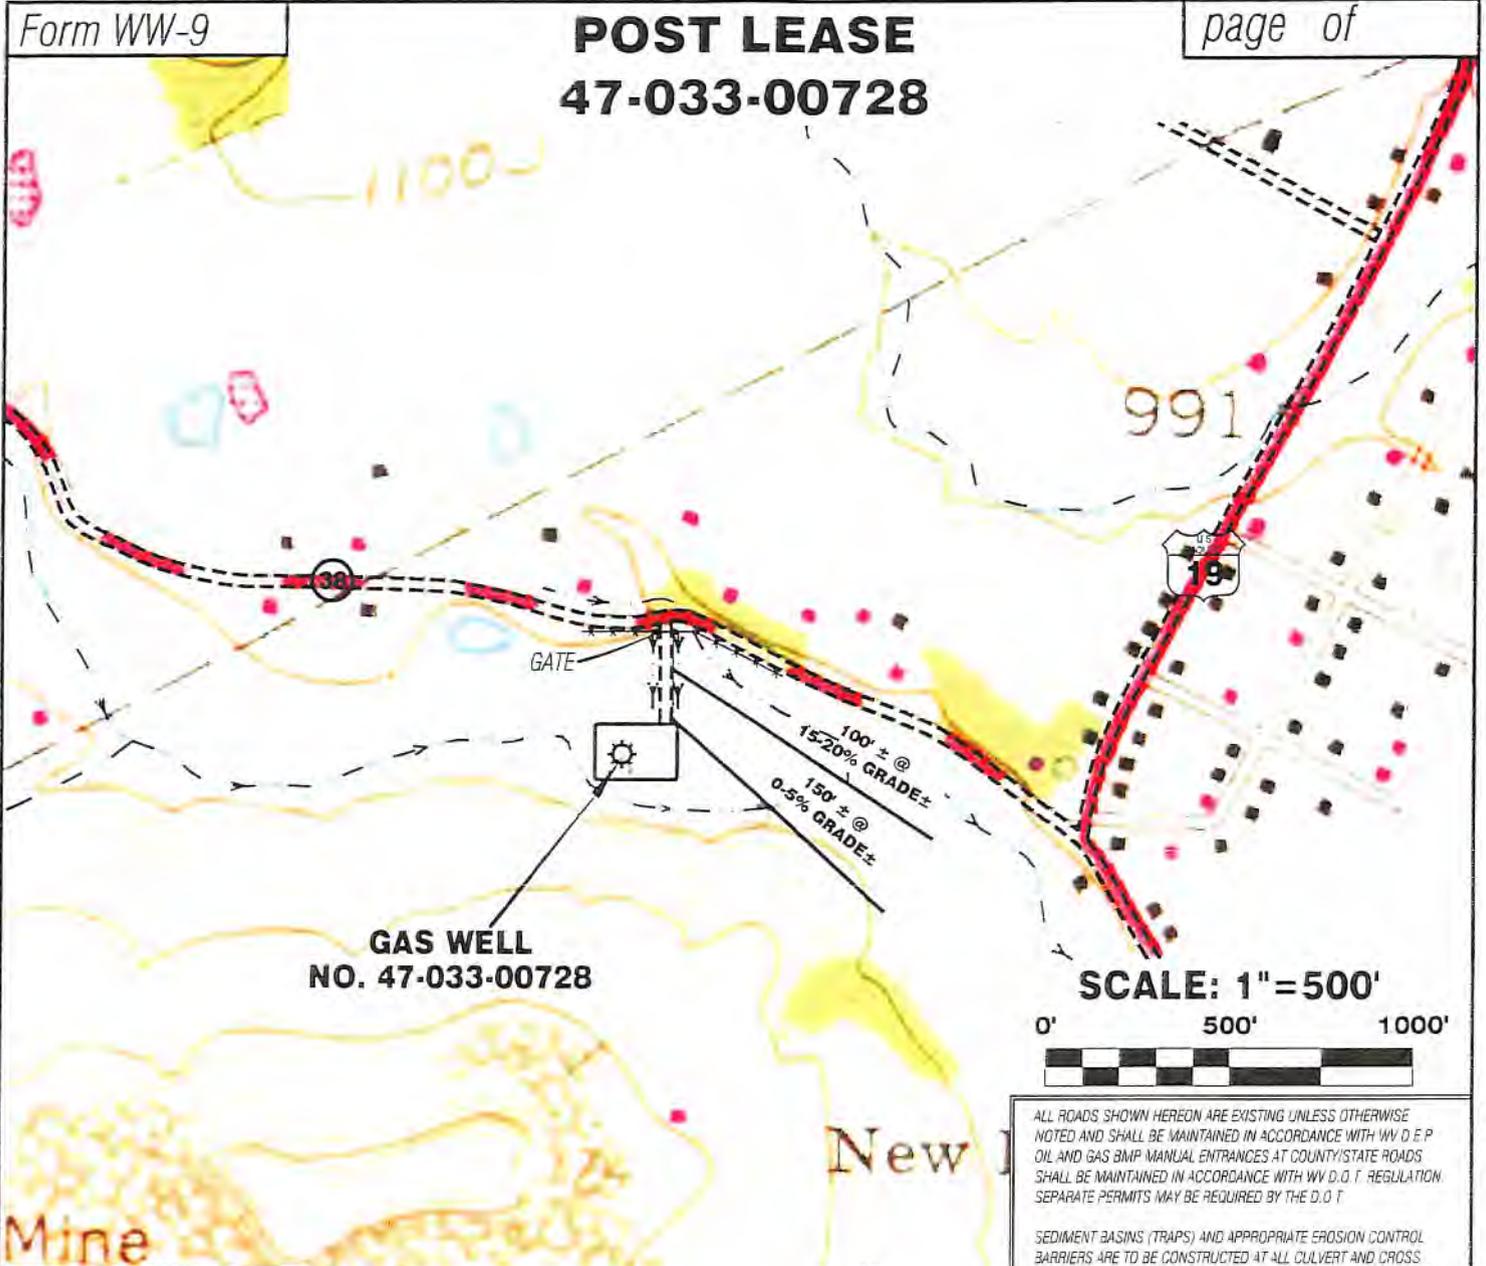


**GAS WELL
NO. 47-033-00728**

SCALE: 1" = 500'



Detail Sketch for 47-033-00728

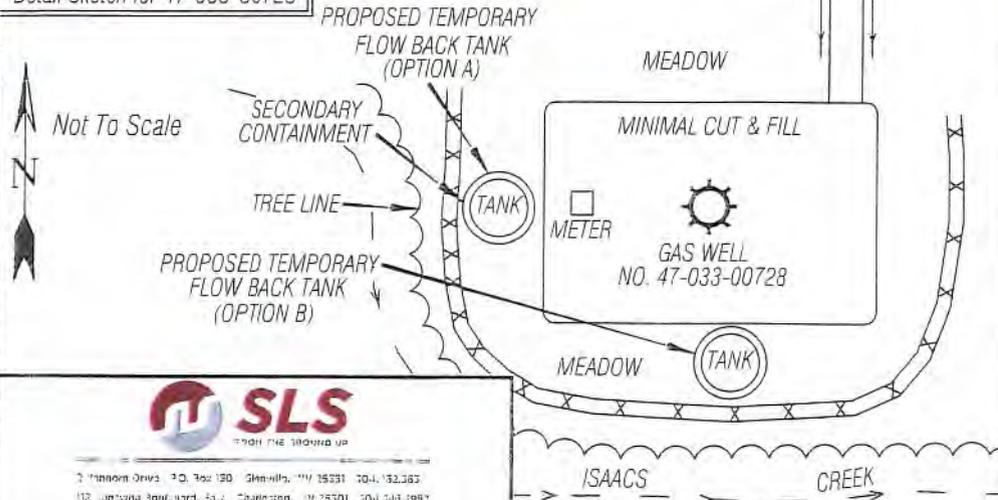

ALL ROADS SHOWN HEREON ARE EXISTING UNLESS OTHERWISE NOTED AND SHALL BE MAINTAINED IN ACCORDANCE WITH WV D.E.P. OIL AND GAS BMP MANUAL ENTRANCES AT COUNTY/STATE ROADS SHALL BE MAINTAINED IN ACCORDANCE WITH WV D.O.T. REGULATION. SEPARATE PERMITS MAY BE REQUIRED BY THE D.O.T.

SEDIMENT BASINS (TRAPS) AND APPROPRIATE EROSION CONTROL BARRIERS ARE TO BE CONSTRUCTED AT ALL CULVERT AND CROSS DRAIN INLETS AND OUTLETS AS REQUIRED IN THE WV D.E.P. OIL AND GAS BMP MANUAL. FIELD CONDITIONS (ROCK OUTCROPS AND BEDROCK) MAY PROHIBIT INLET TRAPS BEING INSTALLED. WHEN THESE CONDITIONS EXIST ADDITIONAL EROSION CONTROL MEASURES SHALL BE EVALUATED AND UTILIZED AS NEEDED.

EARTHWORK CONTRACTORS ARE RESPONSIBLE FOR NOTIFICATION TO THE OPERATOR AND INSPECTOR PRIOR TO ANY DEVIATION FROM THIS PLAN.

TEMPORARY SEED & MULCH ALL SLOPES AFTER CONSTRUCTION OF LOCATION.

CUT & STACK ALL MARKETABLE TIMBER.

STACKED BRUSH MAY BE USED FOR SEDIMENT CONTROL.

APPLICATIONS FOR SEPARATE PLC PERMITS ON THE ACCESS ROAD STREAM CROSSINGS HAVE BEEN PREPARED (IF APPLIES).

- = EXISTING CULVERT
- = PROPOSED CULVERT 15' MIN UNLESS OTHERWISE NOTED
- = PROPOSED STREAM CROSSING
- = APPROXIMATE LIMITS OF DISTURBANCE



2 Freedom Drive P.O. Box 180 Glenville, WV 26031 704.323.267
 112 Limestone Road, 6th Fl. Charleston, WV 25301 204.243.1997
 150 East Technology Plaza, 3rd Floor, WV 25707 204.399.2296

TOPO SECTION OF WEST MILFORD
7.5' TOPO QUADRANGLE

DRAWN BY CPM	FILE NO. 8707	DATE 08-18-20	CADD FILE: 8707RECR.dwg
-----------------	------------------	------------------	----------------------------