

WW-7
5-02



West Virginia Department of Environmental Protection
Office of Oil and Gas
WELL LOCATION FORM: GPS

API: 47-033-00760 WELL NO.: 8021

FARM NAME: ROBERT WAGONER

RESPONSIBLE PARTY NAME: CNX GAS COMPANY LLC

COUNTY: HARRISON DISTRICT: UNION

QUADRANGLE: WOLF SUMMIT

SURFACE OWNER: FRANCES L. LOWE

ROYALTY OWNER: CONSOL GAS COMPANY

UTM GPS NORTHING: 4,344,720.08 METERS

UTM GPS EASTING: 547,634.87 METERS GPS ELEVATION: 401.12 METERS (1315')

The Responsible Party named above has chosen to submit GPS coordinates in lieu of preparing a new well location plat for a plugging permit on the above well. The Office of Oil and Gas will not accept GPS coordinates that do not meet the following requirements:

1. Datum: NAD 1983, Zone: 17 Coordinate Units: meters Altitude: Height above mean sea level (MSL) - meters
2. Accuracy to Datum - 3.05 meters
3. Data Collection Method: Survey Grade GPS : Post Processed Differential Real-Time Differential
Mapping Grade GPS : Post Processed Differential Real-Time Differential


I the undersigned hereby state this data is correct to the best of my knowledge and belief and shows all the information required by law and the regulation issued and prescribed by the Office of Oil and Gas.

Received
Office of Oil & Gas
MAR 25 2015
Received
Office of Oil & Gas
MAR 11 2015

Signature Stephen D. Losh, PS #674

Title WV Professional Surveyor #674

Date 11/13/14

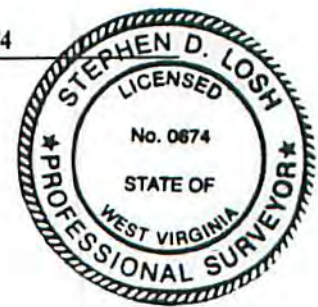

CNX USE: NAD 27 WV NORTH SPC: 8021 = 274,729.75' 1,731,496.82' ELEV. = 1316.01'



Office of Oil & Gas
 MAR 11 2015
 Received
 Office of Oil & Gas
 MAR 25 2015

LAND SURVEYING SERVICES
 21 CEDAR LANE
 BRIDGEPORT, WV 26330
 PHONE: 304-842-2018 OR 5762

DRAWINGS TO ACCOMPANY FORM WW-9	
CNX GAS COMPANY LLC	
P. O. BOX 1248	
JANE LEW, WV 26378	
WATERSHED:	SYCAMORE CREEK
DISTRICT:	UNION COUNTY: HARRISON
QUADRANGLE:	WOLF SUMMIT WELL NO.: 8021
DATE:	11/13/14 PAGE ___ of ___