

WW-7
8-30-06



West Virginia Department of Environmental Protection
Office of Oil and Gas
WELL LOCATION FORM: GPS

API: 47-033-00907 WELL NO.: WV 656986 (H. H. Husted #1796)

FARM NAME: H. H. Husted

RESPONSIBLE PARTY NAME: EQT Production Company

COUNTY: Harrison DISTRICT: Sardis - Outside

QUADRANGLE: Wallace 7.5'

SURFACE OWNER: Paul J. & Alberta Arnett

ROYALTY OWNER: Margaret Smith, et al.

UTM GPS NORTHING: 4359706

UTM GPS EASTING: 549137 GPS ELEVATION: 443 m (1453 ft)

The Responsible Party named above has chosen to submit GPS coordinates in lieu of preparing a new well location plat for a plugging permit or assigned API number on the above well. The Office of Oil and Gas will not accept GPS coordinates that do not meet the following requirements:

1. Datum: NAD 1983, Zone: 17 North, Coordinate Units: meters, Altitude: height above mean sea level (MSL) – meters.
2. Accuracy to Datum – 3.05 meters
3. Data Collection Method:

Survey grade GPS _____ : Post Processed Differential _____
Real-Time Differential _____
Mapping Grade GPS X : Post Processed Differential X
Real-Time Differential _____

4. **Letter size copy of the topography map showing the well location.**

I the undersigned, hereby certify this data is correct to the best of my knowledge and belief and shows all the information required by law and the regulations issued and prescribed by the Office of Oil and Gas.


Signature

PS# 2180
Title

9/26/18
Date

RECEIVED
Office of Oil and Gas
OCT 17 2018
WV Department of
Environmental Protection


Topo Quad: Wallace 7.5' Scale: 1" = 2000'

County: Harrison Date: September 26, 2018

District: Sardis-Outside Project No: 70-36-00-08

47-033-00907 WV 656986 (H. H. Husted #1796)

Topo

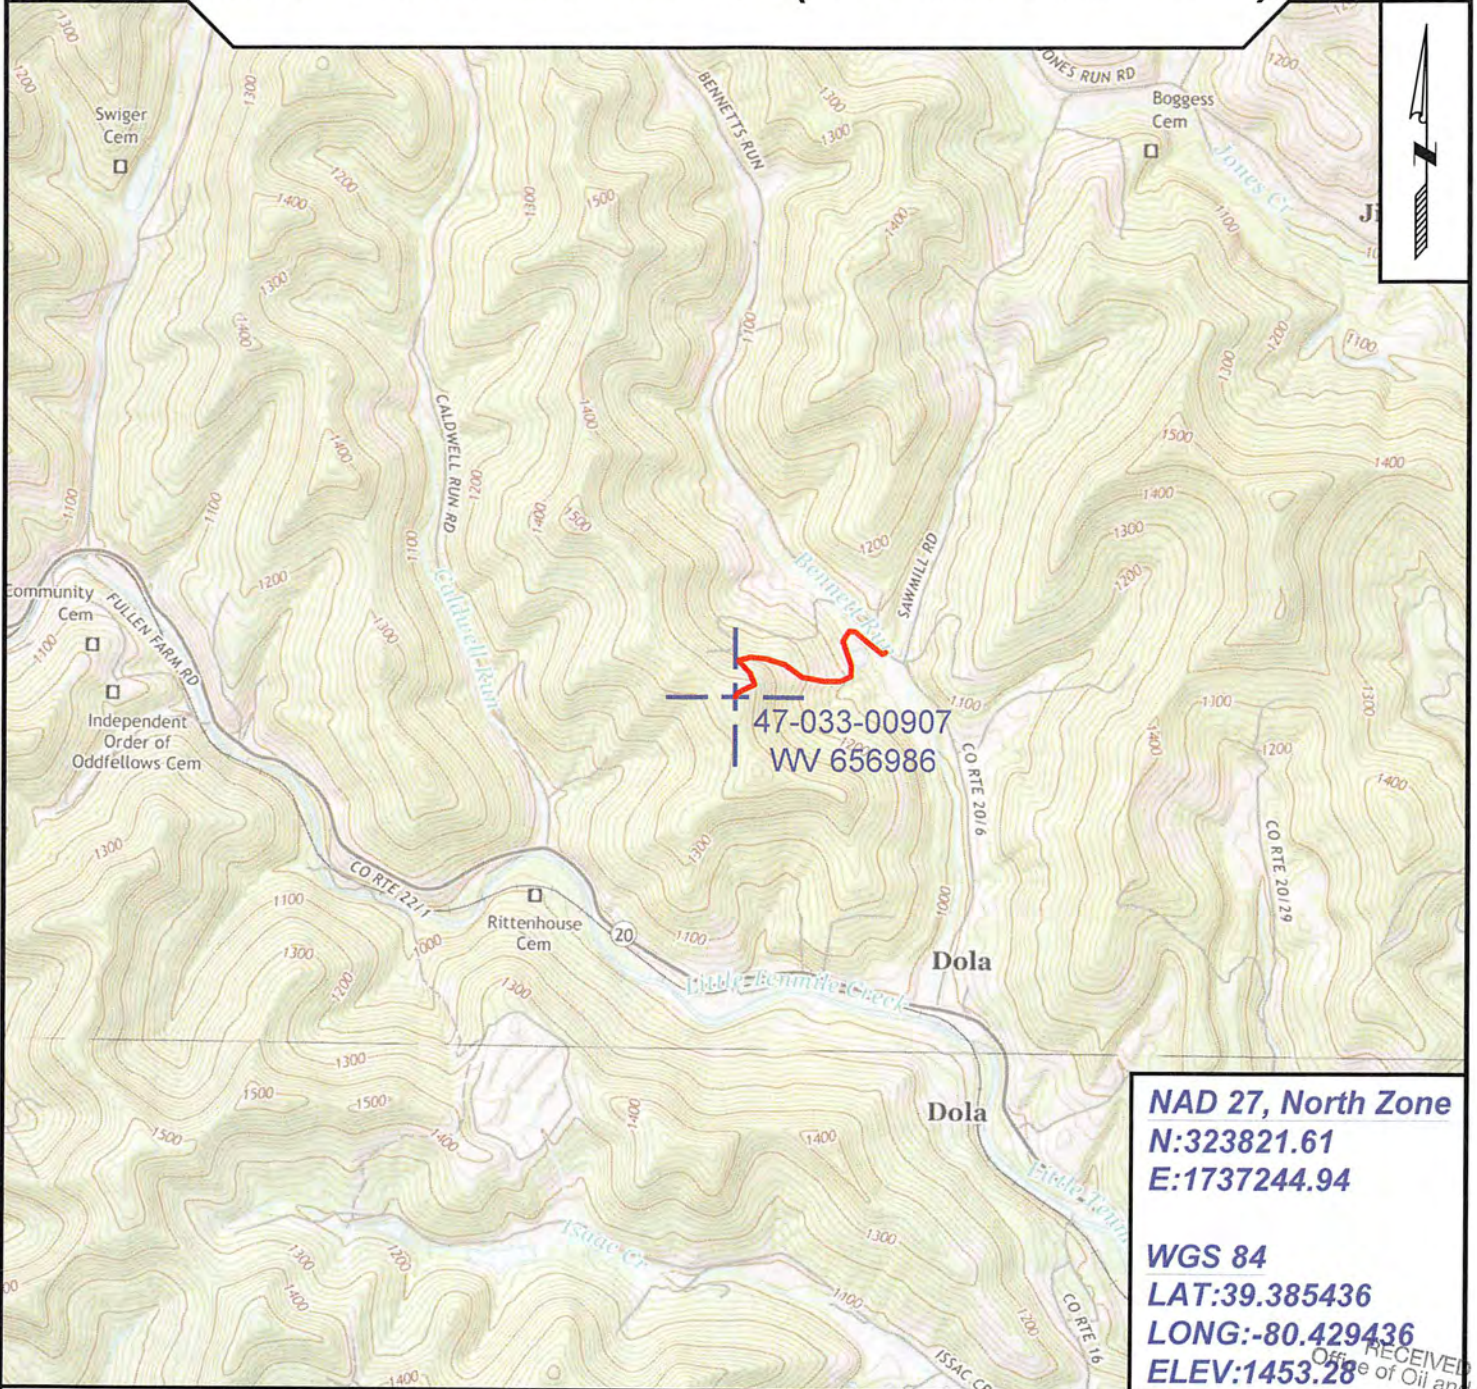

NAD 27, North Zone
N:323821.61
E:1737244.94

WGS 84
LAT:39.385436
LONG:-80.429436
ELEV:1453.28



SURVEYING AND MAPPING SERVICES PERFORMED BY:
ALLEGHENY SURVEYS, INC.
 1-800-482-8606
 237 Birch River Road
 Birch River, WV 26610
 PH: (304) 649-8606
 FAX: (304) 649-8608

PREPARED FOR:
EQT Production Company
 2400 Ansys Drive
 Canonsburg, PA 15317

RECEIVED
 Office of Oil and Gas
 OCT 17 2018
 Department of Environmental Protection