

47-033-01131P

WW-7
8-30-06



West Virginia Department of Environmental Protection
Office of Oil and Gas
WELL LOCATION FORM: GPS

API: 47-033-01131 WELL NO.: E. Southern 1 S-228

FARM NAME: E. Southern

RESPONSIBLE PARTY NAME: Jerry L. Jackson

COUNTY: Harrison DISTRICT: Sardis

QUADRANGLE: Clarksburg/Wolf Summit

SURFACE OWNER: Michael L. Southern & Edward Allen Southern

ROYALTY OWNER: E. Southern

UTM GPS NORTHING: 4351786.5

UTM GPS EASTING: 551031.7 GPS ELEVATION: 1440'

The Responsible Party named above has chosen to submit GPS coordinates in lieu of preparing a new well location plat for a plugging permit or assigned API number on the above well. The Office of Oil and Gas will not accept GPS coordinates that do not meet the following requirements:

1. Datum: NAD 1983, Zone: 17 North, Coordinate Units: meters, Altitude: height above mean sea level (MSL) – meters.
2. Accuracy to Datum – 3.05 meters
3. Data Collection Method:

Survey grade GPS ____: Post Processed Differential ____
Real-Time Differential ____

Mapping Grade GPS ____: Post Processed Differential ____
Real-Time Differential ____

4. **Letter size copy of the topography map showing the well location.**


I the undersigned, hereby certify this data is correct to the best of my knowledge and belief and shows all the information required by law and the regulations issued and prescribed by the Office of Oil and Gas.

Signature

Land Manager
Title

8/1/2019
Date

RECEIVED
Office of Oil and Gas
AUG 15 2019
WV Department of
Environmental Protection

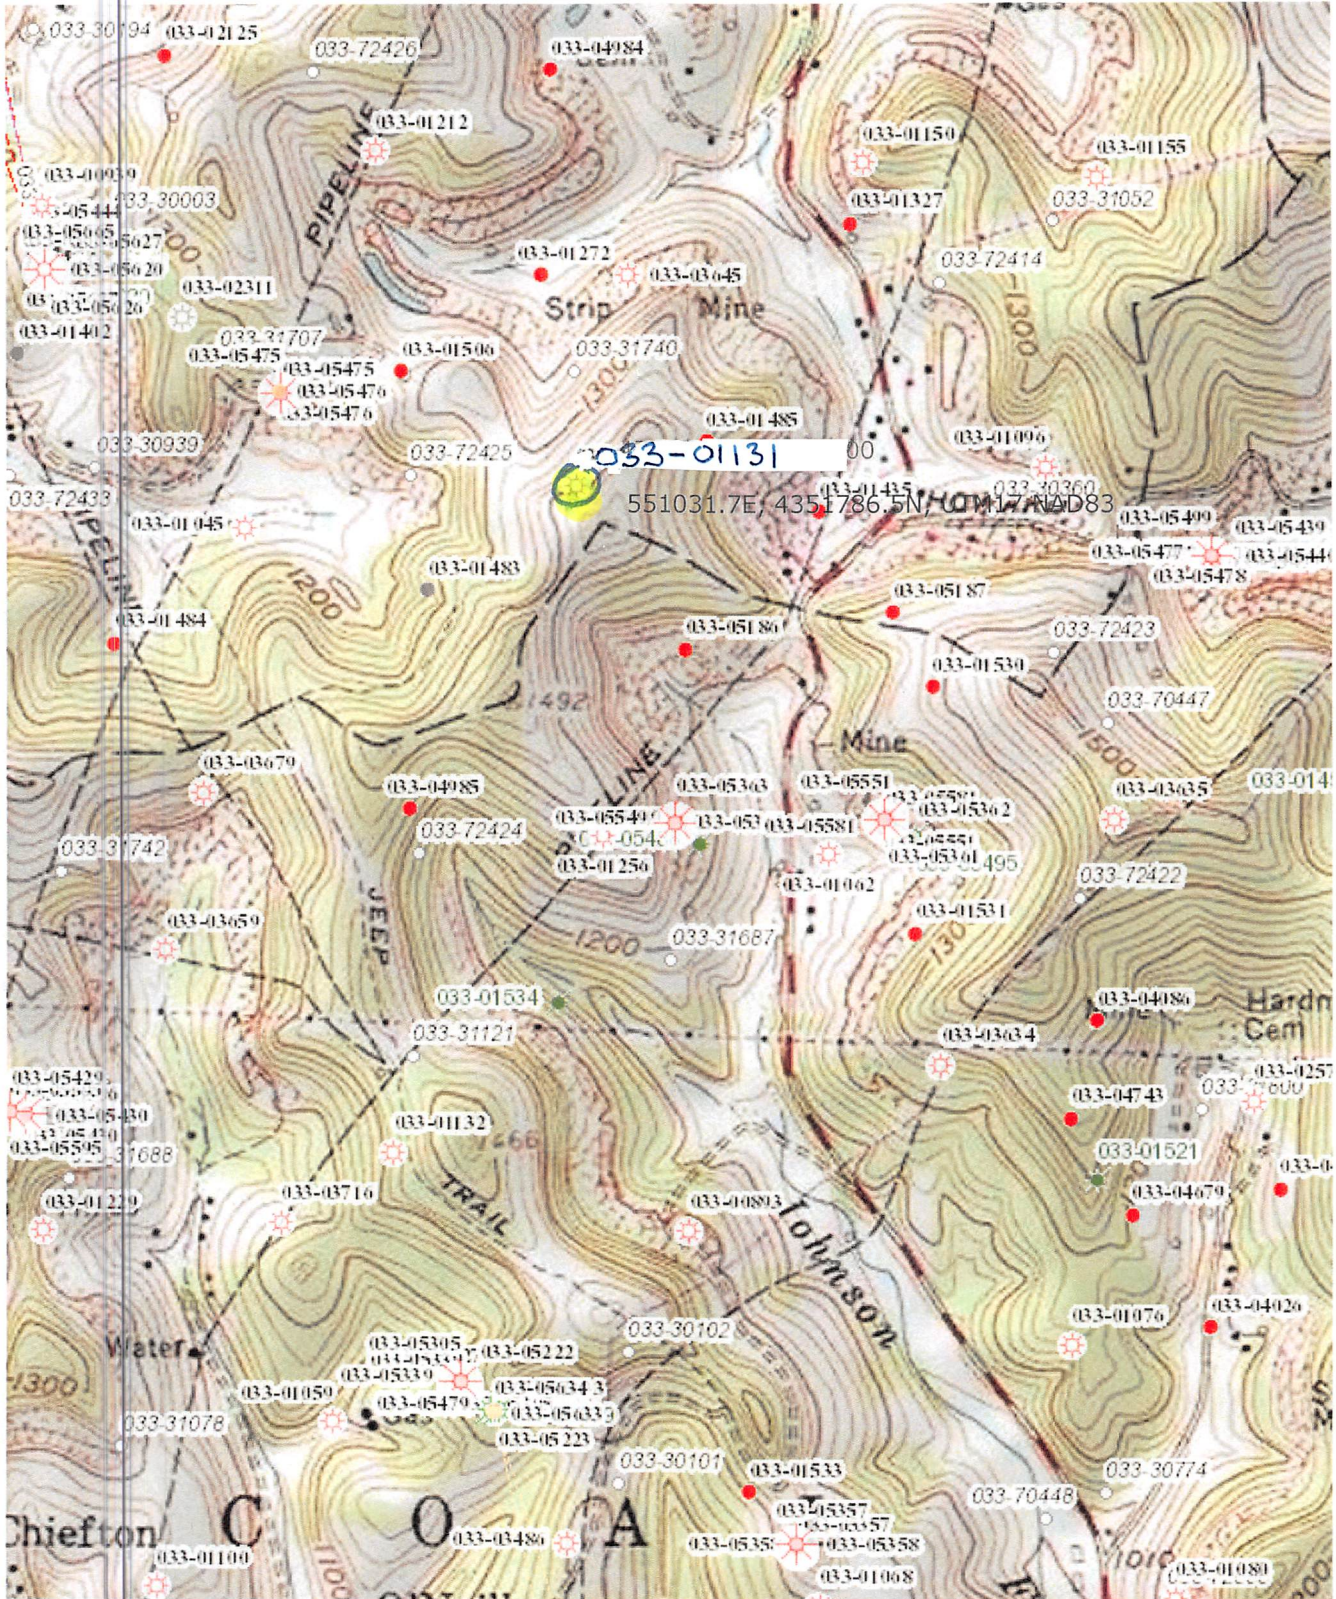


47-033-01131P



E. SOUTHERN #1 S-228

77

Date Printed: 2019-01-23

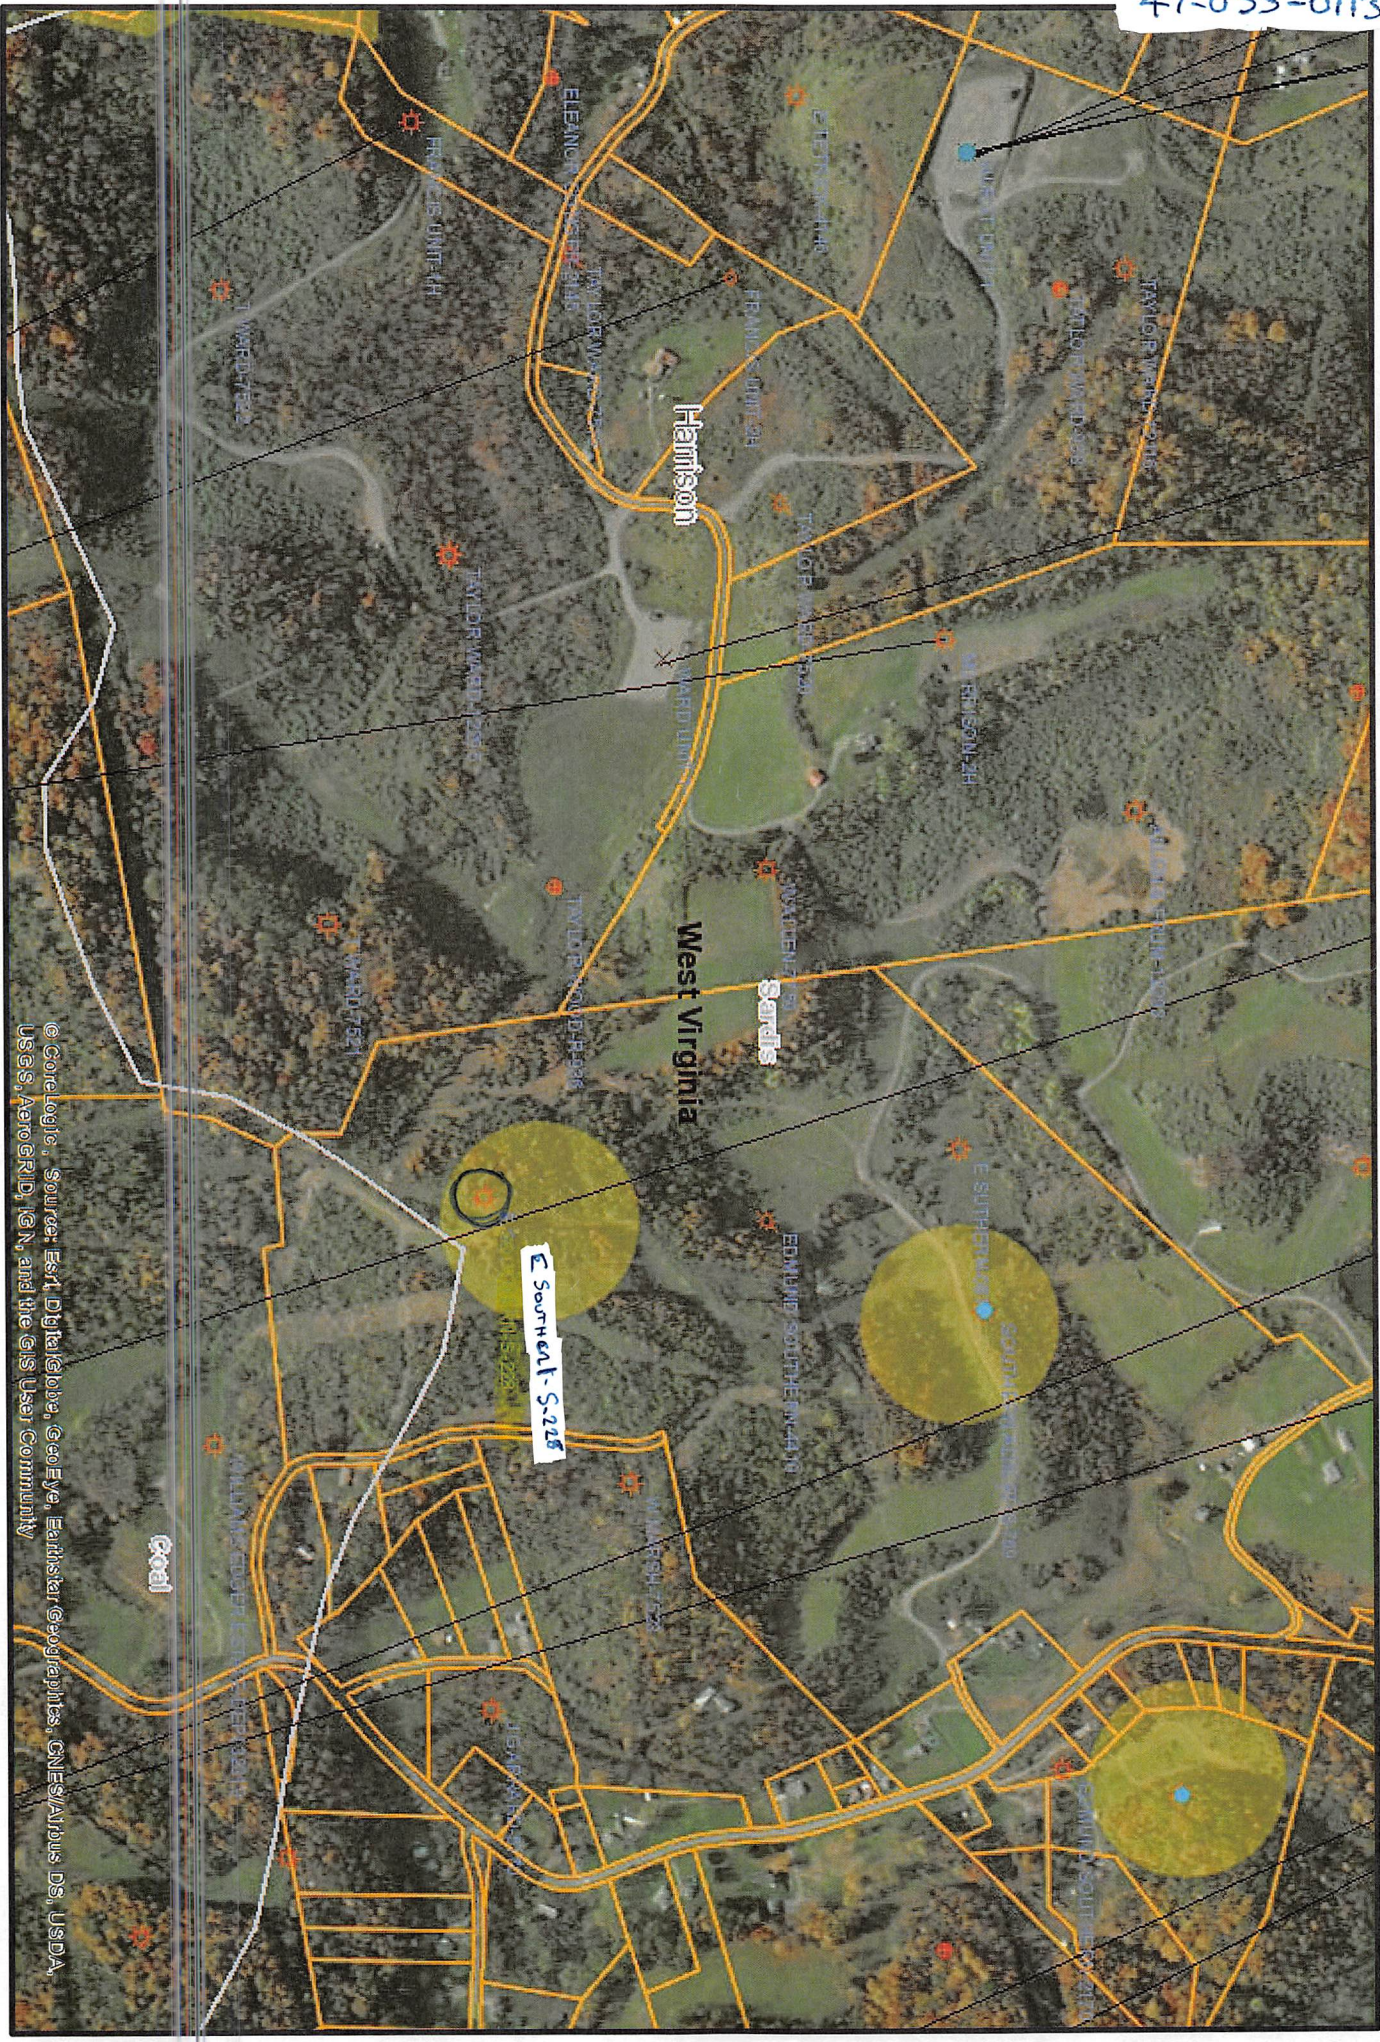

©Coriolis, Source: Esri, DigitalGlobe, GeoEye, Earthstar Geographics, CNES/Airbus DS, USDA, USGS, AeroGRID, IGN, and the GIS User Community

(cont)