

3301322P

WW-7
5-02



West Virginia Department of Environmental Protection
Office of Oil and Gas
WELL LOCATION FORM: GPS

API: 47-033-01322 WELL NO.: 7010
FARM NAME: H. W. WILLIAMS
RESPONSIBLE PARTY NAME: CNX GAS COMPANY LLC
COUNTY: HARRISON DISTRICT: UNION
QUADRANGLE: WEST MILFORD 7.5 MIN.
SURFACE OWNER: SAMUEL STARK, ET. AL.
ROYALTY OWNER: SAMUEL STARK, ET. AL.
UTM GPS NORTHING: 4,339,857.64 METERS
UTM GPS EASTING: 550,754.57 METERS GPS ELEVATION: 338.64 METERS 1111.00 FT

The Responsible Party named above has chosen to submit GPS coordinates in lieu of preparing a new well location plat for a plugging permit on the above well. The Office of Oil and Gas will not accept GPS coordinates that do not meet the following requirements:

- 1. Datum: NAD 1983, Zone: 17 Coordinate Units: meters Altitude: Height above mean sea level (MSL) - meters
- 2. Accuracy to Datum - 3.05 meters
- 3. Data Collection Method: Survey Grade GPS : Post Processed Differential Real-Time Differential
Mapping Grade GPS : Post Processed Differential Real-Time Differential

I the undersigned hereby state this data is correct to the best of my knowledge and belief and shows all the information required by law and the regulation issued and prescribed by the Office of Oil and Gas.

Signature [Handwritten Signature]
Stephen D. Losh, PS #674

Title Received WV Professional Surveyor #674


Date 07/21/14

AUG 7 2014



CNX USE: NAD 27 WV NORTH SPC: 7010 = 258,603.16' W, 1,741,468.20' N, ELEV: 1111.00 FT

Office of Oil and Gas

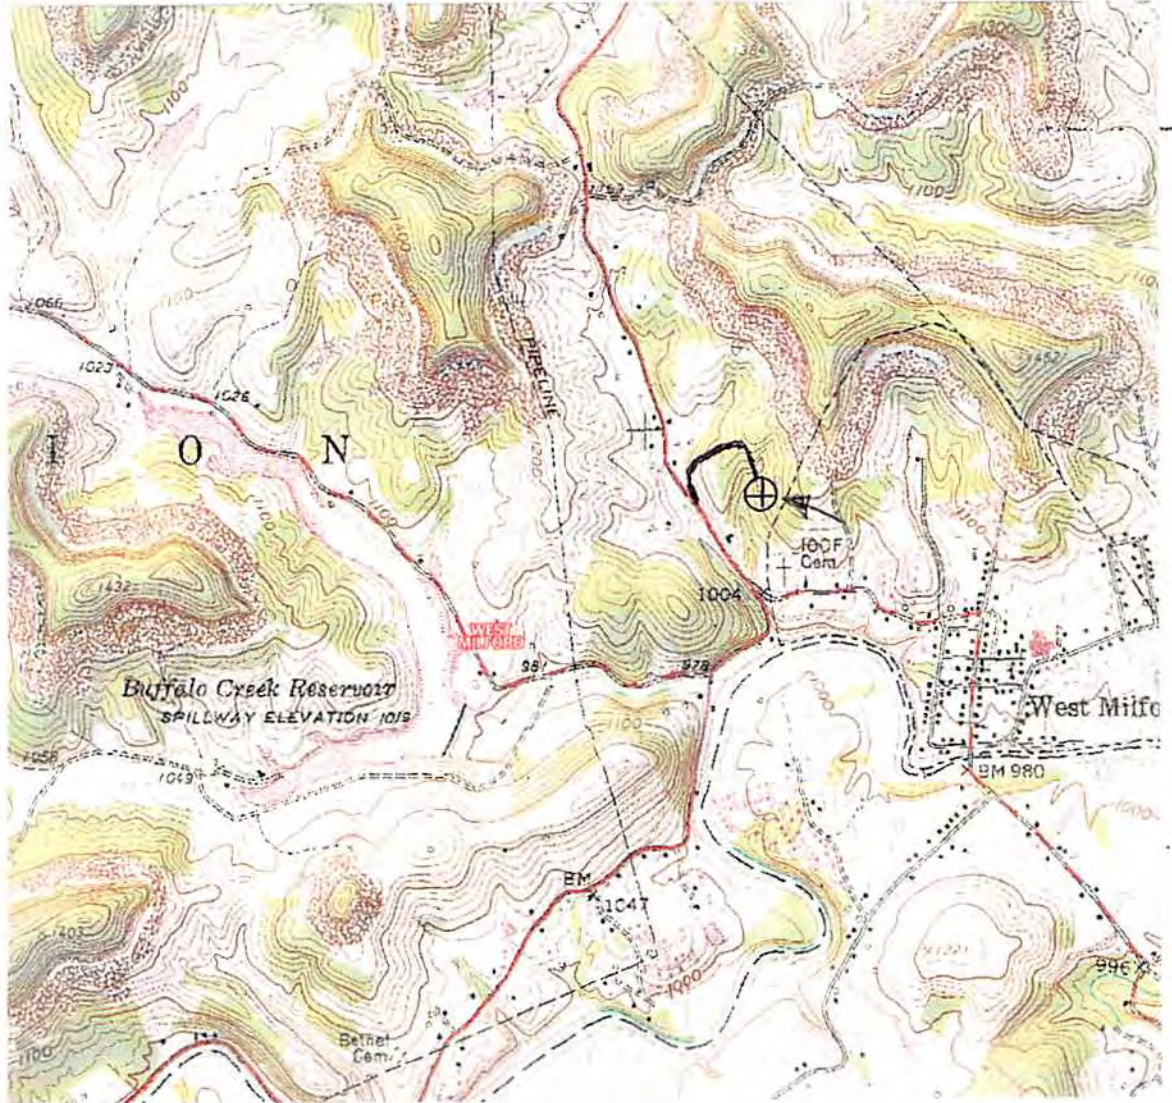

Received

AUG 7 2014

Office of Oil and Gas
WV Dept. of Environmental Protection

LAND SURVEYING SERVICES
21 CEDAR LANE
BRIDGEPORT, WV 26330
PHONE: 304-842-2018 OR 5762

DRAWINGS TO ACCOMPANY FORM WW-9	
CNX GAS COMPANY LLC	
P. O. BOX 1248	
JANE LEW, WV 26378	
WATERSHED:	WEST FORK RIVER
DISTRICT:	UNION COUNTY: HARRISON
QUADRANGLE:	WEST MILFORD WELL NO.: 7010
DATE:	07/21/14 PAGE ___ of ___