

WW-7  
8-30-06



West Virginia Department of Environmental Protection  
Office of Oil and Gas  
**WELL LOCATION FORM: GPS**

API: 47-033-01339 WELL NO.: WV 453091 (C. Pigott W-2594)

FARM NAME: C. Pigott

RESPONSIBLE PARTY NAME: EQT Production Company

COUNTY: Harrison DISTRICT: Clay -02

QUADRANGLE: Shinnston 7.5'

SURFACE OWNER: William Salerno

ROYALTY OWNER: Donna Espenship, et al.

UTM GPS NORTHING: 4362678

UTM GPS EASTING: 557447 GPS ELEVATION: 361 m (1184 ft)

The Responsible Party named above has chosen to submit GPS coordinates in lieu of preparing a new well location plat for a plugging permit or assigned API number on the above well. The Office of Oil and Gas will not accept GPS coordinates that do not meet the following requirements:

1. Datum: NAD 1983, Zone: 17 North, Coordinate Units: meters, Altitude: height above mean sea level (MSL) – meters.
2. Accuracy to Datum – 3.05 meters
3. Data Collection Method:

Survey grade GPS : Post Processed Differential   
Real-Time Differential

Mapping Grade GPS : Post Processed Differential   
Real-Time Differential

4. Letter size copy of the topography map showing the well location.

I the undersigned, hereby certify this data is correct to the best of my knowledge and belief and shows all the information required by law and the regulations issued and prescribed by the Office of Oil and Gas.

Received  
Office of Oil & Gas

APR 18 2016

Steph Ober  
Signature

PS# 2180  
Title

3/25/16  
Date


05/20/2016

Topo Quad: Shinnston 7.5' Scale: 1" = 2000'  
 County: Harrison Date: March 10, 2016  
 District: Clay Project No: 70-36-00-08

Water

# 47-033-01339 WV 453091 (C. Pigott W-2594)

No Potential Water Sources within 1000'

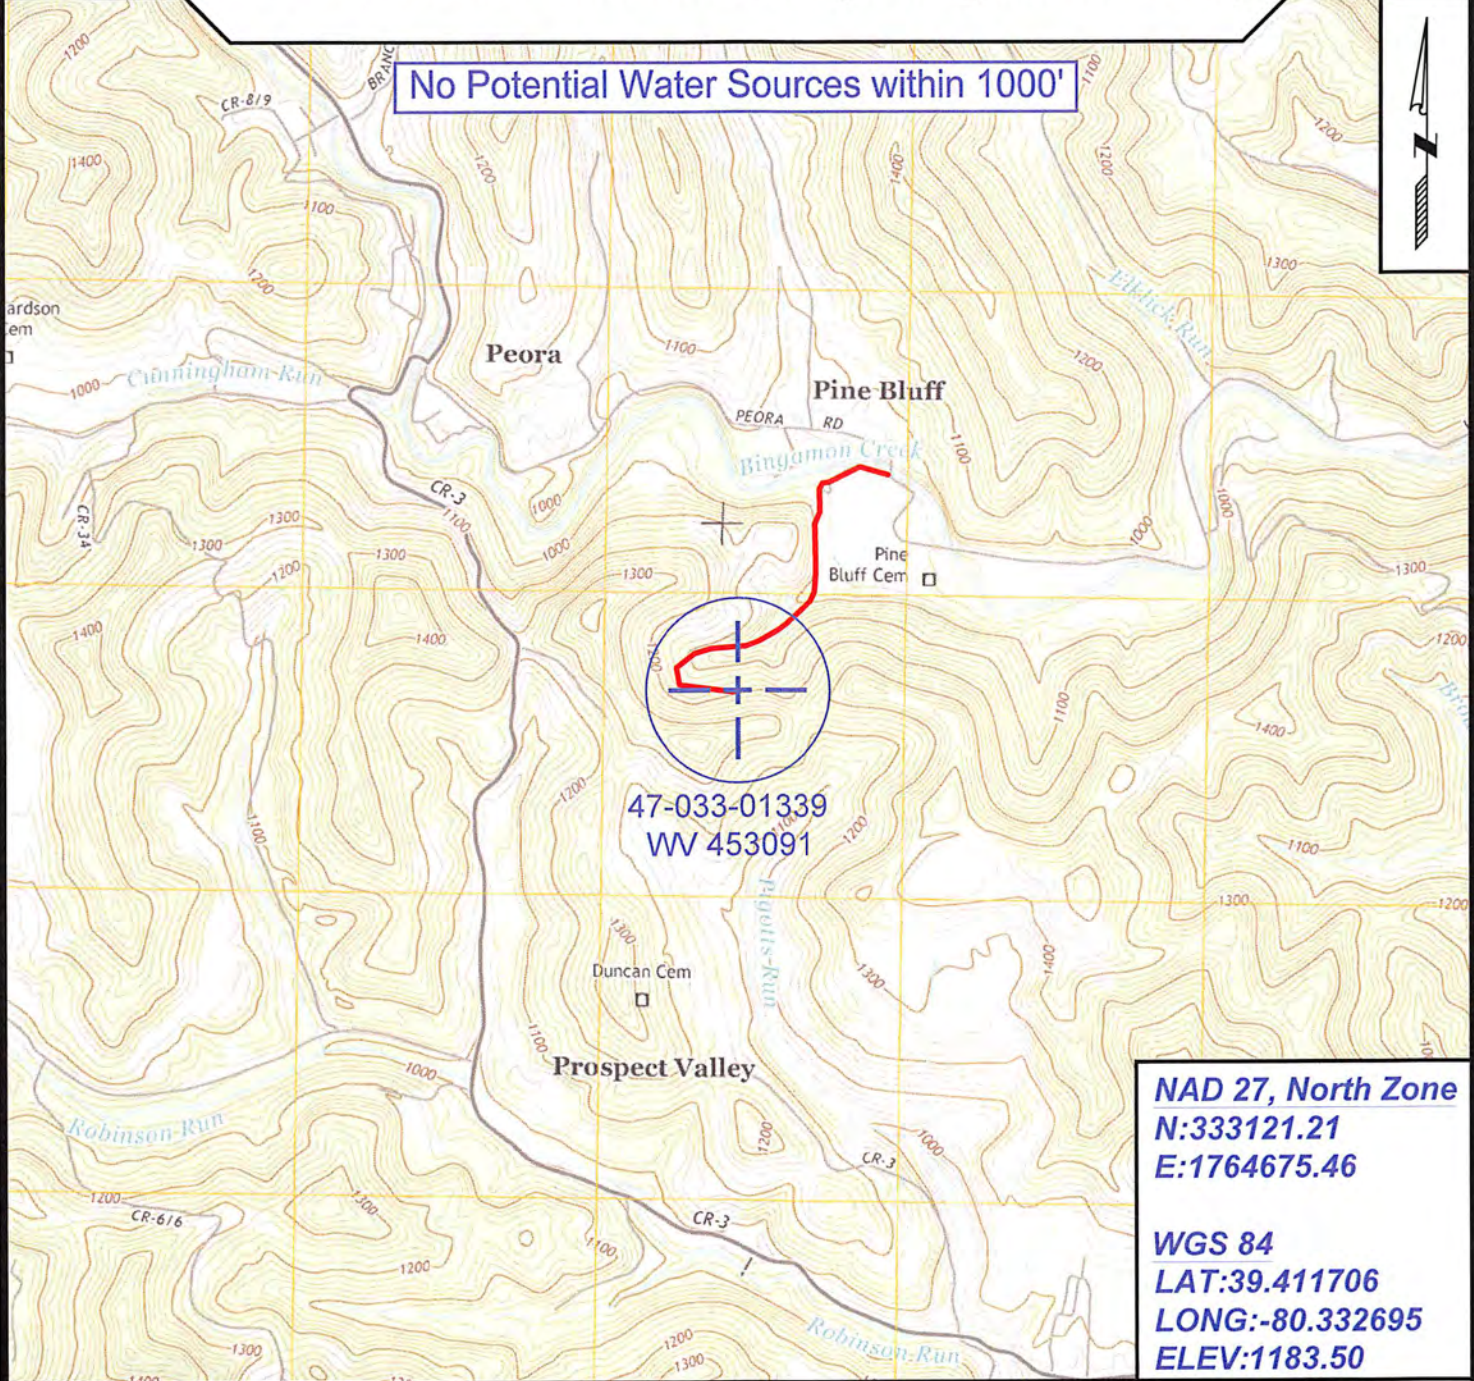

47-033-01339  
WV 453091

**NAD 27, North Zone**  
**N:333121.21**  
**E:1764675.46**

**WGS 84**  
**LAT:39.411706**  
**LONG:-80.332695**  
**ELEV:1183.50**



SURVEYING AND MAPPING SERVICES PERFORMED BY:  
**ALLEGHENY SURVEYS, INC.**  
 1-800-482-8606  
 237 Birch River Road  
 Birch River, WV 26610  
 PH: (304) 649-8606  
 FAX: (304) 649-8608

PREPARED FOR:  
**EQT Production Company**  
 Received  
 Office of Oil and Gas  
 P.O. Box 280  
 Bridgeport, WV 26330  
 APR 18 2016