

3301388 P

WW-7
5-02




West Virginia Department of Environmental Protection
Office of Oil and Gas
WELL LOCATION FORM: GPS

API: 47-033-01388 WELL NO.: 3783
FARM NAME: BEATRICE GRIFFIN
RESPONSIBLE PARTY NAME: CNX GAS COMPANY LLC
COUNTY: HARRISON 33 DISTRICT: EAGLE 4
QUADRANGLE: WALLACE 655
SURFACE OWNER: CONSOLIDATION COAL COMPANY
ROYALTY OWNER: GLEN D. GRIFFIN, ET. AL.
UTM GPS NORTHING: 4,361,870.83 METERS
UTM GPS EASTING: 552,654.44 METERS GPS ELEVATION: 441.56 METERS 1448 FT.

The Responsible Party named above has chosen to submit GPS coordinates in lieu of preparing a new well location plat for a plugging permit on the above well. The Office of Oil and Gas will not accept GPS coordinates that do not meet the following requirements:

- 1. Datum: NAD 1983, Zone: 17 Coordinate Units: meters Altitude: Height above mean sea level (MSL) - meters
- 2. Accuracy to Datum - 3.05 meters
- 3. Data Collection Method: Survey Grade GPS ; Post Processed Differential Real-Time Differential
Mapping Grade GPS ; Post Processed Differential Real-Time Differential

I the undersigned hereby state this data is correct to the best of my knowledge and belief and shows all the information required by law and the regulation issued and prescribed by the Office of Oil and Gas.

Signature 
Stephen D. Losh, PS #674


Title WV Professional Surveyor #674

Date 08/11/14



CNX USE: NAD 27 WV NORTH SPC: 3783 = 330,734.52' 1,748,905.15' ELEV. = 1448.66'

Office of Oil and Gas
WV Department of Environmental Protection

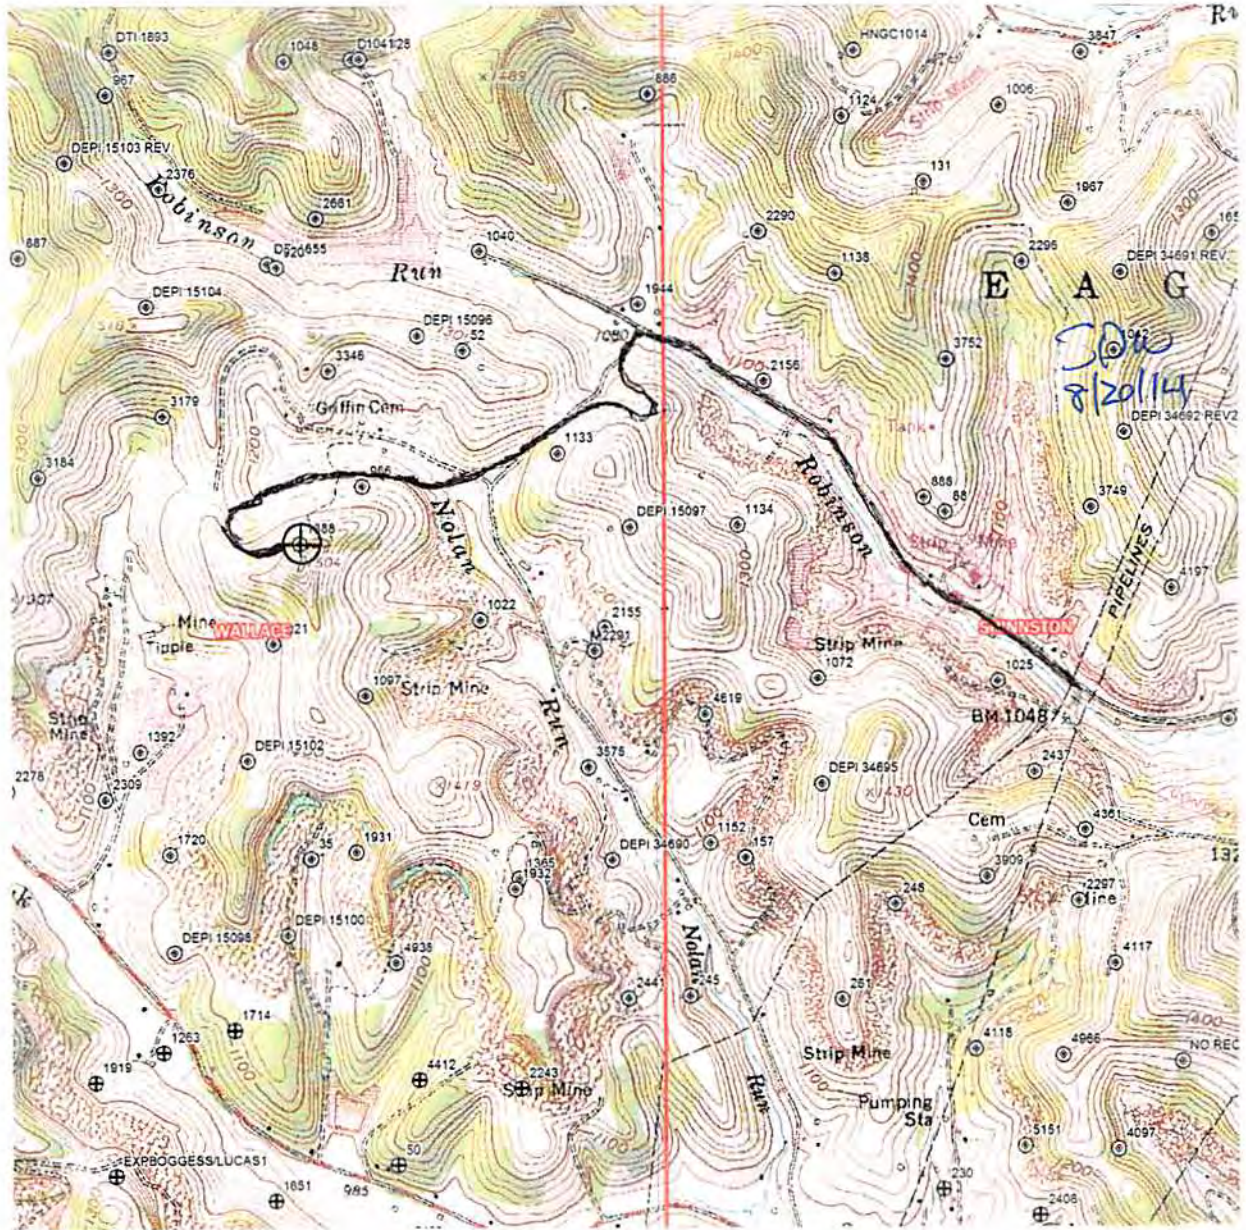

DRAWINGS TO ACCOMPANY FORM WW-9

CNX GAS COMPANY LLC

P. O. BOX 1248

JANE LEW, WV 26378

WATERSHED:

Office of Oil and Gas
NOLAN RUN

DISTRICT: EAGLE

AUG 26 2014

COUNTY: HARRISON

QUADRANGLE:

WALEX 3783
Environmental Protection

DATE: 08/11/14

PAGE of

LAND SURVEYING SERVICES
21 CEDAR LANE
BRIDGEPORT, WV 26330
PHONE: 304-842-2018 OR 5762