

3301501P

WW-7
5-02



West Virginia Department of Environmental Protection
Office of Oil and Gas
WELL LOCATION FORM: GPS

API: 47-033-01501 WELL NO.: 7044

FARM NAME: GAY DUNCAN

RESPONSIBLE PARTY NAME: CNX GAS COMPANY LLC

COUNTY: HARRISON DISTRICT: CLARK-CLARKSBURG

QUADRANGLE: CLARKSBURG

SURFACE OWNER: GENESIS YOUTH CENTER, INC.

ROYALTY OWNER: VLH GROUP, LLC

UTM GPS NORTHING: 4,347,750.56 METERS

UTM GPS EASTING: 556,387.60 METERS GPS ELEVATION: 353.67 METERS (1160')

Received
Office of Oil & Gas
MAR 25 2015

The Responsible Party named above has chosen to submit GPS coordinates in lieu of preparing a new well location plat for a plugging permit on the above well. The Office of Oil and Gas will not accept GPS coordinates that do not meet the following requirements:

- Datum: NAD 1983, Zone: 17 Coordinate Units: meters Altitude: Height above mean sea level (MSL) - meters
- Accuracy to Datum - 3.05 meters
- Data Collection Method: Survey Grade GPS : Post Processed Differential Real-Time Differential
Mapping Grade GPS : Post Processed Differential Real-Time Differential

I the undersigned hereby state this data is correct to the best of my knowledge and belief and shows all the information required by law and the regulation issued and prescribed by the Office of Oil and Gas.

Signature 
Stephen D. Losh, PS #674


Title WV Professional Surveyor #674

Date 11/12/14

Received
Office of Oil & Gas
MAR 11 2015



CNX USE: NAD 27 WV NORTH SPC: 7044 = 284,195.72' 1,760,383.85' ELEV. = 1160.33'

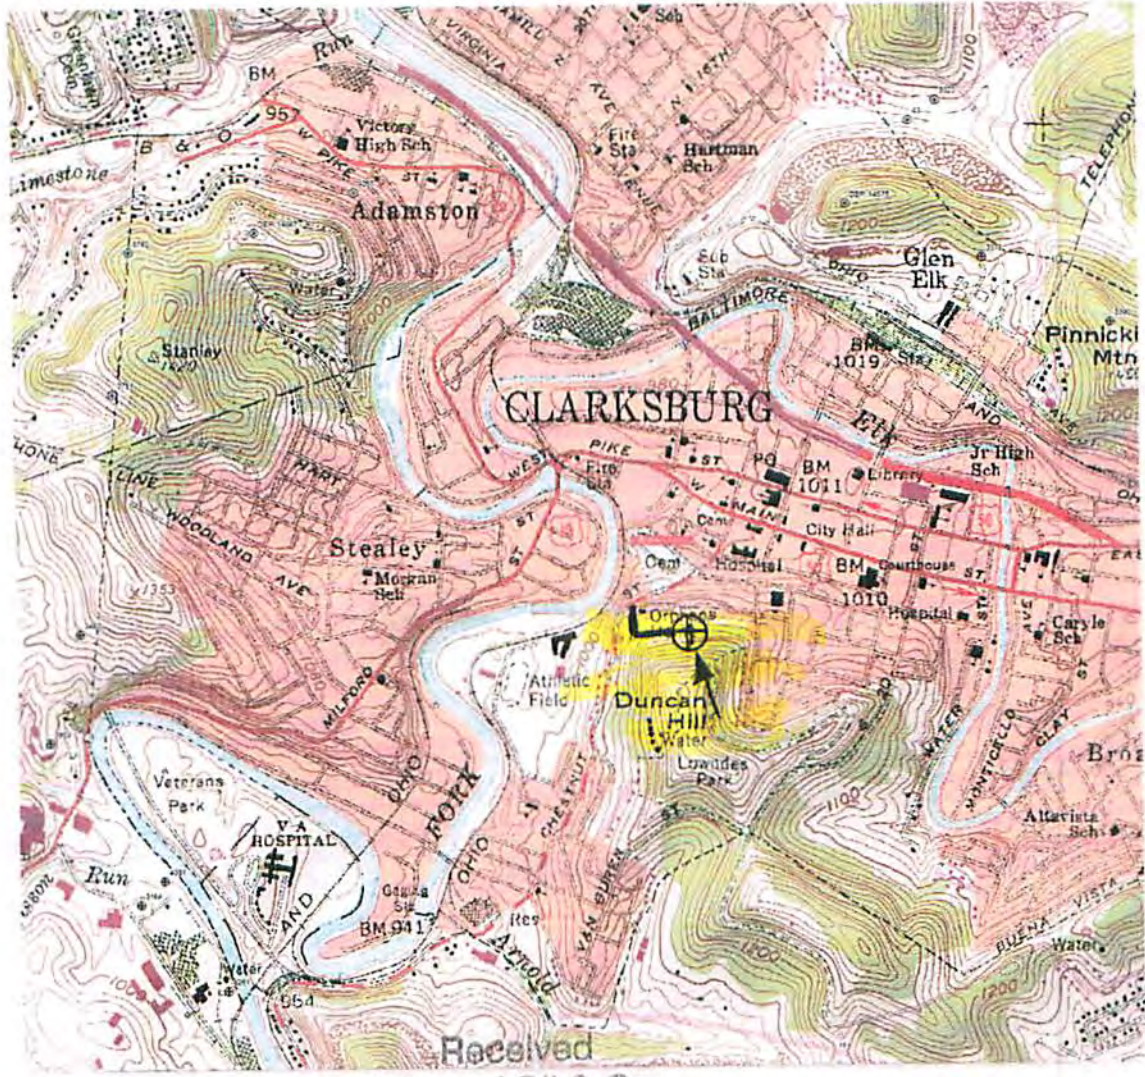

Received
Office of Oil & Gas
MAR 25 2015

SDW
319115

Received
Office of Oil & Gas
MAR 11 2015

DRAWINGS TO ACCOMPANY FORM WW-9	
CNX GAS COMPANY LLC	
P. O. BOX 1248	
JANE LEW. WV 26378	
WATERSHED:	WEST FORK RIVER
DISTRICT:	CLARK COUNTY: HARRISON
QUADRANGLE:	CLARKSBURG WELL NO.: 7044
DATE:	11/12/14 PAGE of

LAND SURVEYING SERVICES
21 CEDAR LANE
BRIDGEPORT, WV 26330
PHONE: 304-842-2018 OR 5762