



West Virginia Department of Environmental Protection  
Office of Oil and Gas  
WELL LOCATION FORM: GPS

API: 47-033-01527 WELL NO.: 7047  
FARM NAME: W. L. HURST  
RESPONSIBLE PARTY NAME: CNX GAS COMPANY LLC  
COUNTY: HARRISON DISTRICT: COAL 3  
QUADRANGLE: WOLF SUMMIT 7.5 MIN. 692  
SURFACE OWNER: CARL LEE GALLO  
ROYALTY OWNER: APPALACHIAN ROYALTIES, INC., ET. AL.  
UTM GPS NORTHING: 4,350,187.97 METERS  
UTM GPS EASTING: 548,694.91 METERS GPS ELEVATION: 404.69 METERS

The Responsible Party named above has chosen to submit GPS coordinates in lieu of preparing a new well location plat for a plugging permit on the above well. The Office of Oil and Gas will not accept GPS coordinates that do not meet the following requirements:

1. Datum: NAD 1983, Zone: 17 Coordinate Units: meters Altitude: Height above mean sea level (MSL) - meters
2. Accuracy to Datum - 3.05 meters
3. Data Collection Method: Survey Grade GPS  : Post Processed Differential  Real-Time Differential   
Mapping Grade GPS  : Post Processed Differential  Real-Time Differential

I the undersigned hereby state this data is correct to the best of my knowledge and belief and shows all the information required by law and the regulation issued and prescribed by the Office of Oil and Gas.

Signature   
Stephen D. Losh, PS #674

Title WV Professional Surveyor #674


Date 07/29/14



CNX USE: NAD 27 WV NORTH SPC: 7047 = 292,614.47' 1,735,273.91' ELEV. = 1327.70'

WV Department of Environmental Protection



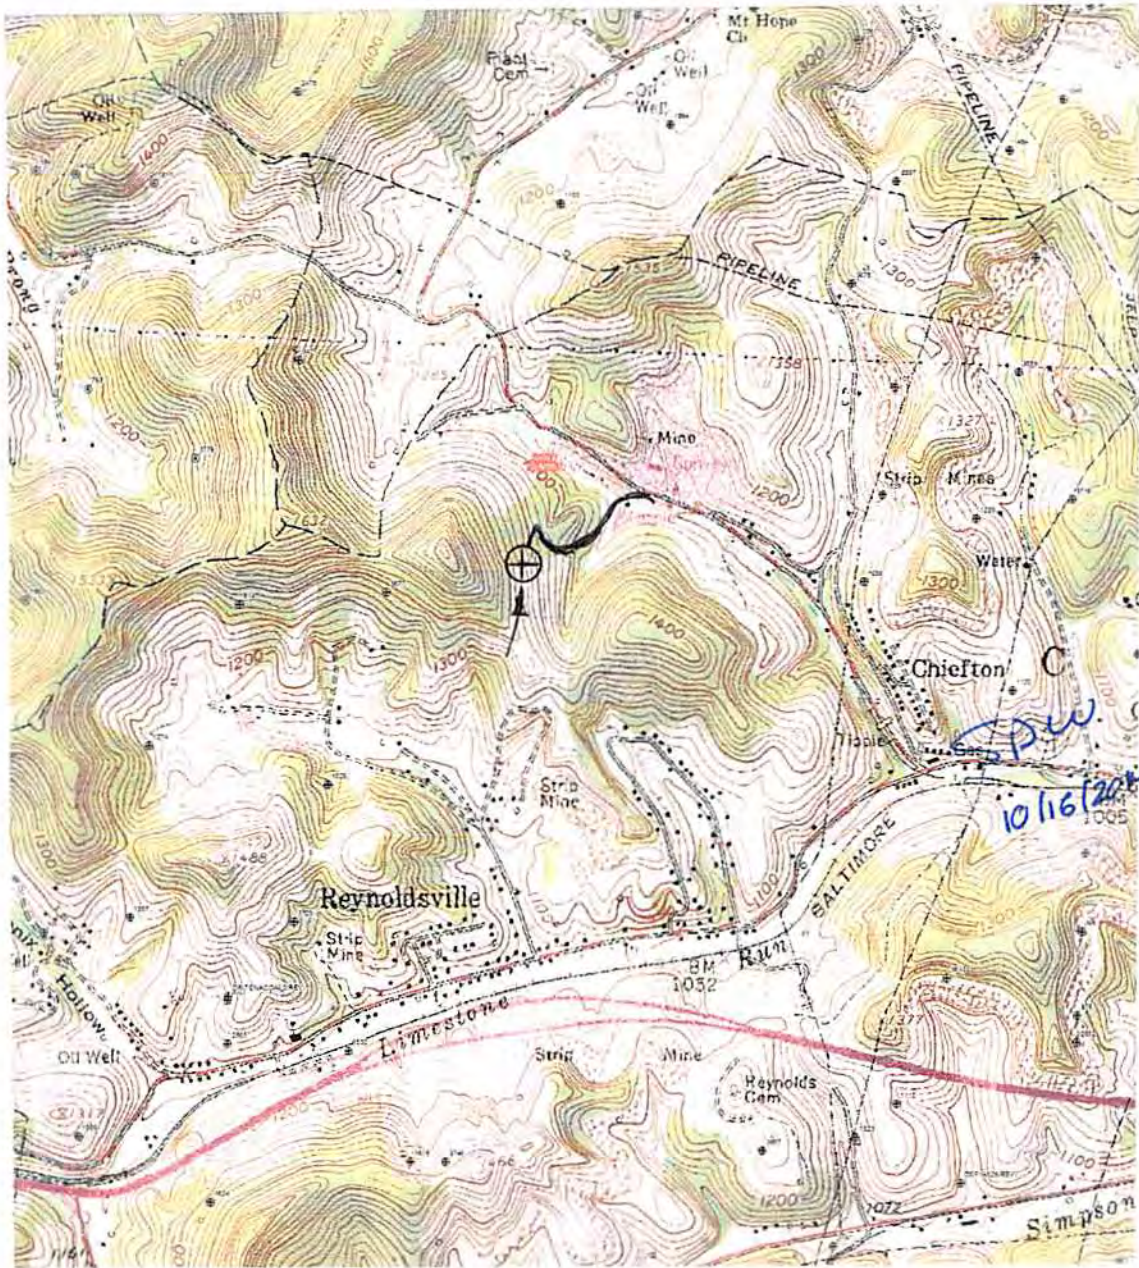

DRAWINGS TO ACCOMPANY FORM WW-9

CNX GAS COMPANY LLC

P. O. BOX 1248

JANE LEW, WV 26378

WATERSHED: Limestone Run

DISTRICT: COAL COUNTY: HARRISON

QUADRANGLE: WOLF SUMMIT WELL NO: 7047

DATE: 07/29/14 PAGE 1 of 1

LAND SURVEYING SERVICES  
 21 CEDAR LANE  
 BRIDGEPORT, WV 26330  
 PHONE: 304-842-2018 OR 5762

RECEIVED  
 Office of Oil and Gas  
 OCT 22 2014  
 WV Department of  
 Environmental Protection