

WW-7  
8-30-06



West Virginia Department of Environmental Protection  
Office of Oil and Gas  
**WELL LOCATION FORM: GPS**

API: 47-033-01590 WELL NO.: WV 152501 (M. Smith #8137)

FARM NAME: M. Smith

RESPONSIBLE PARTY NAME: EQT Production Company

COUNTY: Harrison DISTRICT: Union - 06

QUADRANGLE: West Milford 7.5' - 669

SURFACE OWNER: Kevin J. Poth

ROYALTY OWNER: EQT Production Company, et al.

UTM GPS NORTHING: 4340400

UTM GPS EASTING: 546671 GPS ELEVATION: 337m (1107 ft)

The Responsible Party named above has chosen to submit GPS coordinates in lieu of preparing a new well location plat for a plugging permit or assigned API number on the above well. The Office of Oil and Gas will not accept GPS coordinates that do not meet the following requirements:

- Datum: NAD 1983, Zone: 17 North, Coordinate Units: meters, Altitude: height above mean sea level (MSL) – meters.
- Accuracy to Datum – 3.05 meters
- Data Collection Method:

Survey grade GPS \_\_\_\_\_ : Post Processed Differential \_\_\_\_\_  
 Real-Time Differential \_\_\_\_\_  
 Mapping Grade GPS X : Post Processed Differential X  
 Real-Time Differential \_\_\_\_\_

- Letter size copy of the topography map showing the well location.

I the undersigned, hereby certify this data is correct to the best of my knowledge and belief and shows all the information required by law and the regulations issued and prescribed by the Office of Oil and Gas.

Steve Brown  
Signature

PS-2180  
Title

WV Department of Environmental Protection  
2/17/2016  
Date


Topo Quad: West Milford 7.5' Scale: 1" = 2000'

County: Harrison Date: April 7, 2016

District: Union Project No: 70-36-00-08

# 47-033-01590 WV 152501 (M. Smith #8137)

Topo

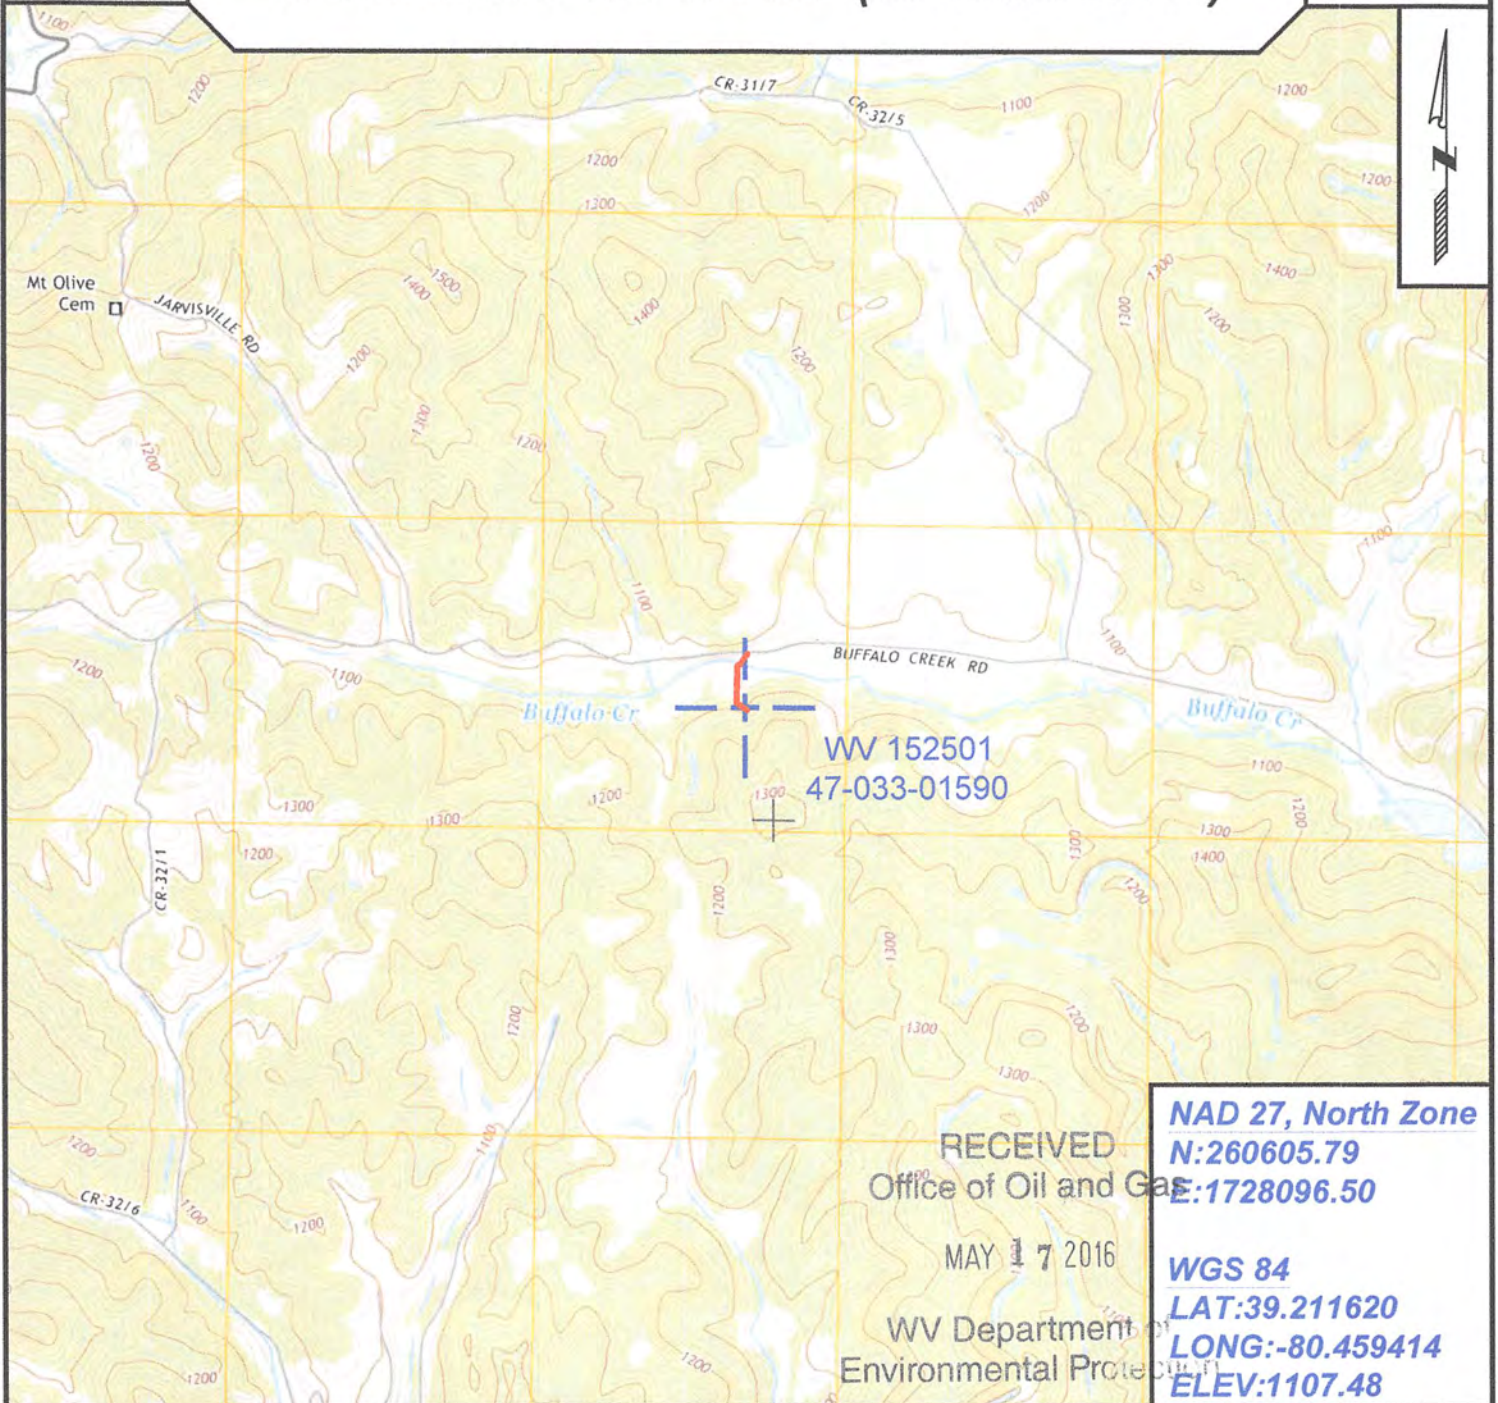

SURVEYING AND MAPPING SERVICES PERFORMED BY:  
**ALLEGHENY SURVEYS, INC.**  
 1-800-482-8606  
 237 Birch River Road  
 Birch River, WV 26610  
 PH: (304) 649-8606  
 FAX: (304) 649-8608

PREPARED FOR:  
**EQT Production Company**  
 P.O. Box 280  
 Bridgeport, WV 26330

06/17/2016