



West Virginia Department of Environmental Protection
Office of Oil and Gas
WELL LOCATION FORM: GPS

API: 47-033-01649 WELL NO.: WV 651161 (Kyle #412)

FARM NAME: J. W. Kyle

RESPONSIBLE PARTY NAME: EQT Production Company

COUNTY: Harrison DISTRICT: Sardis

QUADRANGLE: Wolf Summit 7.5'

SURFACE OWNER: Edward Kyle, et al.

ROYALTY OWNER: Edward Kyle, et al.

UTM GPS NORTHING: 4353035

UTM GPS EASTING: 548928 GPS ELEVATION: 431 m (1415 ft)

The Responsible Party named above has chosen to submit GPS coordinates in lieu of preparing a new well location plat for a plugging permit or assigned API number on the above well. The Office of Oil and Gas will not accept GPS coordinates that do not meet the following requirements:

1. Datum: NAD 1983, Zone: 17 North, Coordinate Units: meters, Altitude: height above mean sea level (MSL) – meters.
2. Accuracy to Datum – 3.05 meters
3. Data Collection Method:

Survey grade GPS _____ : Post Processed Differential _____
 Real-Time Differential _____
 Mapping Grade GPS X : Post Processed Differential X
 Real-Time Differential _____

4. Letter size copy of the topography map showing the well location

I the undersigned, hereby certify this data is correct to the best of my knowledge and belief and shows all the information required by law and the regulations issued and prescribed by the Office of Oil and Gas.

[Signature]
Signature

PS# 2180
Title

11/15/17
Date

RECEIVED
Office of Oil and Gas
APR 23 2018
West Virginia Department of Environmental Protection

Topo Quad: Wolf Summit 7.5'

Scale: 1" = 2000'

County: Harrison

Date: November 10, 2017


47 03 30 16 4 9P

District: Sardis

Project No: 70-36-00-08

47-033-01649 WV 651161 (Kyle #412)

Topo

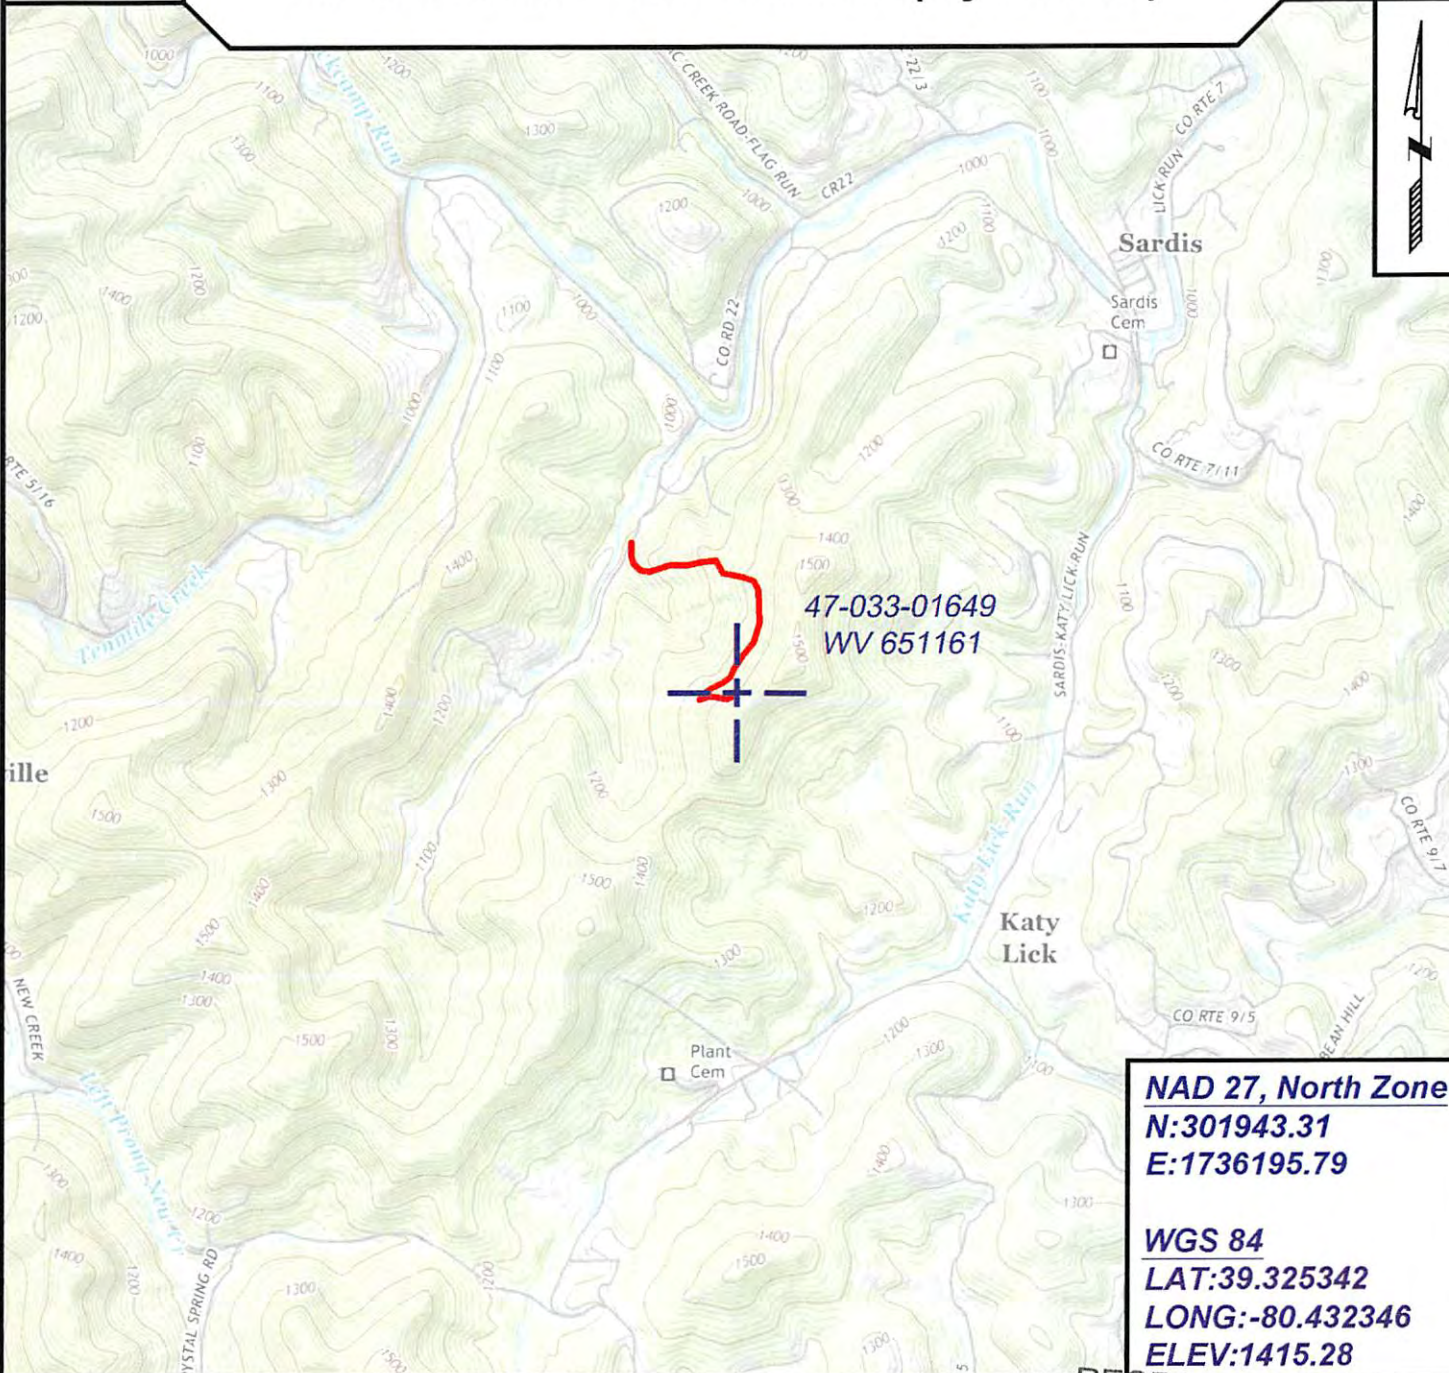

47-033-01649
WV 651161

NAD 27, North Zone
N:301943.31
E:1736195.79

WGS 84
LAT:39.325342
LONG:-80.432346
ELEV:1415.28



SURVEYING AND MAPPING SERVICES PERFORMED BY:

ALLEGHENY SURVEYS, INC.

1-800-482-8606
237 Birch River Road
Birch River, WV 26610
PH: (304) 649-8606
FAX: (304) 649-8608

PREPARED FOR:

EQT Production Company

APR 28 2018
Bridgeport, WV 26330

RECEIVED
Office of Oil and Gas
WV Department of
Environmental Protection

06/15/2018