



West Virginia Department of Environmental Protection
Office of Oil and Gas
WELL LOCATION FORM: GPS

API: 47-033-01665 P WELL NO.: WV 604237 (4237)

FARM NAME: D. E. Martin

RESPONSIBLE PARTY NAME: EQT Production Company, Inc.

COUNTY: Harrison DISTRICT: Sardis

QUADRANGLE: Wolf Summit 7.5'

SURFACE OWNER: Thomas H. & Rebecca D. Downs

ROYALTY OWNER: Joseph S. Wandelt

UTM GPS NORTHING: 4354672

UTM GPS EASTING: 549411 GPS ELEVATION: 306 m (1004 ft)

The Responsible Party named above has chosen to submit GPS coordinates in lieu of preparing a new well location plat for a plugging permit or assigned API number on the above well. The Office of Oil and Gas will not accept GPS coordinates that do not meet the following requirements:

1. Datum: NAD 1983, Zone: 17 North, Coordinate Units: meters, Altitude: height above mean sea level (MSL) – meters.
2. Accuracy to Datum – 3.05 meters
3. Data Collection Method:
Survey grade GPS : Post Processed Differential
Real-Time Differential
Mapping Grade GPS X: Post Processed Differential X
Real-Time Differential

4. **Letter size copy of the topography map showing the well location.**

I the undersigned, hereby certify this data is correct to the best of my knowledge and belief and shows all the information required by law and the regulations issued and prescribed by the Office of Oil and Gas.

Ben A. Sengstacke
Signature
4-25-2012
Date

AS 2092
Title

Topo Quad: Wolf Summit 7.5'

Scale: 1" = 2000' *33-01665P*

County: Harrison

Date: April 25, 2012

District: Sardis


Project No: 70-36-00-08

WV 604237 (47-033-01665)

Topo

N: 307289
E: 1737867
Lat: 39.340064
Long: 80.426632
El: 1004.49

47-033-01665
WV 604237

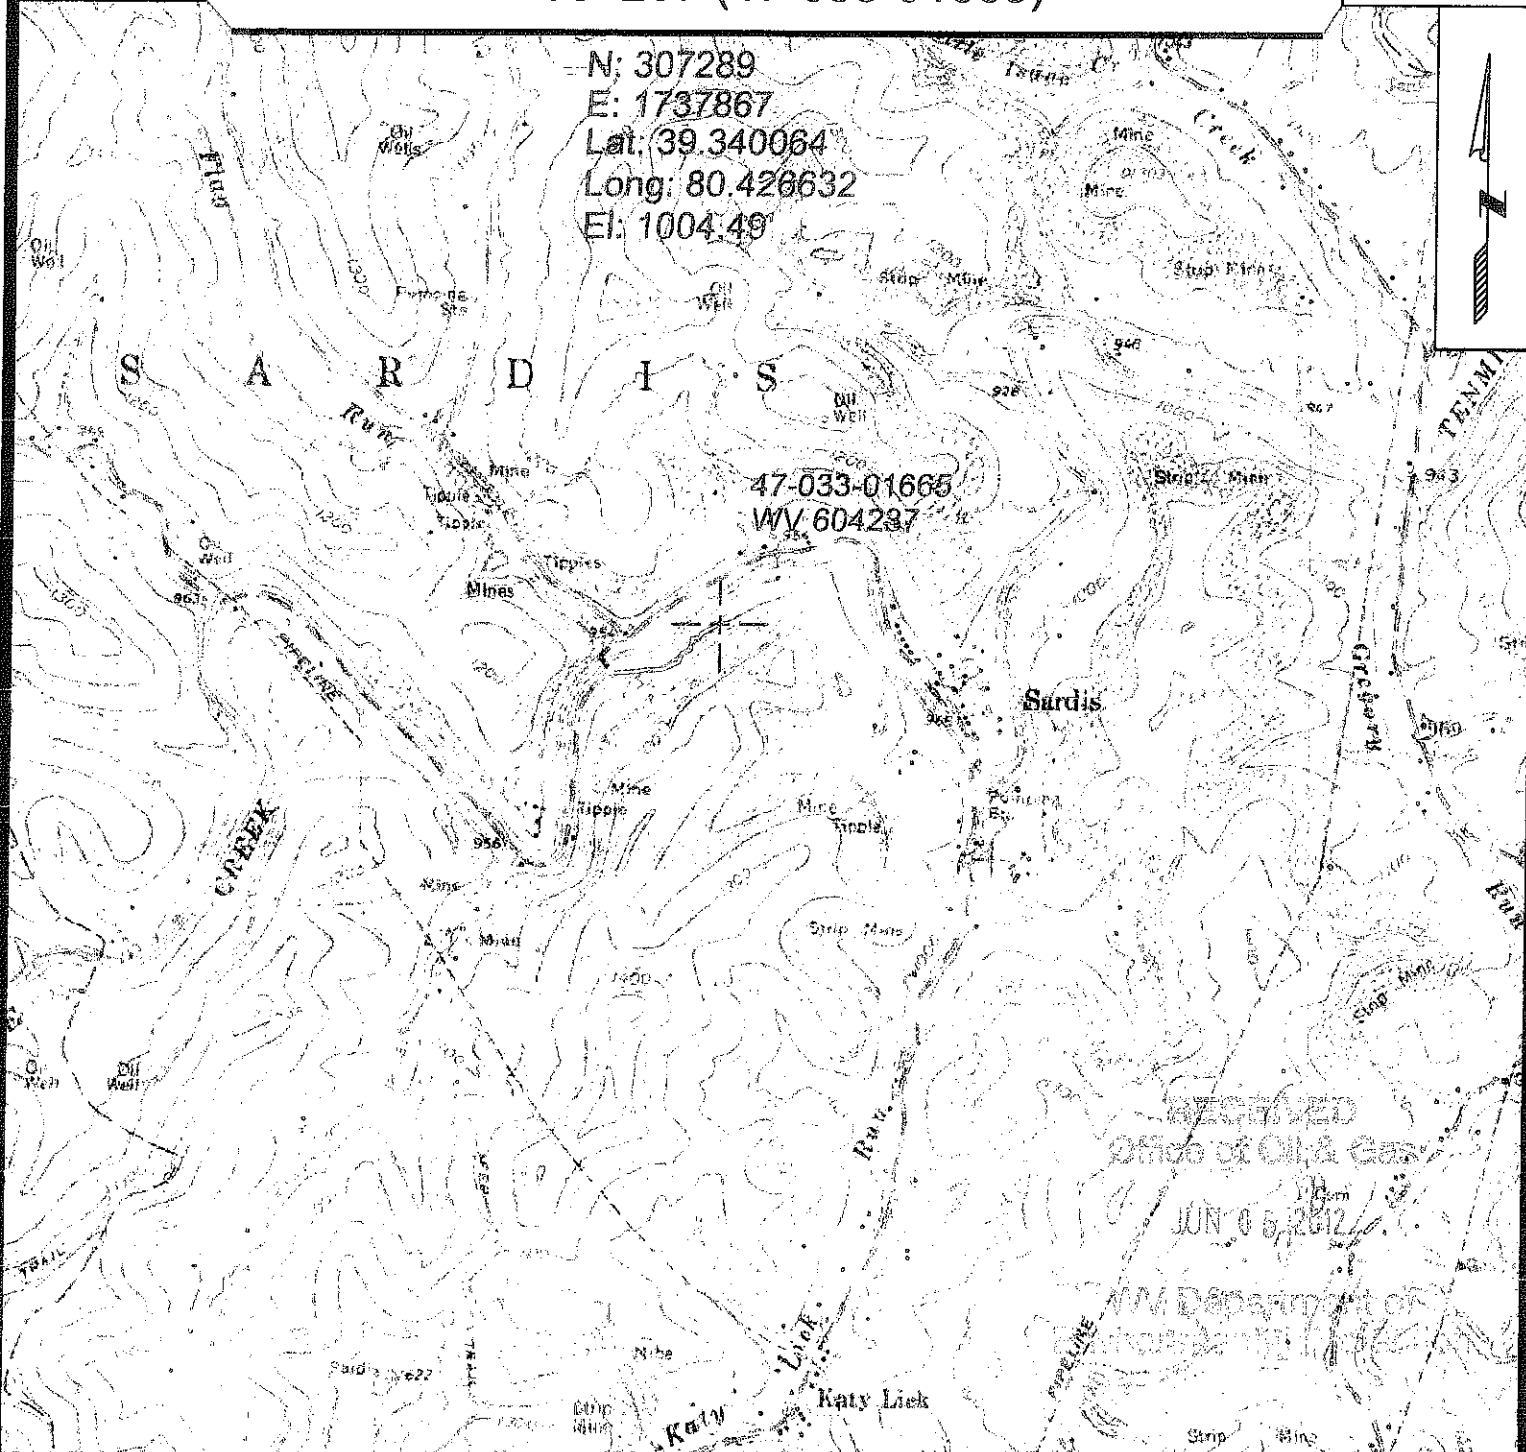

REGISTERED
Office of Oil & Gas

JUN 05 2012

WV Department of
Mines, Oil & Gas



SURVEYING AND MAPPING SERVICES PERFORMED BY:
ALLEGHENY SURVEYS, INC.
P.O. BOX 436
BIRCH RIVER, WV 26610
PH: (304) 649-8606
FAX: (304) 649-8608

PREPARED FOR:
EQT Production Co. Inc.
1710 Pennsylvania Ave.
Charleston, WV 25302