

\* Note - coordinates in DEP Mapping system online are inaccurate.

06/07/2019

WW-7  
8-30-06



West Virginia Department of Environmental Protection  
Office of Oil and Gas  
**WELL LOCATION FORM: GPS**

API: 47-33-01669 WELL NO.: 4423  
FARM NAME: H. T. Shinn  
RESPONSIBLE PARTY NAME: Peoples Gas WV, LLC  
COUNTY: Harrison DISTRICT: Clay-Outside  
QUADRANGLE: Shinnston  
SURFACE OWNER: Samuel A. Guarascio et. al.  
ROYALTY OWNER: Howard T. Shinn heirs  
UTM GPS NORTHING: 4359942  
UTM GPS EASTING: 560513 GPS ELEVATION: 1072.8

The Responsible Party named above has chosen to submit GPS coordinates in lieu of preparing a new well location plat for a plugging permit or assigned API number on the above well. The Office of Oil and Gas will not accept GPS coordinates that do not meet the following requirements:

1. Datum: NAD 1983, Zone: 17 North, Coordinate Units: meters, Altitude: height above mean sea level (MSL) – meters.
2. Accuracy to Datum – 3.05 meters
3. Data Collection Method:  
Survey grade GPS \_\_\_\_: Post Processed Differential \_\_\_\_  
Real-Time Differential \_\_\_\_  
Mapping Grade GPS \_\_\_\_: Post Processed Differential \_\_\_\_  
Real-Time Differential \_\_\_\_

4. Letter size copy of the topography map showing the well location.

I the undersigned, hereby certify this data is correct to the best of my knowledge and belief and shows all the information required by law and the regulations issued and prescribed by the Office of Oil and Gas.


Gay Ogden Land Manager-Conserv 04/03/2019  
Signature Title Date

RECEIVED  
Office of Oil and Gas

MAY 2 2019

WV Department of  
Environmental Protection

Peoples Gas Shinn Well 4423

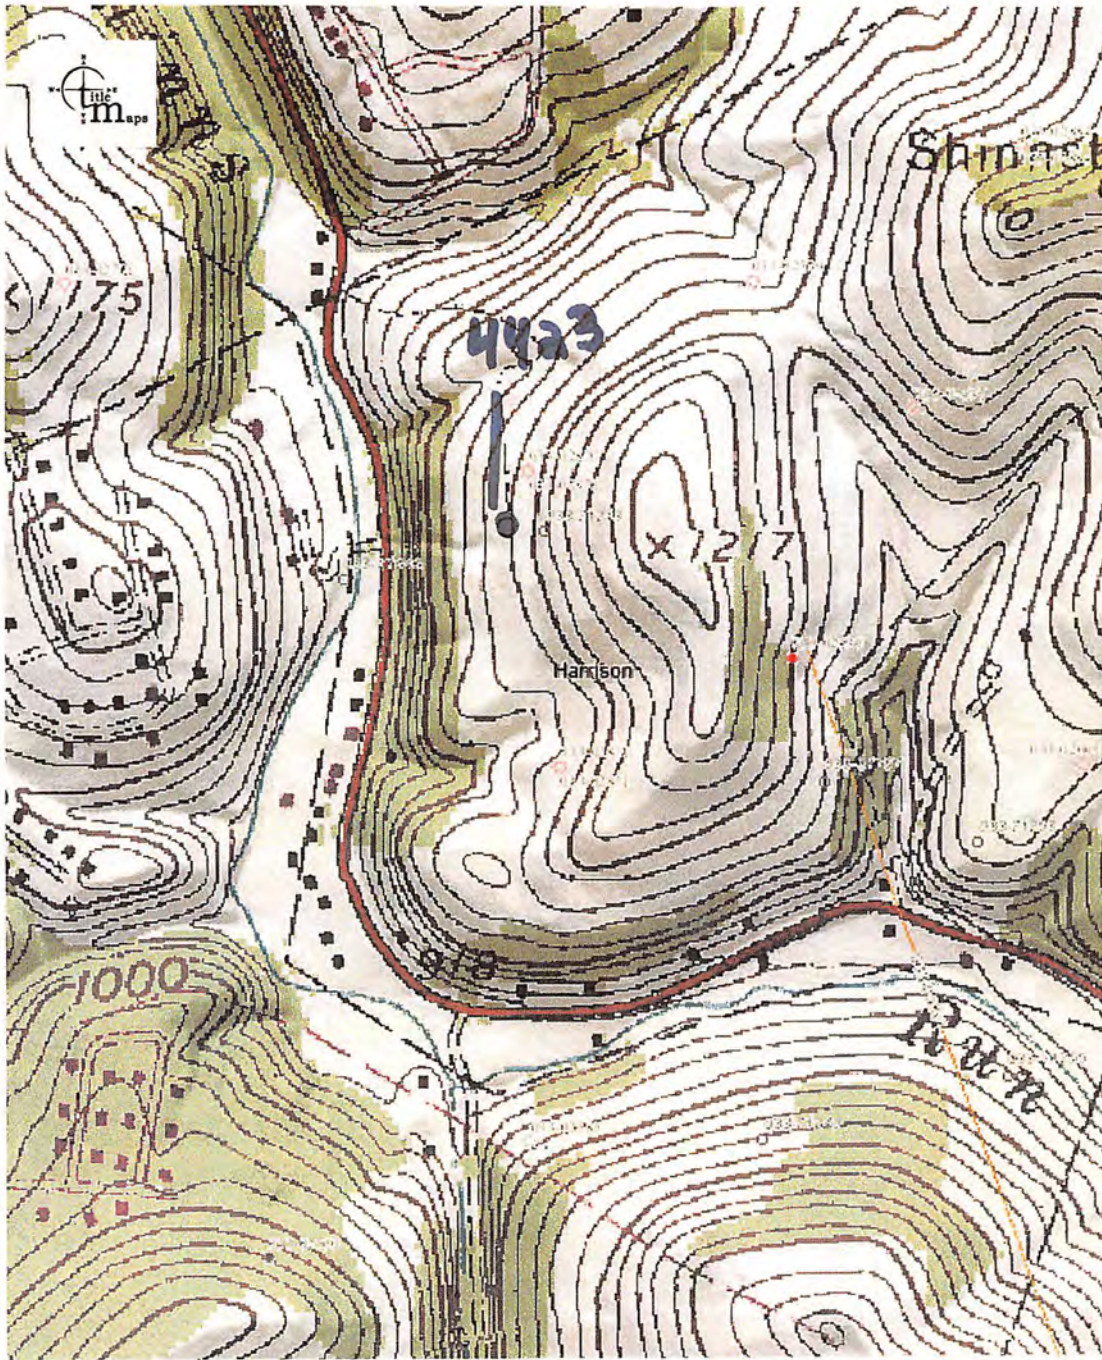

500ft

Approximate Scale 1:6,000

04/03/2019 - 02:01:04 PM

Disclaimer: The map information shown is from various sources including but not limited to tax maps and state and federal agency web sites. The map information does not represent and should not be relied upon as a land survey or legal depiction of the property or information shown. Title Maps LLC does not warrant the accuracy or correctness of the map information shown hereon.

RECEIVED  
Office of Oil and Gas  
MAY 2 2019  
WV Department of  
Environmental Protection