

WW-7
8-30-06



West Virginia Department of Environmental Protection
Office of Oil and Gas
WELL LOCATION FORM: GPS

API: 47-033-01674 WELL NO.: WV 604789 (G. L. Davisson #1)

FARM NAME: Davisson

RESPONSIBLE PARTY NAME: EQT Production Company

COUNTY: Harrison DISTRICT: Sardis-Outside

QUADRANGLE: Wallace 7.5'

SURFACE OWNER: Michael T. & Sandra S. Wilmouth

ROYALTY OWNER: J. Mark Nuzum, et al.

UTM GPS NORTHING: 4359376

UTM GPS EASTING: 543510 GPS ELEVATION: 389m (1277ft)

The Responsible Party named above has chosen to submit GPS coordinates in lieu of preparing a new well location plat for a plugging permit or assigned API number on the above well. The Office of Oil and Gas will not accept GPS coordinates that do not meet the following requirements:

1. Datum: NAD 1983, Zone: 17 North, Coordinate Units: meters, Altitude: height above mean sea level (MSL) – meters.
2. Accuracy to Datum – 3.05 meters
3. Data Collection Method:

Survey grade GPS _____ : Post Processed Differential _____


Real-Time Differential _____

Mapping Grade GPS X : Post Processed Differential X

Real-Time Differential _____

4. **Letter size copy of the topography map showing the well location.**

I the undersigned, hereby certify this data is correct to the best of my knowledge and belief and shows all the information required by law and the regulations issued and prescribed by the Office of Oil and Gas.

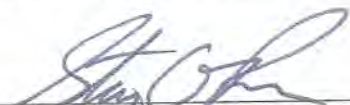
Signature

PS# 2180
Title

2/11/2020
Date

RECEIVED
Office of Oil and Gas

MAY 11 2020

West Virginia Department of
Environmental Protection


Topo Quad: Wallace 7.5' Scale: 1" = 2000'

County: Harrison Date: February 11, 2020

District: Sardis-Outside Project No: 70-36-00-08

WV 604789 47-033-01674 (G. L. Davisson #1)

Topo

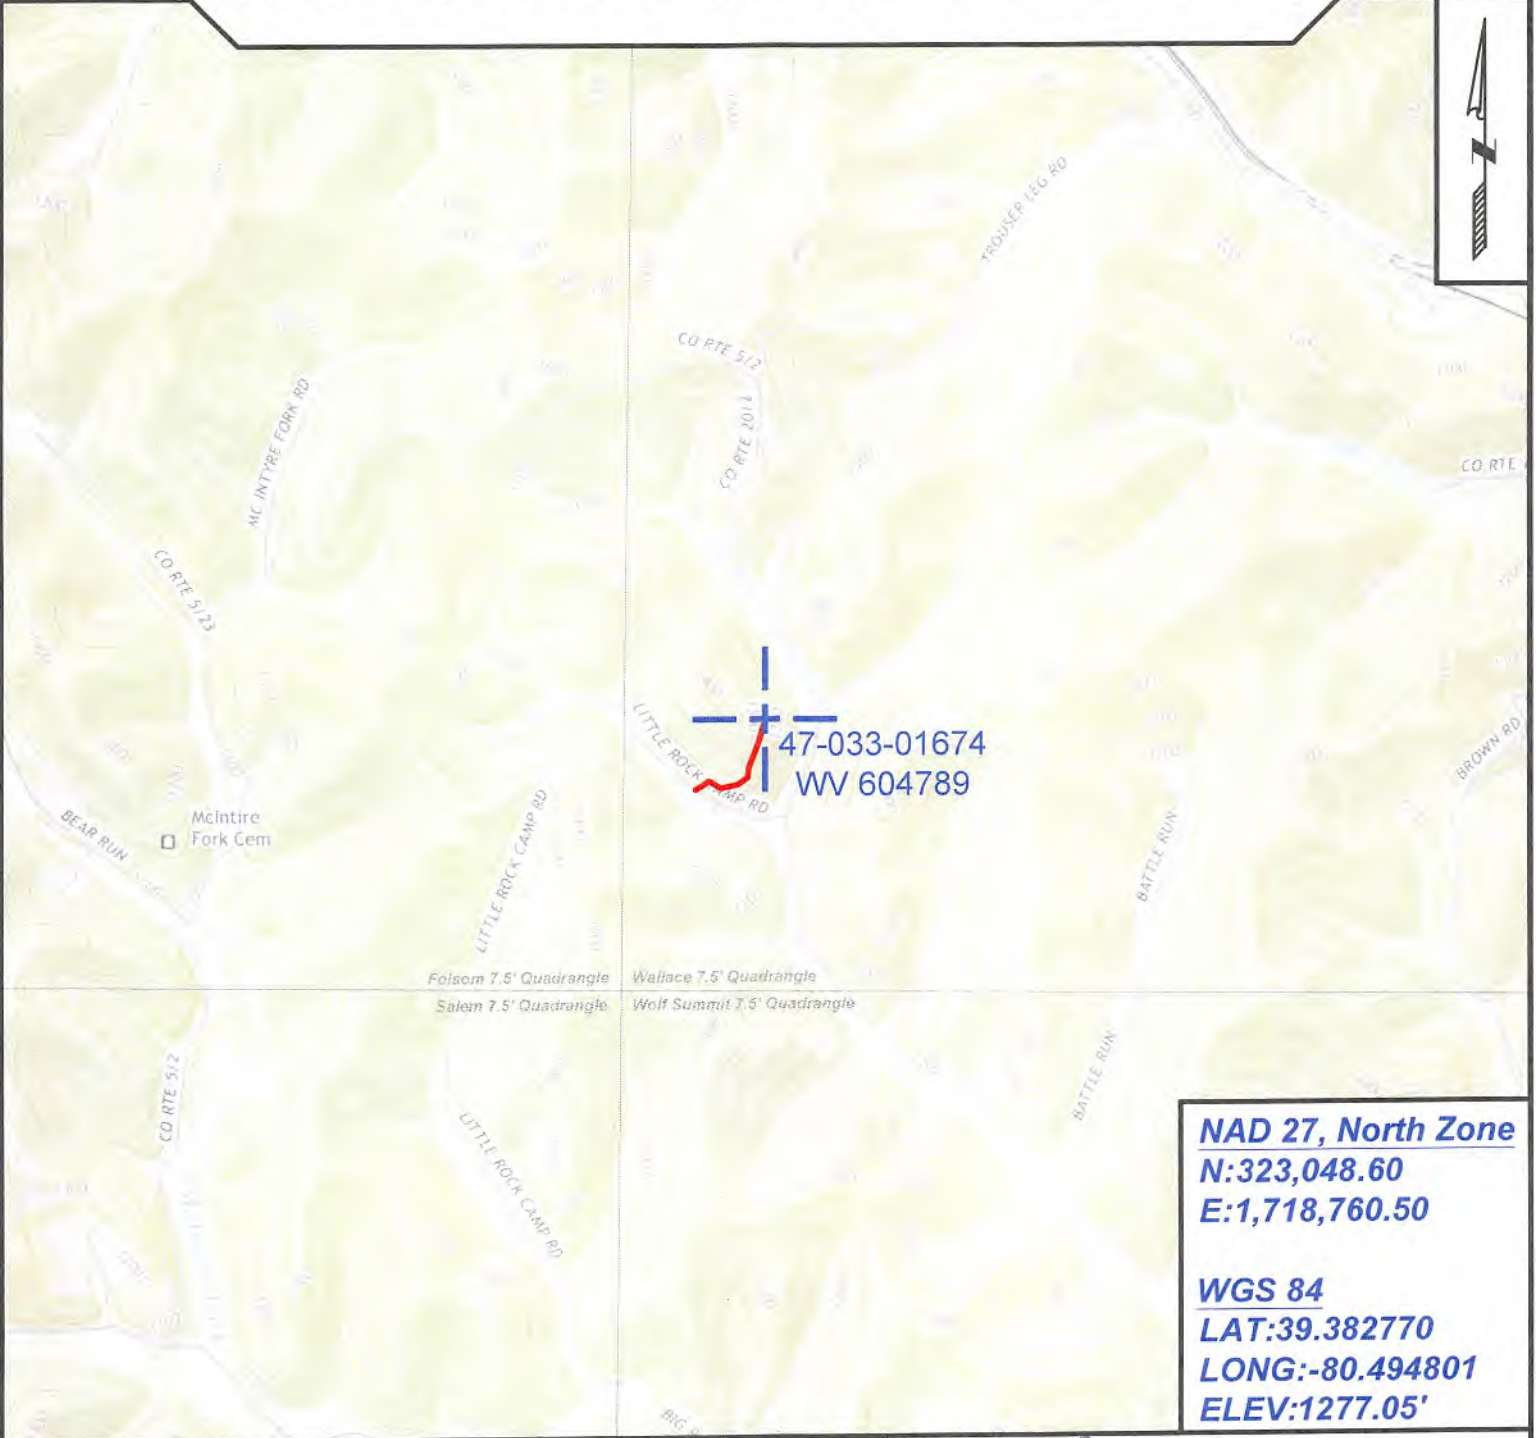

Folsom 7.5' Quadrangle Wallace 7.5' Quadrangle
Salem 7.5' Quadrangle Wolf Summit 7.5' Quadrangle

NAD 27, North Zone
N:323,048.60
E:1,718,760.50

WGS 84
LAT:39.382770
LONG:-80.494801
ELEV:1277.05'



SURVEYING AND MAPPING SERVICES PERFORMED BY:
ALLEGHENY SURVEYS, INC.
 1-800-482-8606
 237 Birch River Road
 Birch River, WV 26610
 PH: (304) 649-8606
 FAX: (304) 649-8608

PREPARED FOR:
 Office of Oil and Gas
EQT Production Company
 MAY 11 2020
 WV Department of Environmental Protection
 400 Woodcliff Drive
 Canonsburg, PA 15317



Site Pictures
G. L. Davisson #1
WV 604789 47-033-01674



WV 604789 Well ID Sign



WV 604789 Well Pad Site

RECEIVED
Office of Oil and Gas
MAY 11 2020
WV Department of
Environmental Protection

BIRCH RIVER OFFICE

237 Birch River Road
Birch River, WV 26610
phone: 304-649-8606 fax: 304-649-8608

BRIDGEPORT OFFICE

172 Thompson Drive
Bridgeport, WV 26330
phone: 304-848-5035 fax: 304-848-5037

CHARLESTON OFFICE

301 R.H. Boulevard - Suite 5
Charleston, WV 25309
phone: 304-756-2949 fax: 304-756-2948