

No. 14
 UTM Coordinates
 (NAD83)
 Meters
 N - 4,352,105
 E - 546,717


NOTES ON SURVEY
 1 - The survey shown hereon is from original drilling permit dated October, 17 1978.
 2 - Plat has been updated to show as-drilled Latitude/Longitude information and current surface owner information.
 3 - Latitude and Longitude established by DGPS Survey March, 2012.

◆ - DENOTES A POSSIBLE WATER SUPPLY SOURCE LOCATED FROM CIRCA 2003 AERIAL PHOTOGRAPHY - NOT BY SURVEY. OTHER SOURCES MAY BE PRESENT.
 + - DENOTES LOCATION OF WELL ON UNITED STATES TOPOGRAPHIC MAPS.

◆ DENOTES A WATER SUPPLY SOURCE.

FILE NO. 1046-31
 MAP NO. N S E W
 SCALE 1" = 1000'
 MINIMUM DEGREE OF ACCURACY Sub-Meter
 PROVEN SOURCE OF ELEVATION: DGPS Survey
(Sub-Meter Mapping Grade)

I THE UNDERSIGNED, HEREBY CERTIFY THAT THIS PLAT IS CORRECT TO THE BEST OF MY KNOWLEDGE AND BELIEF AND SHOWS ALL THE INFORMATION REQUIRED BY LAW AND THE REGULATIONS ISSUED AND PRESCRIBED BY THE DEPARTMENT OF MINES.
 (SIGNED) [Signature]
 TIMOTHY P. ROUSH PS 793

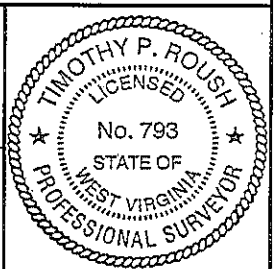

WEST VIRGINIA
 Division of Environmental Protection
 Office of Oil and Gas
 601 57th Street
 Charleston, West Virginia 25301



DATE April 9, 2012
 FARM Beeson H. Brown No.14
 API WELL NO. 47-033-1949 F

WELL TYPE: OIL GAS LIQUID INJECTION WASTE DISPOSAL
 (IF "GAS") PRODUCTION STORAGE DEEP SHALLOW
 LOCATION: ELEVATION 1134' WATERSHED New Creek
 DISTRICT Tenmile COUNTY Harrison
 QUADRANGLE Wolf Summit 7.5'
 SURFACE OWNER Kenneth D. Elsey ACREAGE 96.94 ac.
 OIL & GAS ROYALTY OWNER HG Energy, LLC. LEASE ACREAGE 213 ac.
 LEASE NO. 32716-50
 PROPOSED WORK: DRILL CONVERT DRILL DEEPER REDRILL FRACTURE OR STIMULATE PLUG OFF OLD FORMATION PERFORATE NEW FORMATION OTHER PHYSICAL CHANGE IN WELL (SPECIFY) _____


PLUG AND ABANDON CLEAN OUT AND REPLUG
 TARGET FORMATION Fifth Sand ESTIMATED DEPTH 2,700'
 WELL OPERATOR HG Energy LLC. DESIGNATED AGENT Mike Kirsch
 ADDRESS P. O. Box 5519 ADDRESS P. O. Box 5519
Vienna, W.Va. 26105 Vienna, W.Va. 26105

F UTM IV-D

33-01949

33-01949

SUBJECT WELL
Beeson H. Brown No. 14

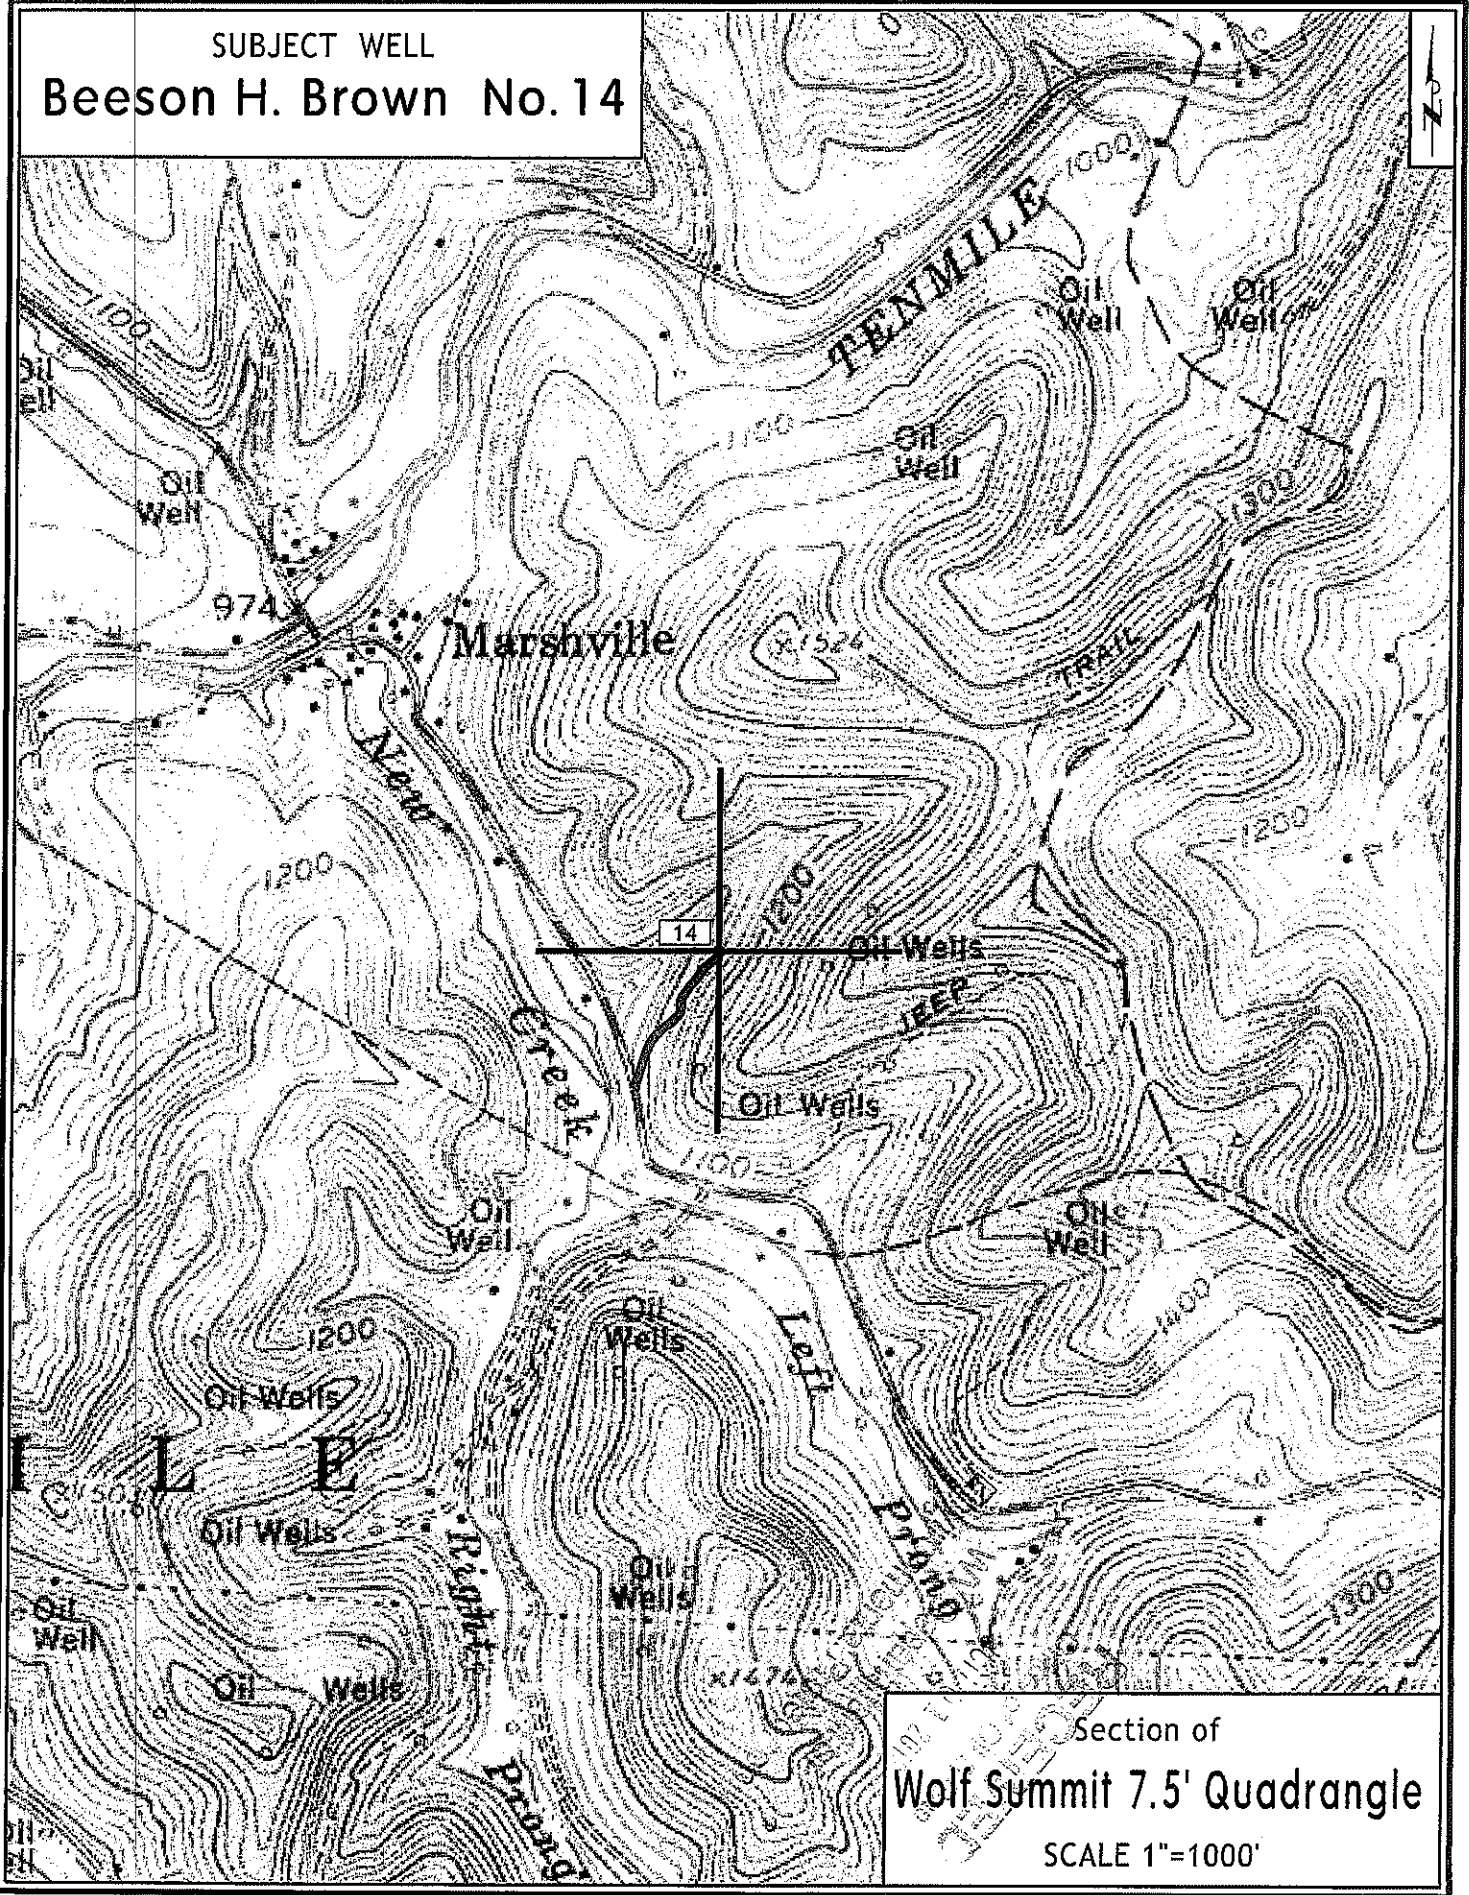

Section of
Wolf Summit 7.5' Quadrangle
SCALE 1"=1000'