

3302013P

RECEIVED
Office of Oil and Gas

JUL 20 2018

WV Department of
Environmental Protection

WW-7
8-30-06



West Virginia Department of Environmental Protection
Office of Oil and Gas

WELL LOCATION FORM: GPS

API: 47-033-02013 WELL NO.: Jackson S-8

FARM NAME: Rodgers, Edward

RESPONSIBLE PARTY NAME: XTO Energy, Inc.

COUNTY: Harrison DISTRICT: Sardis

QUADRANGLE: Wallace

SURFACE OWNER: Elizabeth Jackson Groninger, Hunter Jackson, Jr., & Edward Rodgers

ROYALTY OWNER: See attached list

UTM GPS NORTHING: 4361228.2

UTM GPS EASTING: 548671.5 GPS ELEVATION: 469 meters (1538')

The Responsible Party named above has chosen to submit GPS coordinates in lieu of preparing a new well location plat for a plugging permit or assigned API number on the above well. The Office of Oil and Gas will not accept GPS coordinates that do not meet the following requirements:

1. Datum: NAD 1983, Zone: 17 North, Coordinate Units: meters, Altitude: height above mean sea level (MSL) – meters.

2. Accuracy to Datum – 3.05 meters

3. Data Collection Method:

Survey grade GPS : Post Processed Differential

Real-Time Differential

Mapping Grade GPS : Post Processed Differential

Real-Time Differential

4. Letter size copy of the topography map showing the well location.

I the undersigned, hereby certify this data is correct to the best of my knowledge and belief and shows all the information required by law and the regulations issued and prescribed by the Office of Oil and Gas.

[Signature]
Signature


Project Manager
Title

July 6, 2015
Date

Received
Office of Oil and Gas 08/10/2018

JUL 20 2015


SDW
7/15/2015

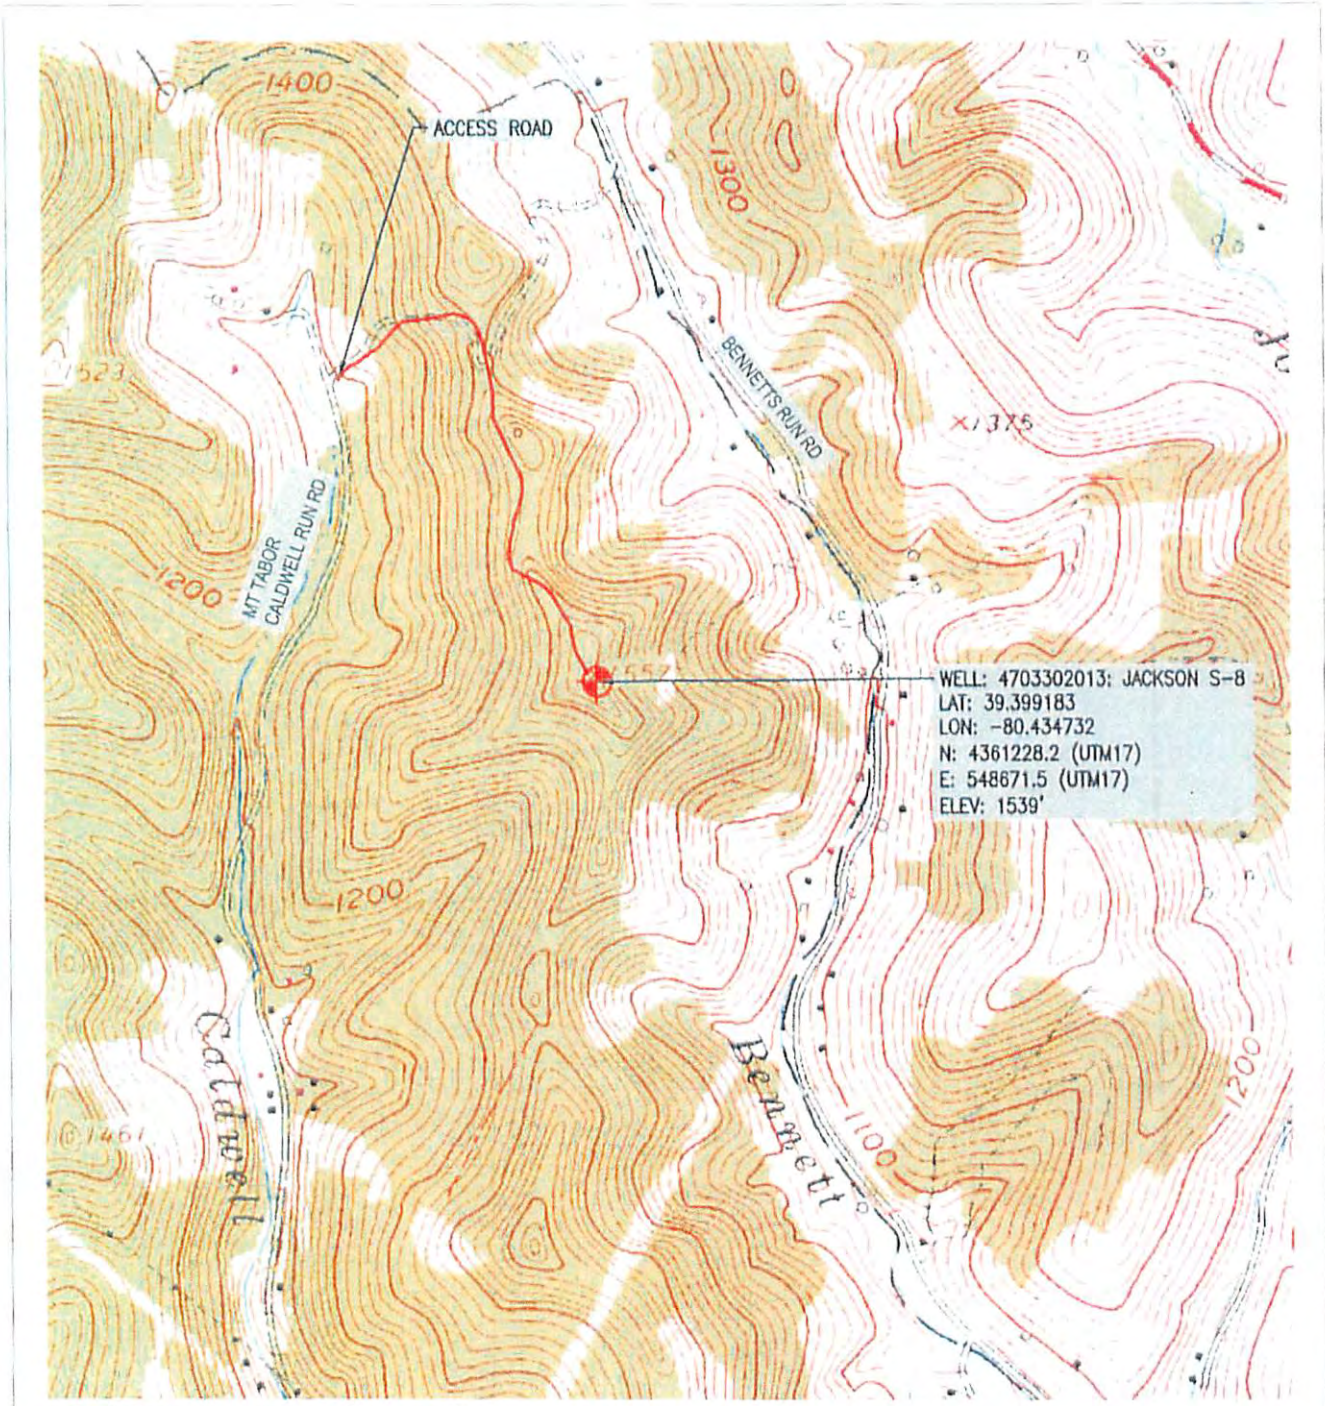

MAP REFERENCE: U.S.G.S. WALLACE, WV



810 HOUSTON STREET
FORT WORTH, TX 76102

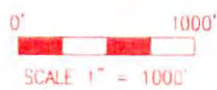

TRI-COUNTY ENGINEERING, LLC

An ENERCON Company

319 Paintersville Road
Harrisburg, PA 17033
www.tri-countyeng.com

Voice: (724) 635-0210

Fax: (724) 635-0676



Excellence-Every project. Every day.

LOCATION MAP

JACKSON S-8 WELL PLUG

DRAWN BY:
MRC
DATE:
7/6/2015
SCALE:
AS NOTED

SARDIS DISTRICT,
HARRISON COUNTY, WEST VIRGINIA
SHEET:
1 OF 1
FILE NO:
OG61-08

Received
Office of Oil & Gas
08/10/2018

RECEIVED
Office of Oil and Gas

JUL 20 2015

JUL 20 2018

WV Department of
Environmental Protection