

4703302134P

WW-7  
8-30-06



West Virginia Department of Environmental Protection  
Office of Oil and Gas  
**WELL LOCATION FORM: GPS**

API: 47-033-02134 WELL NO.: 7571  
FARM NAME: Hugh Jarvis  
RESPONSIBLE PARTY NAME: Eastern Gas Transmission and Storage, Inc  
COUNTY: Harrison DISTRICT: Simpson  
QUADRANGLE: Rosemont  
SURFACE OWNER: Alan Enterprizes  
ROYALTY OWNER: Hugh Jarvis, etal  
UTM GPS NORTHING: 4352712 (1270')  
UTM GPS EASTING: 566417 GPS ELEVATION: 387<sup>m</sup>

The Responsible Party named above has chosen to submit GPS coordinates in lieu of preparing a new well location plat for a plugging permit or assigned API number on the above well. The Office of Oil and Gas will not accept GPS coordinates that do not meet the following requirements:

1. Datum: NAD 1983, Zone: 17 North, Coordinate Units: meters, Altitude: height above mean sea level (MSL) – meters.
2. Accuracy to Datum – 3.05 meters
3. Data Collection Method:

Survey grade GPS \_\_\_\_: Post Processed Differential \_\_\_\_

Real-Time Differential

Mapping Grade GPS \_\_\_\_: Post Processed Differential \_\_\_\_

Real-Time Differential \_\_\_\_

4. Letter size copy of the topography map showing the well location.

I the undersigned, hereby certify this data is correct to the best of my knowledge and belief and shows all the information required by law and the regulations issued and prescribed by the Office of Oil and Gas.


Richard E. Adams  
Signature

Project Manager  
Title

06/16/2021  
Date

07/16/2021

RECEIVED  
Office of Oil and Gas  
JUN 23 2021  
WV Department of  
Environmental Protection

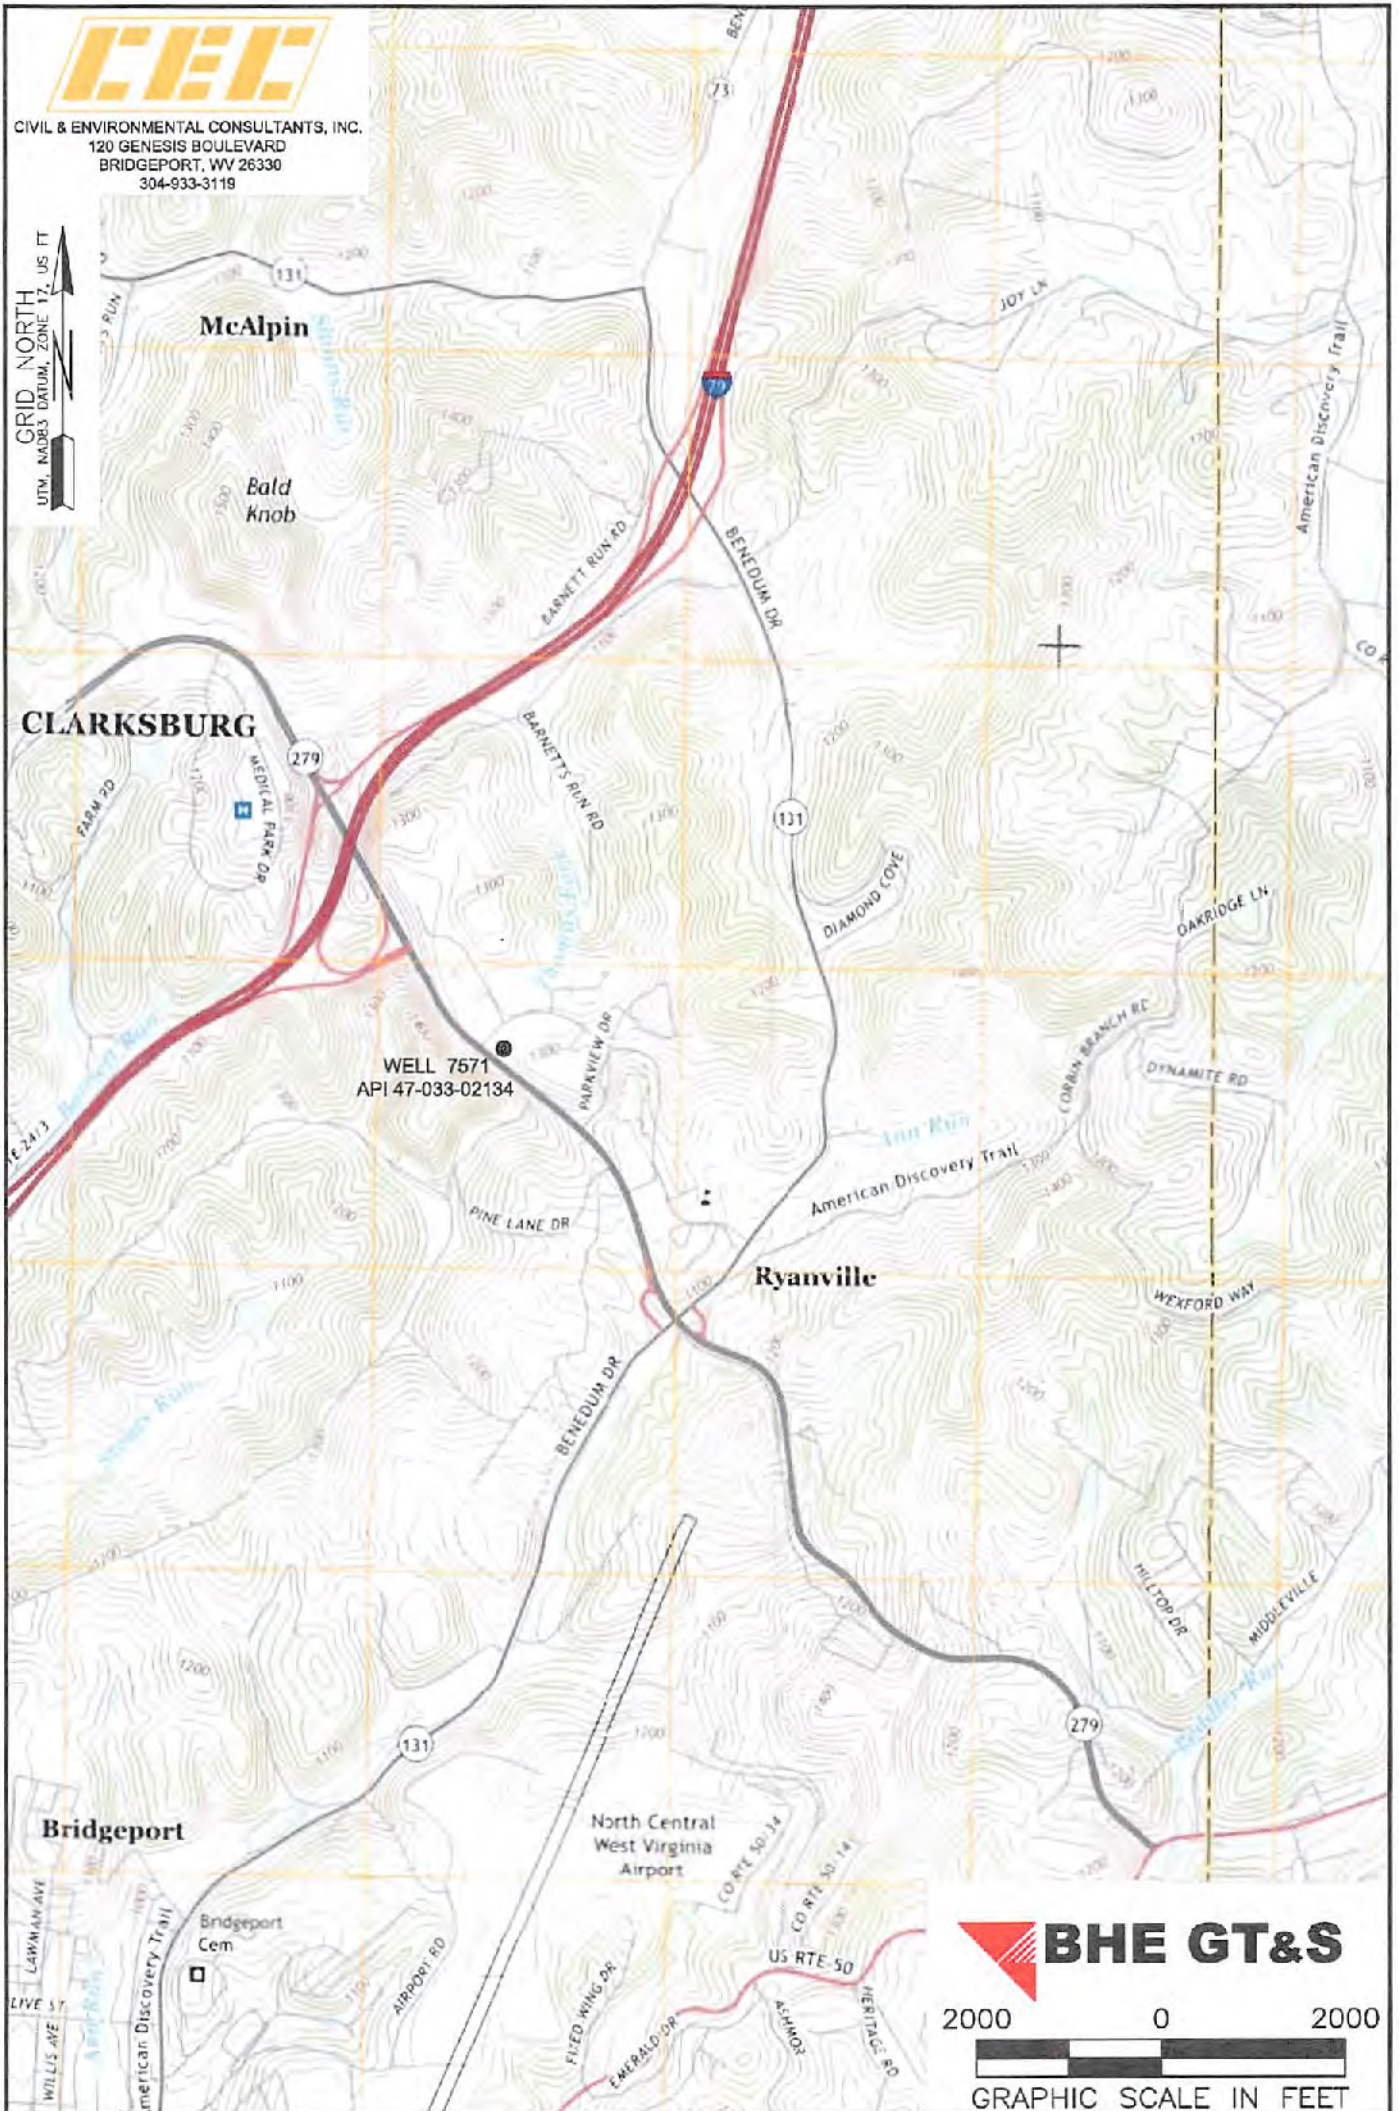

**C&E**  
 CIVIL & ENVIRONMENTAL CONSULTANTS, INC.  
 120 GENESIS BOULEVARD  
 BRIDGEPORT, WV 26330  
 304-933-3119

GRID NORTH  
 UTM, NAD83 DATUM, ZONE 17, US FT

**NOTES ON SURVEY**  
 1. SURFACE AND ROYALTY OWNER INFORMATION AND THEIR BOUNDARIES SHOWN HEREON WERE PLOTTED FROM DEEDS AND/OR TAX PARCEL MAPS PROVIDED BY CLIENT AND/OR FIELD LOCATIONS.  
 2. THIS PLAT DOES NOT REPRESENT A BOUNDARY SURVEY OF THE PARCELS SHOWN HEREON.  
 4. ALL INSETS ARE GRID NORTH UNLESS OTHERWISE DEPICTED.

**LEGEND:**  
 ○ PROPOSED SURFACE HOLE / BOTTOM HOLE  
 \* EXISTING / PRODUCING WELLHEAD  
 LPL \* LANDING POINT LOCATION  
 [Blue Shaded Area] FLOOD PLAIN  
 [Green Line] ACCESS ROAD  
 [Dashed Green Line] PUBLIC ROAD  
 [Black Line] ACCESS ROAD TO PREV. SITE  
 [Dashed Black Line] LEASE BOUNDARY  
 [Red Line] PROPOSED PATH



WELL OPERATOR: EASTERN GAS TRANSMISSION AND STORAGE, INC.	WELL (FARM) NAME: HUGH JARVIS	WELL # 7571	SERIAL # XXXX
ADDRESS: 925 WHITE OAKS BLVD, BRIDGEPORT, WV 26330	COUNTY - CODE HARRISON - 033	DISTRICT; SIMPSON DISTRICT	
SURFACE OWNER: ALAN ENTERPRISES	USGS 7 1/2 QUADRANGLE MAP NAME ROSEMONT, WV		

07/16/2021