

WW-7
8-30-06



West Virginia Department of Environmental Protection
Office of Oil and Gas

WELL LOCATION FORM: GPS

API: 47-033-02332 WELL NO.: 1
 FARM NAME: E. Robinson
 RESPONSIBLE PARTY NAME: Alliance Petroleum Corporation
 COUNTY: Harrison DISTRICT: Eagle
 QUADRANGLE: Shinnston 7.5'
 SURFACE OWNER: Robert E. Currey & Betty S. Currey
 ROYALTY OWNER: Consolidation Coal Company, Alamco Inc Successor, Appalachian Pet. Corp.
 UTM GPS NORTHING: 4365046
 UTM GPS EASTING: 555984 GPS ELEVATION: 1233'

The Responsible Party named above has chosen to submit GPS coordinates in lieu of preparing a new well location plat for a plugging permit or assigned API number on the above well. The Office of Oil and Gas will not accept GPS coordinates that do not meet the following requirements:

1. Datum: NAD 1983, Zone: 17 North, Coordinate Units: meters, Altitude: height above mean sea level (MSL) – meters.
2. Accuracy to Datum – 3.05 meters
3. Data Collection Method:

Survey grade GPS ____ : Post Processed Differential ____
 Real-Time Differential ____

Mapping Grade GPS X : Post Processed Differential ____
 Real-Time Differential X

4. **Letter size copy of the topography map showing the well location.**

I the undersigned, hereby certify this data is correct to the best of my knowledge and belief and shows all the information required by law and the regulations issued and prescribed by the Office of Oil and Gas.

David Dean
Signature


VP Production
Title

11/22/2017
Date

RECEIVED
Office of Oil and Gas

NOV 22 2017


WV Department of
Environmental Protection

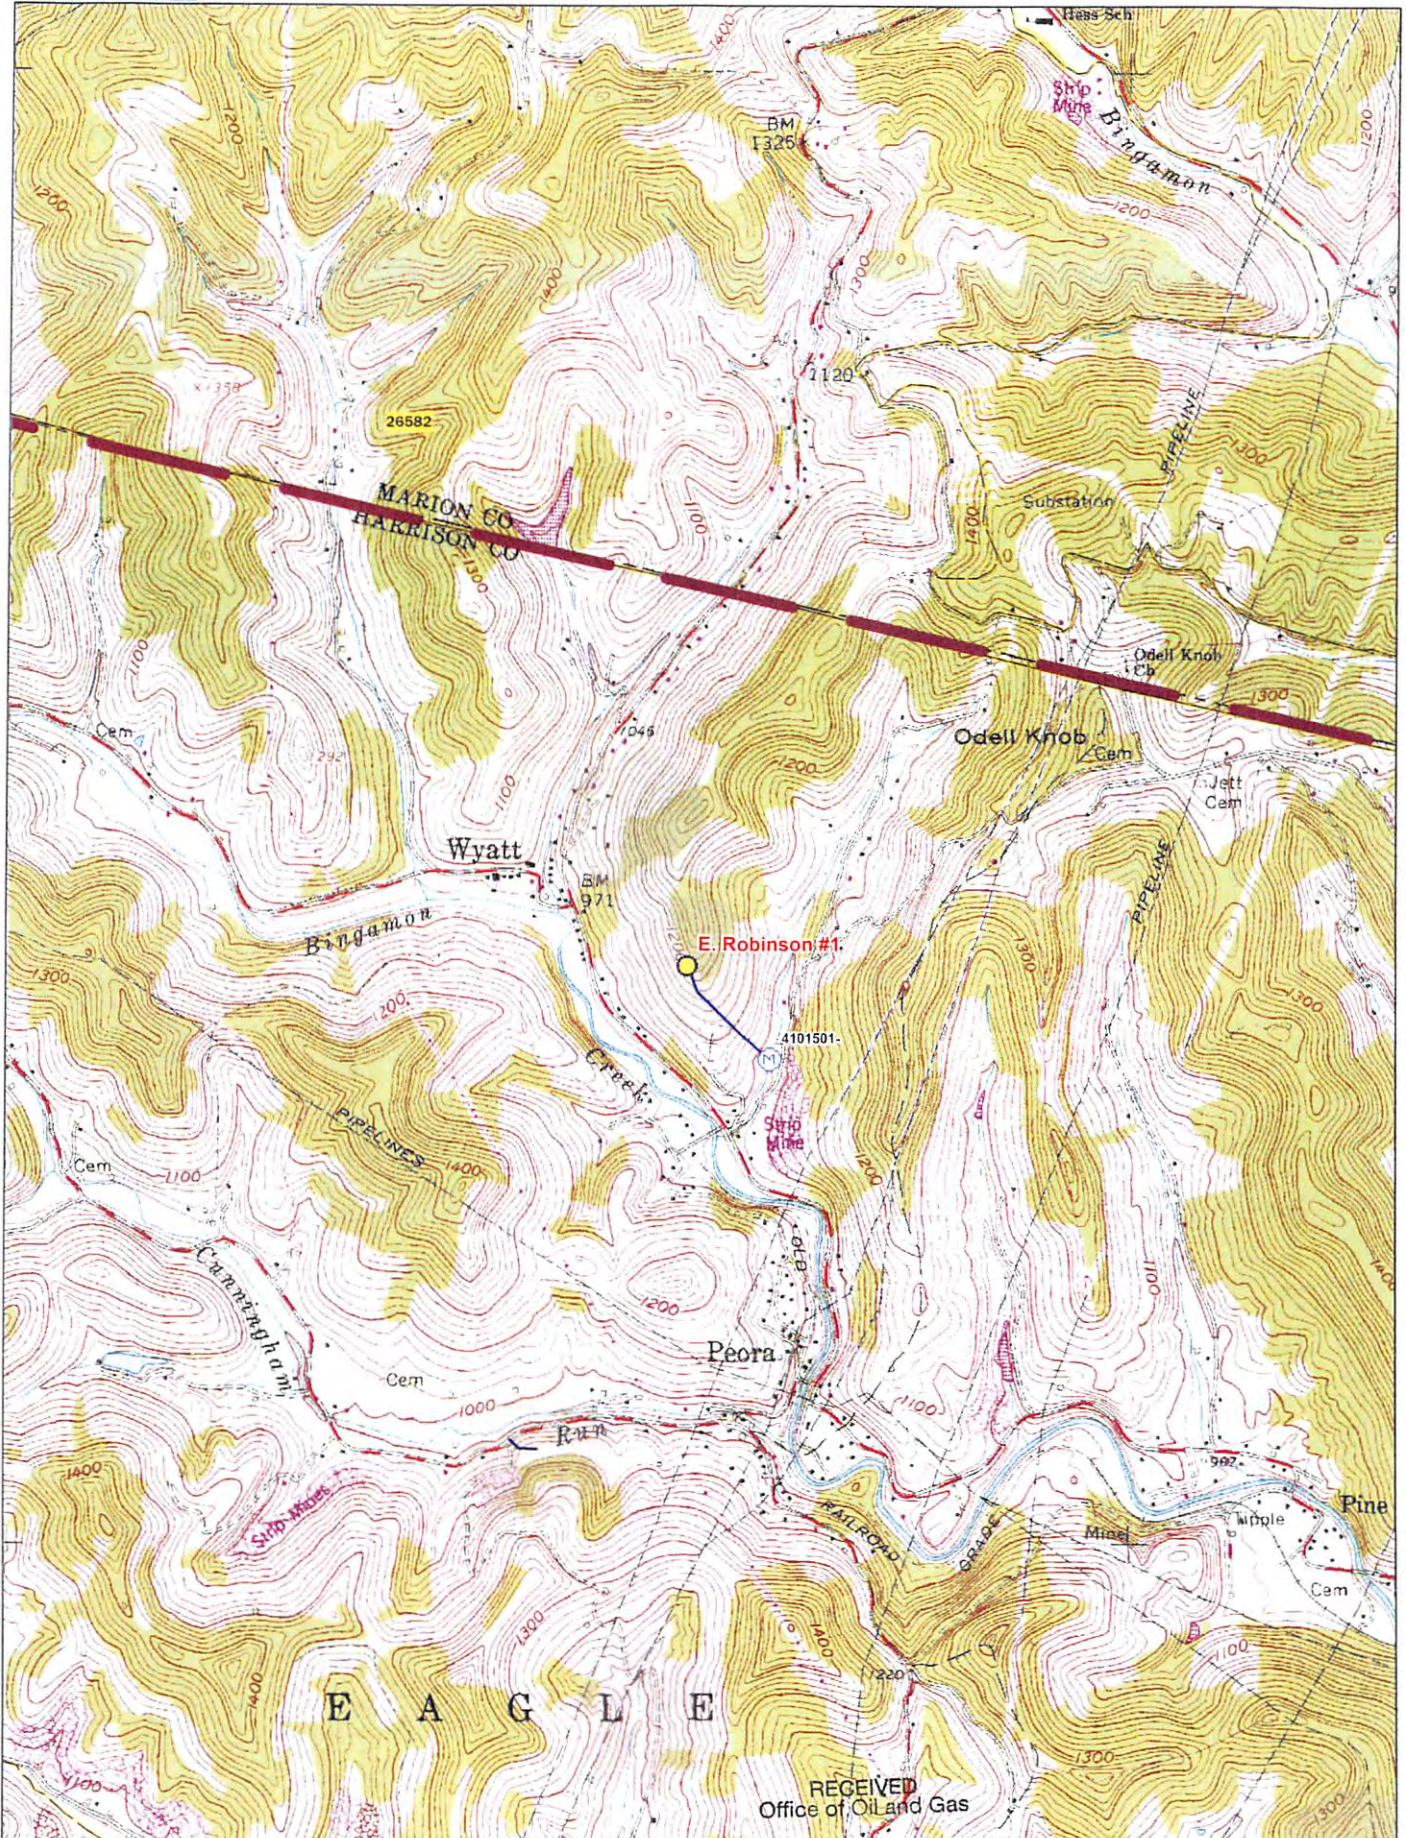

RECEIVED
Office of Oil and Gas

OCT 03 2017

Scale 1 : 24,000

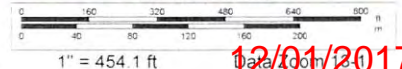

Data use subject to license.

© DeLorme. XMap® 8

www.delorme.com



WV Department of
Environmental Protection

12/01/2017