

WW-7  
5-02


**West Virginia Department of Environmental Protection  
Office of Oil and Gas  
WELL LOCATION FORM: GPS**

API: 47-033-02894 WELL NO.: 10896  
 FARM NAME: ELLEN HARBERT  
 RESPONSIBLE PARTY NAME: CNX GAS COMPANY LLC  
 COUNTY: HARRISON DISTRICT: EAGLE  
 QUADRANGLE: WALLACE  
 SURFACE OWNER: MICHAEL MARTIN  
 ROYALTY OWNER: HAYWARD HARBERT  
 UTM GPS NORTHING: 4,362,593.68 METERS  
 UTM GPS EASTING: 549,886.00 METERS GPS ELEVATION: 357.53 METERS (1173')

The Responsible Party named above has chosen to submit GPS coordinates in lieu of preparing a new well location plat for a plugging permit on the above well. The Office of Oil and Gas will not accept GPS coordinates that do not meet the following requirements:

1. Datum: NAD 1983, Zone: 17 Coordinate Units: meters Altitude: Height above mean sea level (MSL) - meters
2. Accuracy to Datum - 3.05 meters
3. Data Collection Method: Survey Grade GPS \_\_\_\_ : Post Processed Differential \_\_\_\_ Real-Time Differential \_\_\_\_  
 Mapping Grade GPS X : Post Processed Differential \_\_\_\_ Real-Time Differential X

I the undersigned hereby state this data is correct to the best of my knowledge and belief and shows all the information required by law and the regulation issued and prescribed by the Office of Oil and Gas.

Signature   
 Stephen D. Losh, PS #674


Title WV Professional Surveyor #674

Date 11/18/14



CNX USE: NAD 27 WV NORTH SPC: 10896 = 333,257.93' 1,739,860.32' ELEV. = 1173.00'

06/17/2016

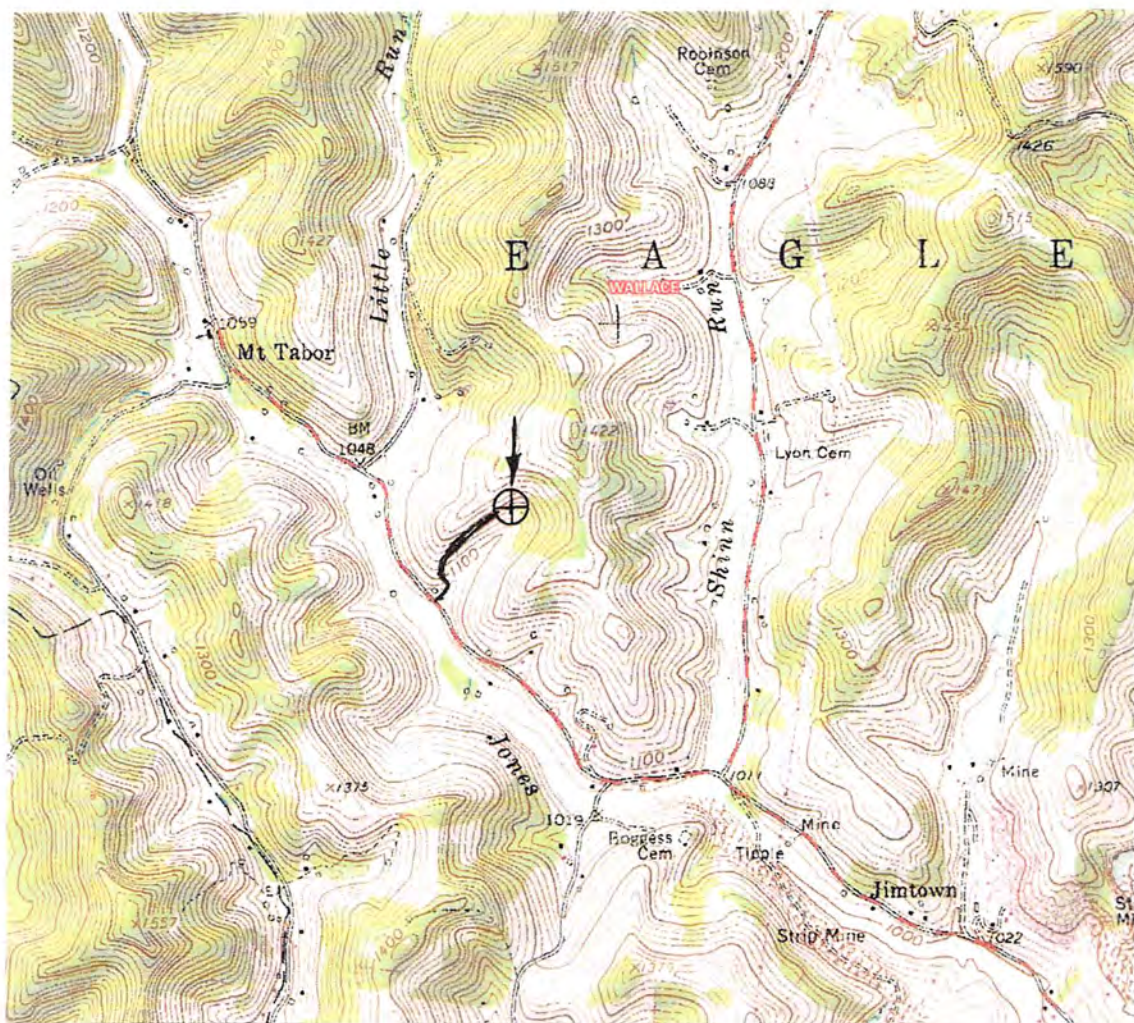

SDeW  
4/11/16

DRAWINGS TO ACCOMPANY FORM WW-9	
CNX GAS COMPANY LLC	
P. O. BOX 1248	
JANE LEW, WV 26378	
WATERSHED:	JONES CREEK
DISTRICT:	EAGLE COUNTY HARRISON
QUADRANGLE:	WALLACE WELL NO.: 10896
DATE:	11/18/14

LAND SURVEYING SERVICES  
21 CEDAR LANE  
BRIDGEPORT, WV 26330  
PHONE: 304-842-2018 OR 5762

RECEIVED  
Office of Oil and Gas  
and Gas  
MAY 09 2016  
PAGE 2 of 2  
WV Department of Environmental Protection