



West Virginia Department of Environmental Protection  
Office of Oil and Gas  
WELL LOCATION FORM: GPS

API: 47-033-03087 P WELL NO.: CONSOLIDATION COAL #A-1  
FARM NAME: CONSOLIDATION COAL CO.  
RESPONSIBLE PARTY NAME: ENERVEST OPERATING, LLC  
COUNTY: HARRISON DISTRICT: COAL  
QUADRANGLE: CLARKSBURG 7.5 MIN.  
SURFACE OWNER: ROSETTA M. PROKOP, ET. AL.  
ROYALTY OWNER: CNX GAS COMPANY, LLC  
UTM GPS NORTHING: 4,349,698.38 METERS  
UTM GPS EASTING: 559,889.55 METERS GPS ELEVATION: 417.11 METERS

The Responsible Party named above has chosen to submit GPS coordinates in lieu of preparing a new well location plat for a plugging permit on the above well. The Office of Oil and Gas will not accept GPS coordinates that do not meet the following requirements:

1. Datum: NAD 1983, Zone: 17 Coordinate Units: meters Altitude: Height above mean sea level (MSL) - meters
2. Accuracy to Datum - 3.05 meters
3. Data Collection Method: Survey Grade GPS  : Post Processed Differential  Real-Time Differential   
Mapping Grade GPS  : Post Processed Differential  Real-Time Differential


I the undersigned hereby state this data is correct to the best of my knowledge and belief and shows all the information required by law and the regulation issued and prescribed by the Office of Oil and Gas.

Signature   
Stephen D. Losh, PS #674

Title WV Professional Surveyor #674

Date 10/13/11

33-03087P

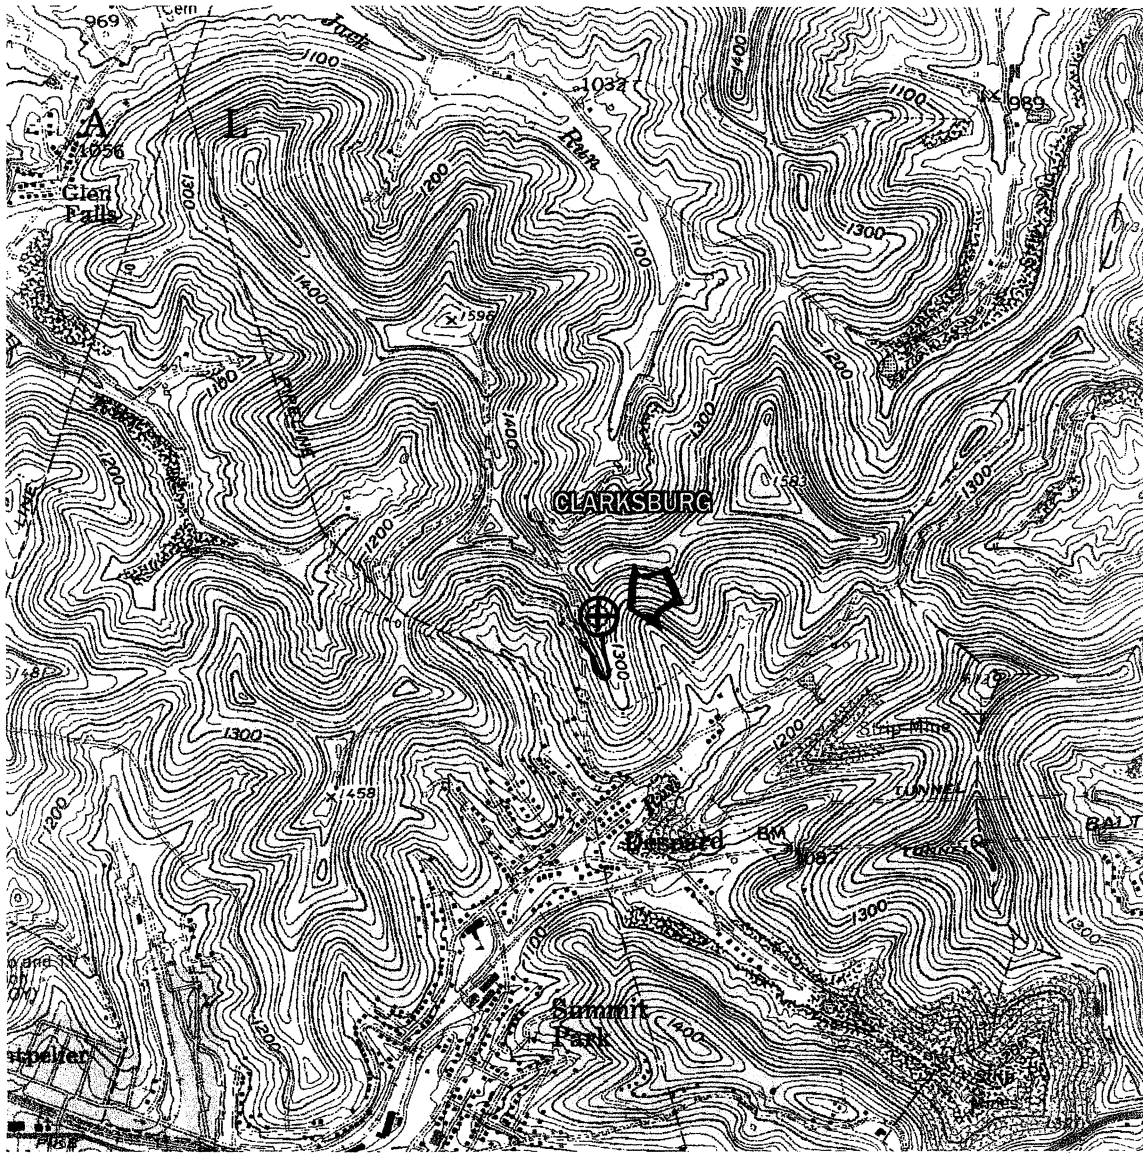

DRAWINGS TO ACCOMPANY FORM WW-9

ENERVEST OPERATING, LLC

300 CAPITOL ST., SUITE 200

CHARLESTON, WV 25301

WATERSHED: MURPHY RUN

DISTRICT: COAL COUNTY: HARRISON

QUADRANGLE: CLARKSBURG WELL NO.: CONSOL  
COAL A-1

DATE: 10/13/11 PAGE 3 of 3

LAND SURVEYING SERVICES  
21 CEDAR LANE  
BRIDGEPORT, WV 26330  
PHONE: 304-842-2018 OR 5762