

47-033-03907 P

WW-7  
8-30-06



West Virginia Department of Environmental Protection  
Office of Oil and Gas  
**WELL LOCATION FORM: GPS**

API: 47-033-03907 WELL NO.: E-937 L.C. Maxwell #1

FARM NAME: Mary & Russell Richards, et al

RESPONSIBLE PARTY NAME: Jerry L. Jackson

COUNTY: Harrison DISTRICT: Sardis

QUADRANGLE: Wolf Summit

SURFACE OWNER: Russell E. & Mary L. Richards, et al

ROYALTY OWNER: L.C. Maxwell, et al

UTM GPS NORTHING: 4352485.5

UTM GPS EASTING: 549333.9 GPS ELEVATION: 1169'

The Responsible Party named above has chosen to submit GPS coordinates in lieu of preparing a new well location plat for a plugging permit or assigned API number on the above well. The Office of Oil and Gas will not accept GPS coordinates that do not meet the following requirements:

1. Datum: NAD 1983, Zone: 17 North, Coordinate Units: meters, Altitude: height above mean sea level (MSL) – meters.
2. Accuracy to Datum – 3.05 meters
3. Data Collection Method:

Survey grade GPS \_\_\_\_: Post Processed Differential \_\_\_\_

Real-Time Differential \_\_\_\_

Mapping Grade GPS \_\_\_\_: Post Processed Differential \_\_\_\_

Real-Time Differential \_\_\_\_

4. **Letter size copy of the topography map showing the well location.**

I the undersigned, hereby certify this data is correct to the best of my knowledge and belief and shows all the information required by law and the regulations issued and prescribed by the Office of Oil and Gas.

  
Signature


Land Manager  
Title


8/01/2019  
Date

RECEIVED  
Office of Oil and Gas

AUG 15 2019

WV Department of  
Environmental Protection

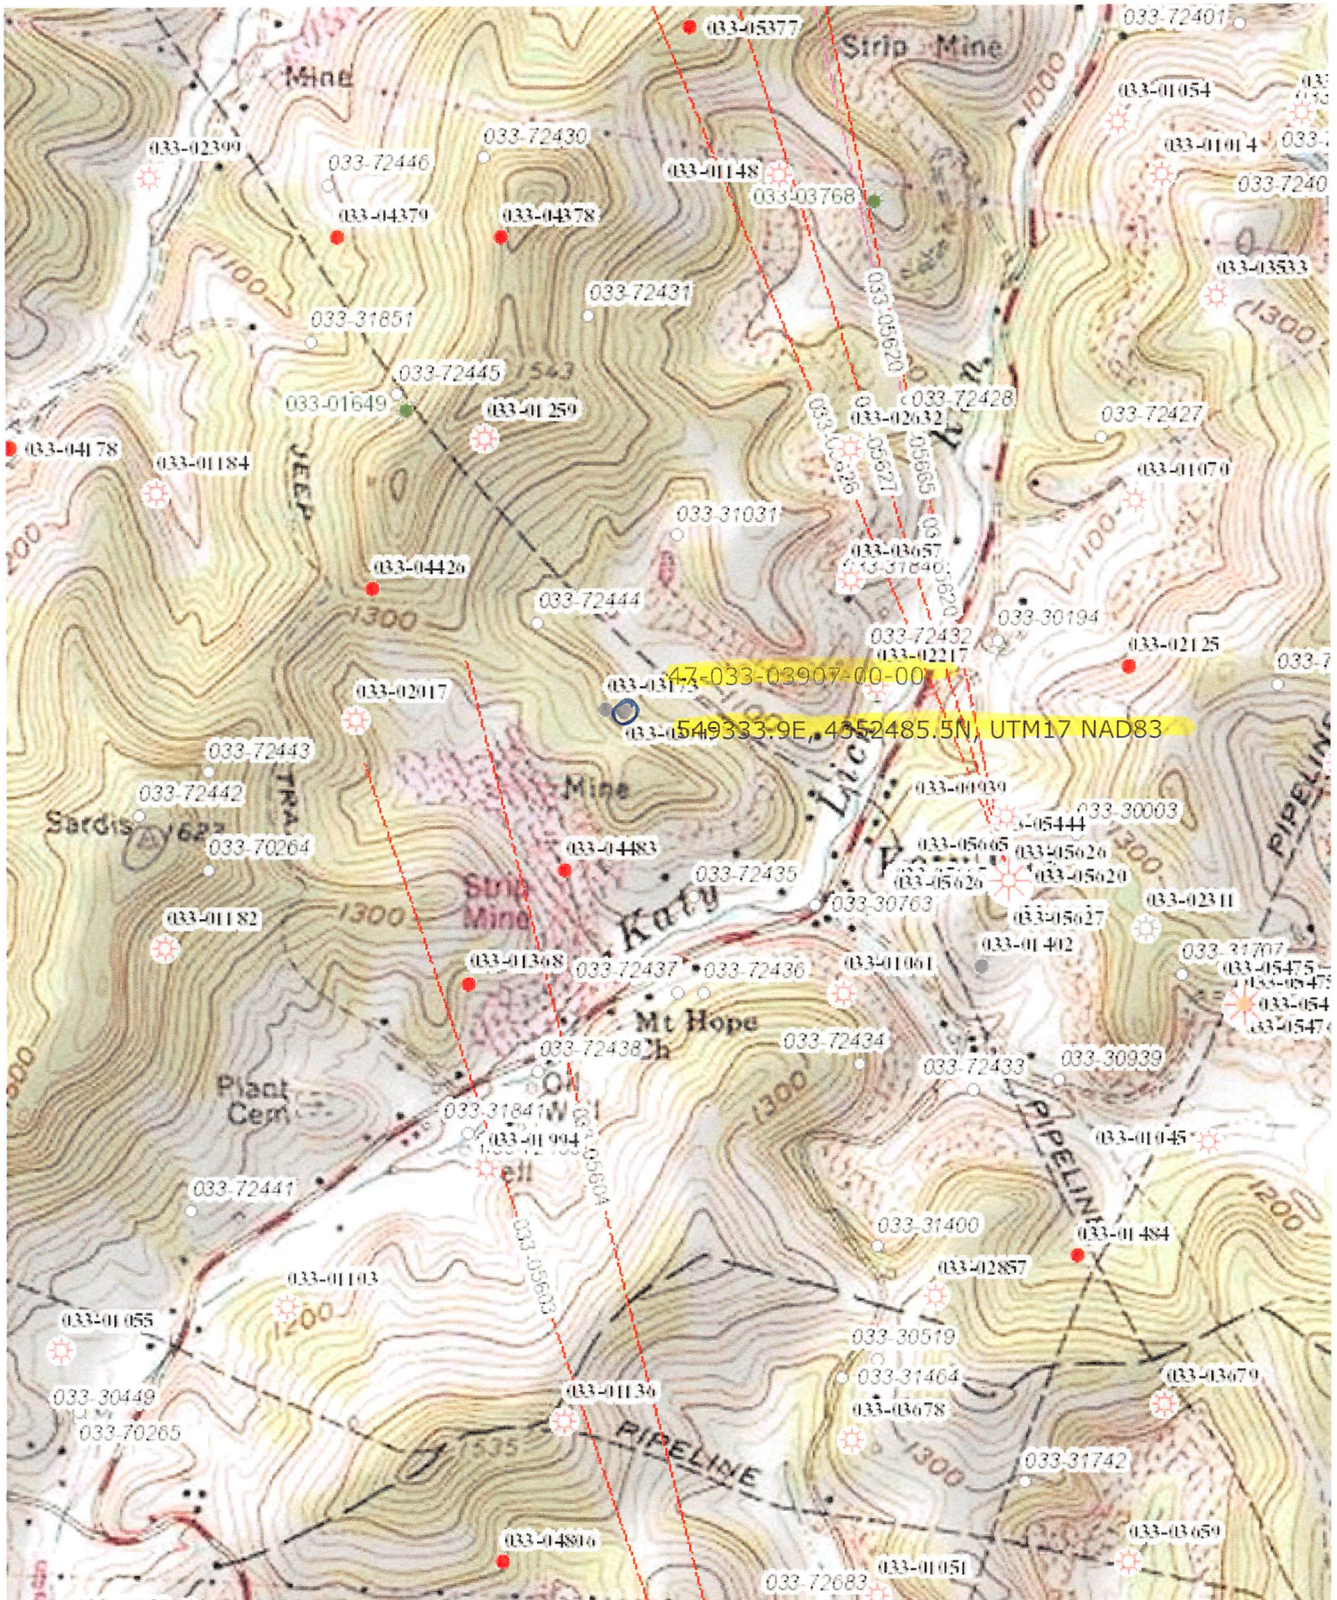

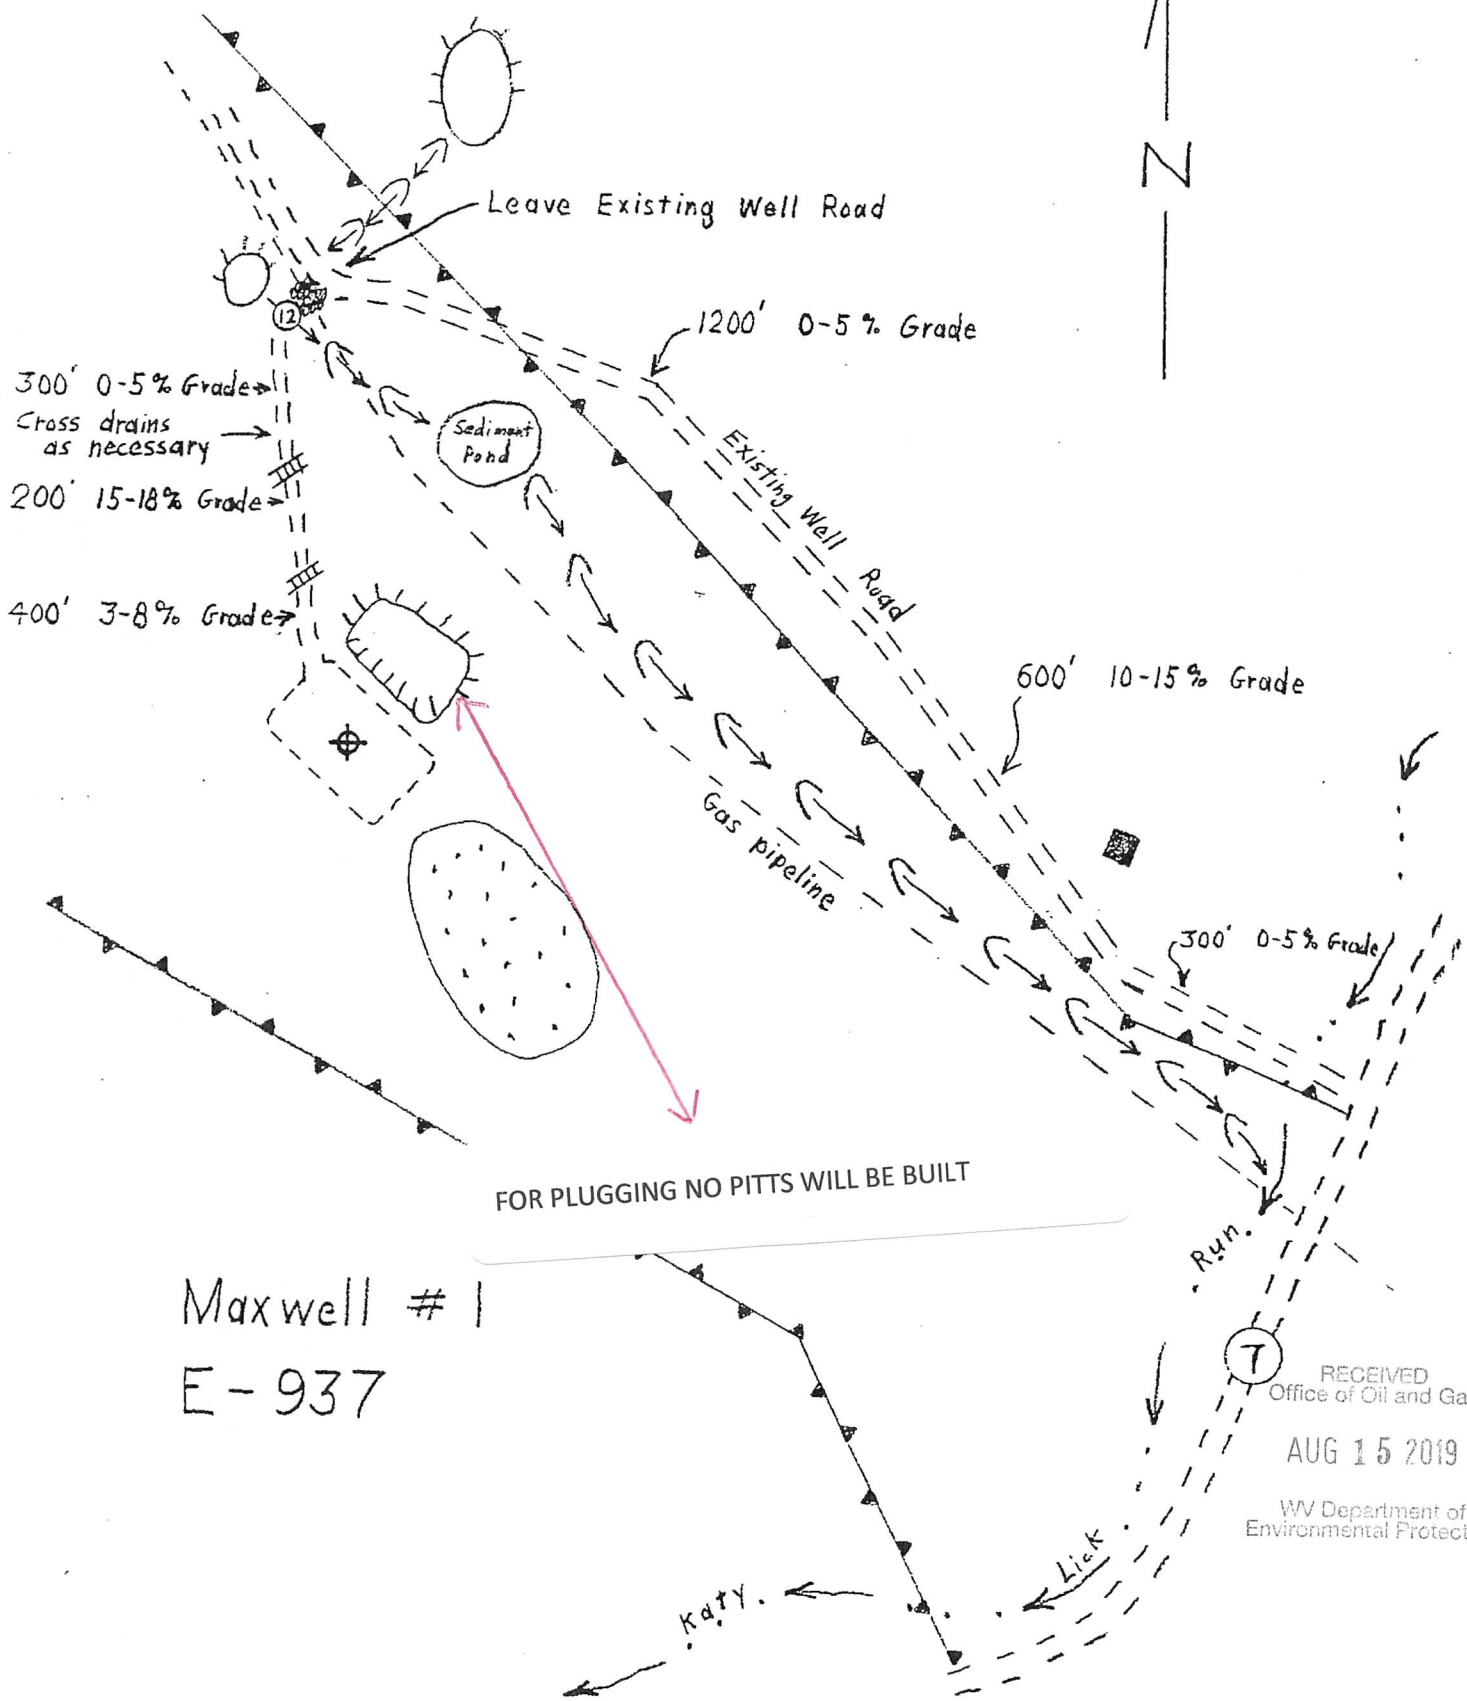

Maxwell # 1  
E-937

RECEIVED  
Office of Oil and Gas  
AUG 15 2019  
WV Department of  
Environmental Protection