

39 22 30

LATITUDE

51 08

LONGITUDE

+ 1.5
1.325
126W

7.5 OGIS topo location

7.5' loc _____ 15' loc 420
_____ (calc.) 127

Company Hope Nat. Gas

Farm Matthew Brooks (2874)

Quad Clarksburg 7.5 & 15 (Ec)

County marion

District clay

WELL LOCATION MAP

File No. C33 3935 N


6.6 Bridgeport - Pruntytown (110)

LOCATION FOR WELL No. **2874**

On **Mc Brooks** Farm, on waters of **Shinn's** DISTRICT
Clay District, **Harrison** County, West Va.

Lease No. **8206** Acres **106** N **8** E **19** W
Scale, one inch equals **200** feet Sent to **12-9-19**

Location to be **Four hundred feet from T. L. Barnes farm and
four hundred feet from Susan Neepers farm.**

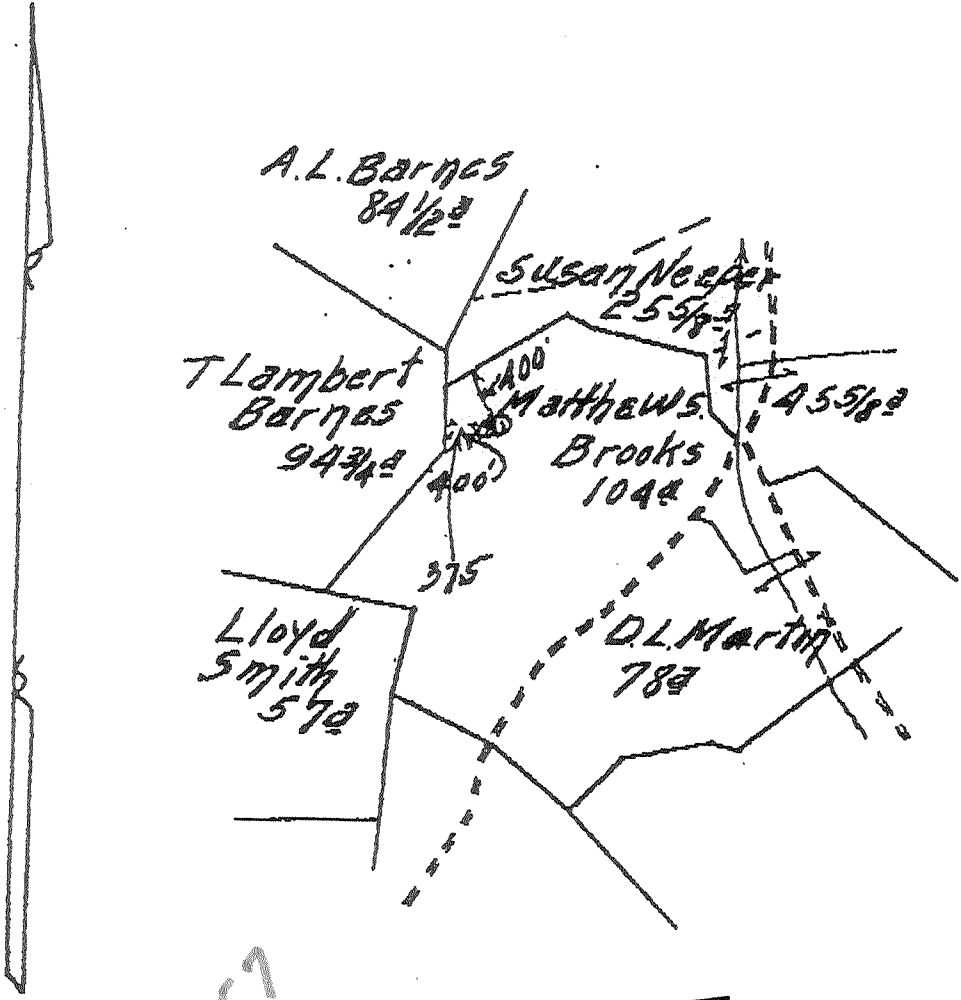

NOT: 013-0657

~~033-3935-N~~

033-3935-N

RESERVE: **200**
SPECIAL INSTRUCTIONS
Consent 10' below
Location made **12-10-12** by **C. G. Cather**
12-11-12 Retained to Pittsburgh **12-17-12**
Location changed on account **2 steep bluffs**
Authorized by **J. B. Carrington** Date **12-11-12**

H
H

(Computer Numbers for Wells Drilled Prior to 1929)

TABLE NO. 5

PERMITS TO DRILL AND WELLS COMPLETED 19 78

SUPPLEMENT SHEET

COUNTY CABELL (47-011)

PERMIT NUMBER	WELL OPERATOR FARM AND WELL NUMBER	PERMIT NUMBER	WELL OPERATOR FARM AND WELL NUMBER
011-0595	Columbia Gas Transmission Corporation Sarah A. Berry # 3941G	013-2649	White Pine Oil & Gas Company Simers Heirs # 1
011-0596	Columbia Gas Transmission Corporation Sewards # 3942G	013-2650	Perkins Oil & Gas Bennett Lease
011-0597	Columbia Gas Transmission Corporation W. E. Cart # 1913G	013-2651	Glenn L. Haught & Sons W. H. Watson # 1
<u>COUNTY</u>	CALHOUN (47-013)	013-2652	Glenn L. Haught & Sons W. H. Watson # 2
013-2640	Cabot Corporation A. Garretson # 3	013-2653	Glenn L. Haught & Sons W. H. Watson # 3
013-2641	Cabot Corporation A. Garretson # 4	013-2654	Glenn L. Haught & Sons W. H. Watson # 4
013-2642	Cabot Corporation A. Hardman # 3	013-2655	Glenn L. Haught & Sons W. H. Watson # 5
013-2643	Cabot Corporation A. Hardman # 4	013-2656	Consolidated Gas Supply Corporation E. C. Knotts # 0942
013-2644	White Pine Oil & Gas Company M. J. Ayers # 1	013-2657 033-3935	Consolidated Gas Supply Corporation M. Brooke # 2874
013-2645	White Pine Oil & Gas Company M. J. Ayers # 2	013-2658	Consolidated Gas Supply Corporation Snodgrass # 2878
013-2647	White Pine Oil & Gas Company Malinda Kight # 1	013-2659	Consolidated Gas Supply Corporation J. Dye # 2879
013-2648	White Pine Oil & Gas Company S. H. Simers # 1	013-2660	Consolidated Gas Supply Corporation P. Jarvis # 3303

HOPE NATURAL GAS COMPANY

ORIGINAL WELL RECORD.

FARM M. S. Brooks, Jr. WELL No. 2874
Buffalo DIST Harrison CO., W. VA
 DRILLING COMMENCED February 10 1913
 DRILLING COMPLETED Mar 13 1913
 CONTRACTOR D. S. Smith

Formation	Top	Bottom	Formation	Top	Bottom
Native Coal			Sayow		
Pgh. Coal	232	240			
Little Dunkard	675	695	Oreod		
Big Dunkard	775	810	Gantz		
Gas Sand	920	935	fifty foot		
1st Salt Sand	965	1020	thirty foot		
2nd Salt Sand	1040	1125	Gordon		
Wash	1125	1445	Gordon		
Little Imp	1560	1575	Fourth		
Peach Cove	1575	1580	17th		
Big Lime	1580	1634	Bayard		
Big Injun	1634		Shinarump		
	1716				
			Total Depth	1730	ft

Casing Size	Put in Well		Pulled Out		Left in Well	
	Feet	Inches	Feet	Inches	Feet	Inches
13 inch						
10 "	290				290	
8 1/4 "	1180				1180	
6 5/8 "	1638				1638	
5 3/16 "						

Have Drillers O. K. for amount of Hole Drilled by Them.

D. S. Smith
Driller
10/13/13
10/13/13
 OVER

~~API# - 033-2657~~

~~013-2657~~

033-3935-N