

West Virginia Department of Environmental Protection  
Office of Oil & Gas

**WELL LOCATION FORM: GPS**

API: 47- 033 - 4061<sup>P</sup> WELL NO: No.22

FARM NAME: P.C. Williams

RESPONSIBLE PARTY NAME: East Resources, Inc.

COUNTY: Harrison DISTRICT: Tenmile

QUADRANGLE: Wolf Summit 7.5'

SURFACE OWNER: Larry & Gregory Ritter

ROYALTY OWNER: East Resources, Inc. et al.

UTM GPS NORTHING: 4,349,822


UTM GPS EASTING: 544,802 GPS ELEVATION: 310 m.

The Responsible Party named above has chosen to submit GPS coordinates in lieu of preparing a new well location plat for a plugging permit on the above well. The Office of Oil & Gas will not accept GPS coordinates that do not meet the following requirements:

1. Datum: NAD 1983, Zone:17 North, Coordinate Units: meters, Altitude: height above mean sea level (MSL) - meters.
2. Accuracy to Datum - 3.05 meters
3. Data Collection Method:

|                   |                                     |                             |                                     |
|-------------------|-------------------------------------|-----------------------------|-------------------------------------|
| Survey Grade GPS  | <input type="checkbox"/>            | Post Processed Differential | <input type="checkbox"/>            |
|                   |                                     | Real-Time Differential      | <input type="checkbox"/>            |
| Mapping Grade GPS | <input checked="" type="checkbox"/> | Post Processed Differential | <input checked="" type="checkbox"/> |
|                   |                                     | Real-Time Differential      | <input type="checkbox"/>            |

I the undersigned, hereby certify this data is correct to the best of my knowledge and belief and shows all the information required by law and the regulations issued and prescribed by the Office of Oil and Gas.

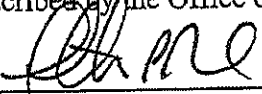
  
Signature Timothy P. Roush

Professional Surveyor  
Title

June 4, 2012  
Date

SUBJECT WELL  
P.C. Williams No.22  
47-033-4061

33-04061F

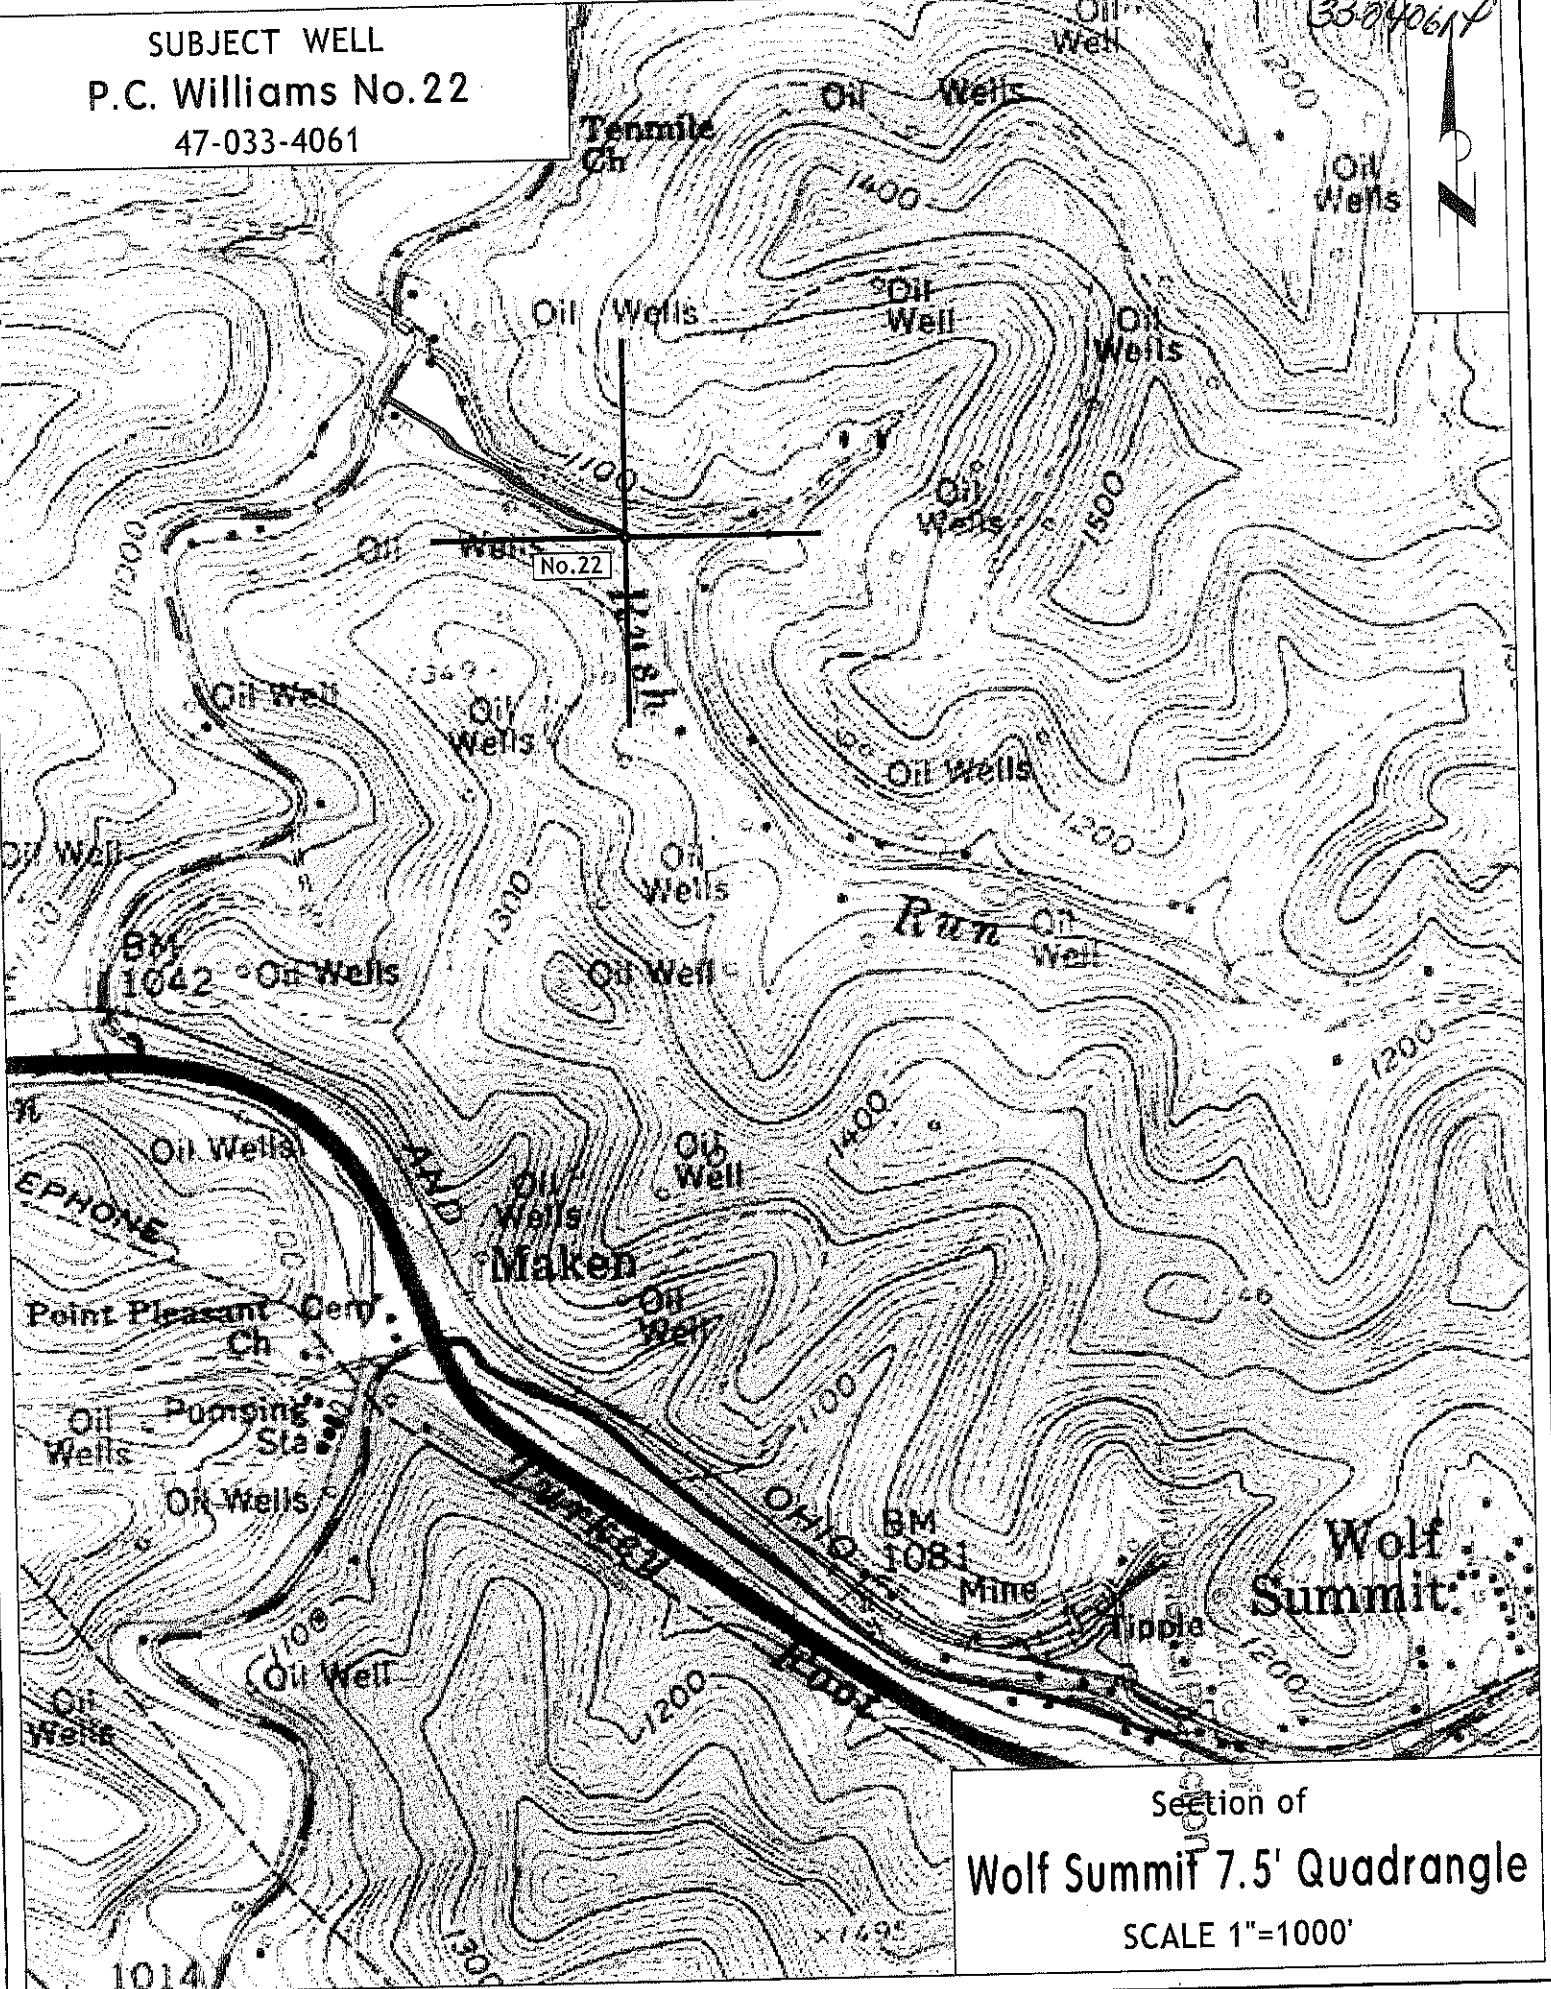

Section of  
Wolf Summit 7.5' Quadrangle  
SCALE 1"=1000'