



west virginia department of environmental protection

Office of Oil and Gas
601 57th Street SE
Charleston, WV 25304
(304) 926-0450
(304) 926-0452 fax

Earl Ray Tomblin, Governor
Randy C. Huffman, Cabinet Secretary
www.dep.wv.gov

March 22, 2016

FINAL INSPECTION REPORT

Re-Work Permit Cancelled

HG ENERGY, LLC,

The FINAL INSPECTION REPORT for the CANCELLED permit, API Well Number:
47-3304066, issued to HG ENERGY, LLC, and listed below has been received in this office.
The permit has been cancelled as of 3/17/2016.

James Martin
Chief

Operator: HG ENERGY, LLC
Operator's Well No: E. A. DUNCAN 8
Farm Name: BALDINGER, JAMES E.
API Well Number: 47-3304066
Date Issued: 07/30/2014

Date Cancelled: 03/17/2016

Promoting a healthy environment.

04/01/2016

Longitude = 80° 27' 37.6" 600"

LATITUDE 39° 20' 00"

UTM Coordinates (NAD83) Meters
N - 4,350,235
E - 546,540


LONGITUDE 80° 27' 30"

12,080'

Latitude = 39° 18' 00.6"

NOTES ON SURVEY


- 1 - The survey shown hereon is from original drilling permit dated August 17, 1994.
- 2 - Plat has been updated to show as-drilled Latitude/Longitude information and current surface owner information.
- 3 - Latitude and Longitude established by DGPS (Sub-meter Mapping Grade).

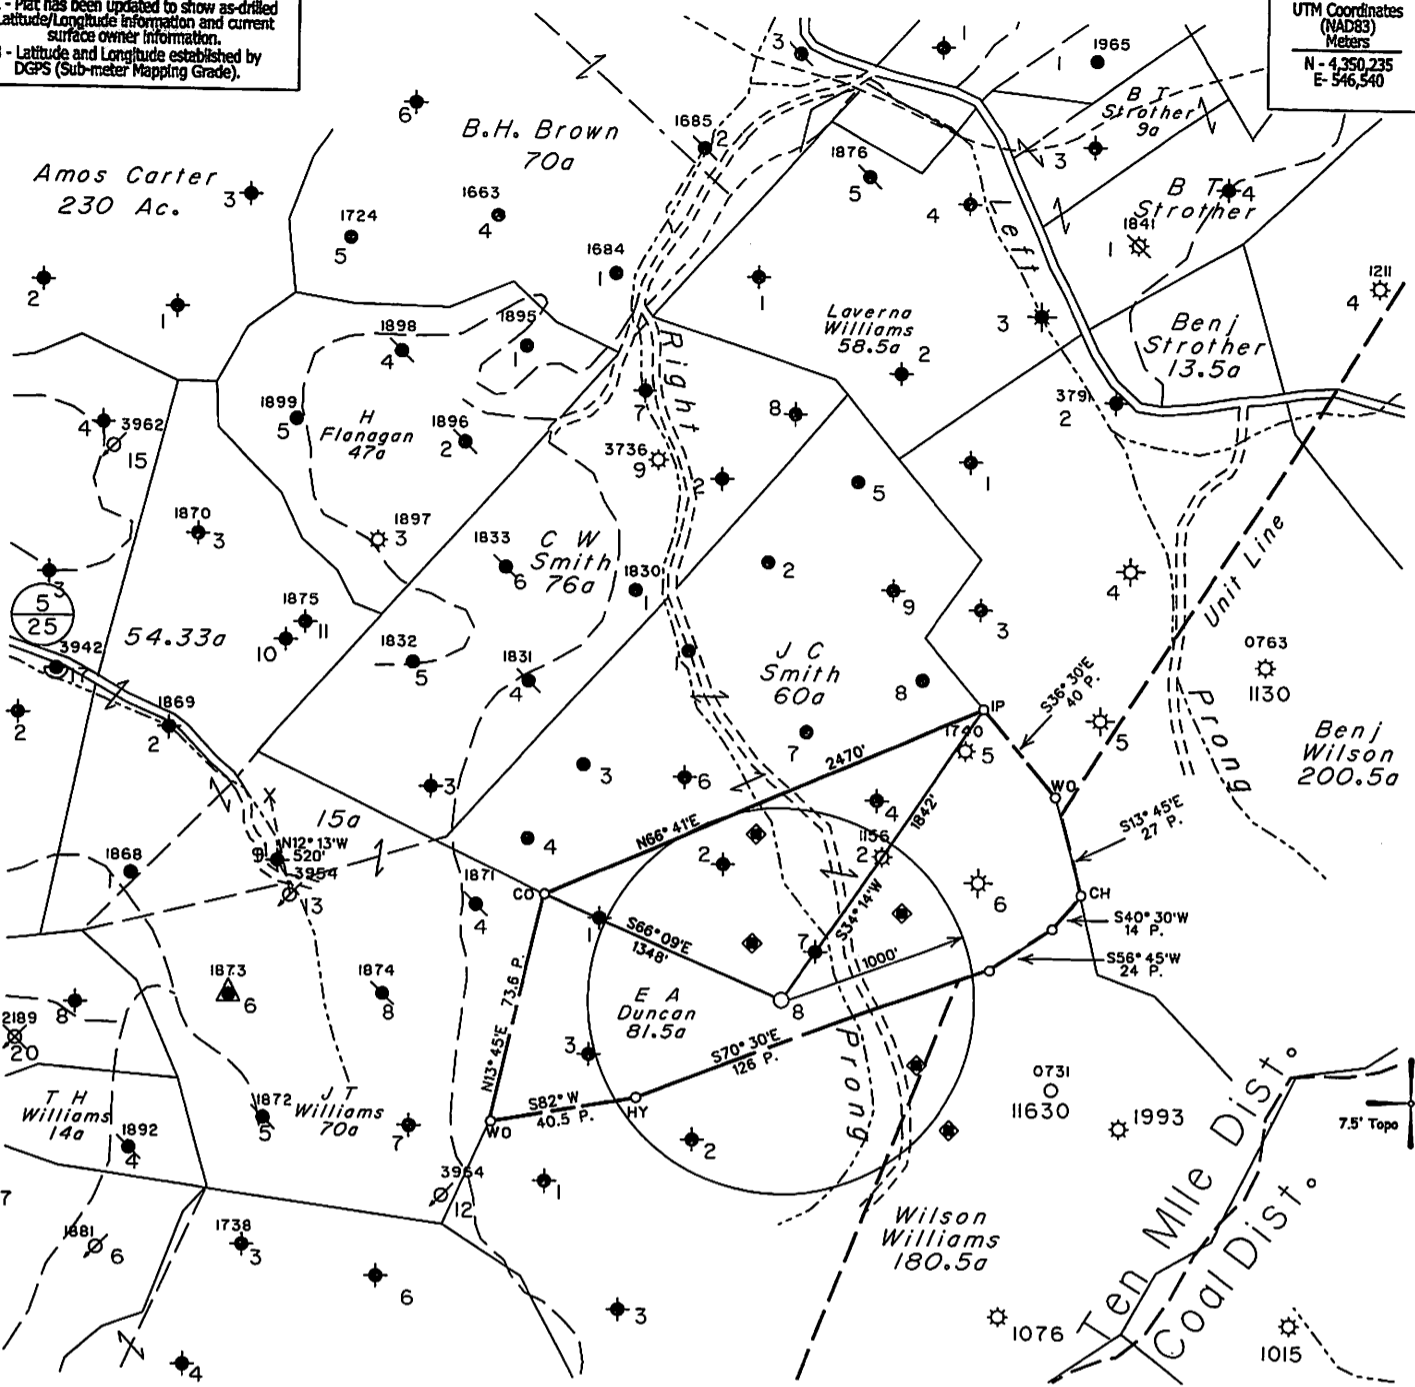

- DENOTES LOCATION OF WELL ON UNITED STATES TOPOGRAPHIC MAPS.

FILE NO. _____
 MAP NO. N S E W
 SCALE 1" = 1000'
 MINIMUM DEGREE OF ACCURACY _____
 PROVEN SOURCE OF ELEVATION WVDEP Record Elevation

I THE UNDERSIGNED, HEREBY CERTIFY THAT THIS PLAT IS CORRECT TO THE BEST OF MY KNOWLEDGE AND BELIEF AND SHOWS ALL THE INFORMATION REQUIRED BY LAW AND THE REGULATIONS ISSUED AND PRESCRIBED BY THE DEPARTMENT OF MINES.
 (SIGNED) *[Signature]*
 TIMOTHY P. ROUSH PS 793

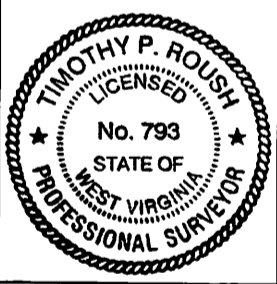

WEST VIRGINIA
 Division of Environmental Protection
 Office of Oil and Gas
 601 57th Street
 Charleston, West Virginia 25301



DATE June 11, 2014
 FARM E.A. Duncan No.8
 API WELL NO. 47-033-04066

CANCELLED

WELL TYPE: OIL GAS LIQUID INJECTION _____ WASTE DISPOSAL _____
 (IF "GAS") PRODUCTION STORAGE _____ DEEP _____ SHALLOW
 LOCATION: ELEVATION 1,187' WATERSHED Right Prong of New Creek
 DISTRICT Tenmile COUNTY Harrison
 QUADRANGLE Wolf Summit 7.5'

SURFACE OWNER Arthur Stollar ACREAGE 51.50 Ac.
 OIL & GAS ROYALTY OWNER HG Energy, LLC., et al LEASE ACREAGE 81.5 Ac. 04/01/2016
 LEASE NO. 33317-50

PROPOSED WORK: DRILL _____ CONVERT DRILL DEEPER _____ REDRILL _____ FRACTURE OR STIMULATE PLUG OFF OLD FORMATION PERFORATE NEW FORMATION _____ OTHER PHYSICAL CHANGE IN WELL (SPECIFY) Plug Back to 2,600' & Stimulate Gordon & Maxton Sands

PLUG AND ABANDON _____ CLEAN OUT AND REPLUG _____
 TARGET FORMATION Gordon, Maxton ESTIMATED DEPTH 2,600' PBD

WELL OPERATOR HG Energy LLC. DESIGNATED AGENT Diane White
 ADDRESS 5260 DuPont Road ADDRESS 5260 DuPont Road
Parkersburg, WV 26101 Parkersburg, WV 26101