

WW-7
8-30-06



West Virginia Department of Environmental Protection
Office of Oil and Gas

WELL LOCATION FORM: GPS

API: 47-033-04158 WELL NO.: E-231

FARM NAME: Morris

RESPONSIBLE PARTY NAME: XTO Energy, Inc.

COUNTY: Harrison DISTRICT: Tenmile

QUADRANGLE: Wolf Summit

SURFACE OWNER: See attached list

ROYALTY OWNER: See attached list

UTM GPS NORTHING: 4353979.1

UTM GPS EASTING: 546409.5 GPS ELEVATION: 332 meters 1088ft

The Responsible Party named above has chosen to submit GPS coordinates in lieu of preparing a new well location plat for a plugging permit or assigned API number on the above well. The Office of Oil and Gas will not accept GPS coordinates that do not meet the following requirements:

1. Datum: NAD 1983, Zone: 17 North, Coordinate Units: meters, Altitude: height above mean sea level (MSL) – meters.

2. Accuracy to Datum – 3.05 meters

3. Data Collection Method:

Survey grade GPS : Post Processed Differential

Real-Time Differential

Mapping Grade GPS : Post Processed Differential

Real-Time Differential

4. Letter size copy of the topography map showing the well location.

I the undersigned, hereby certify this data is correct to the best of my knowledge and belief and shows all the information required by law and the regulations issued and prescribed by the Office of Oil and Gas.

Signature


Project Manager
Title

August 11, 2015
Date

11/27/2015

Received
Office of Oil & Gas

NOV 06 2015

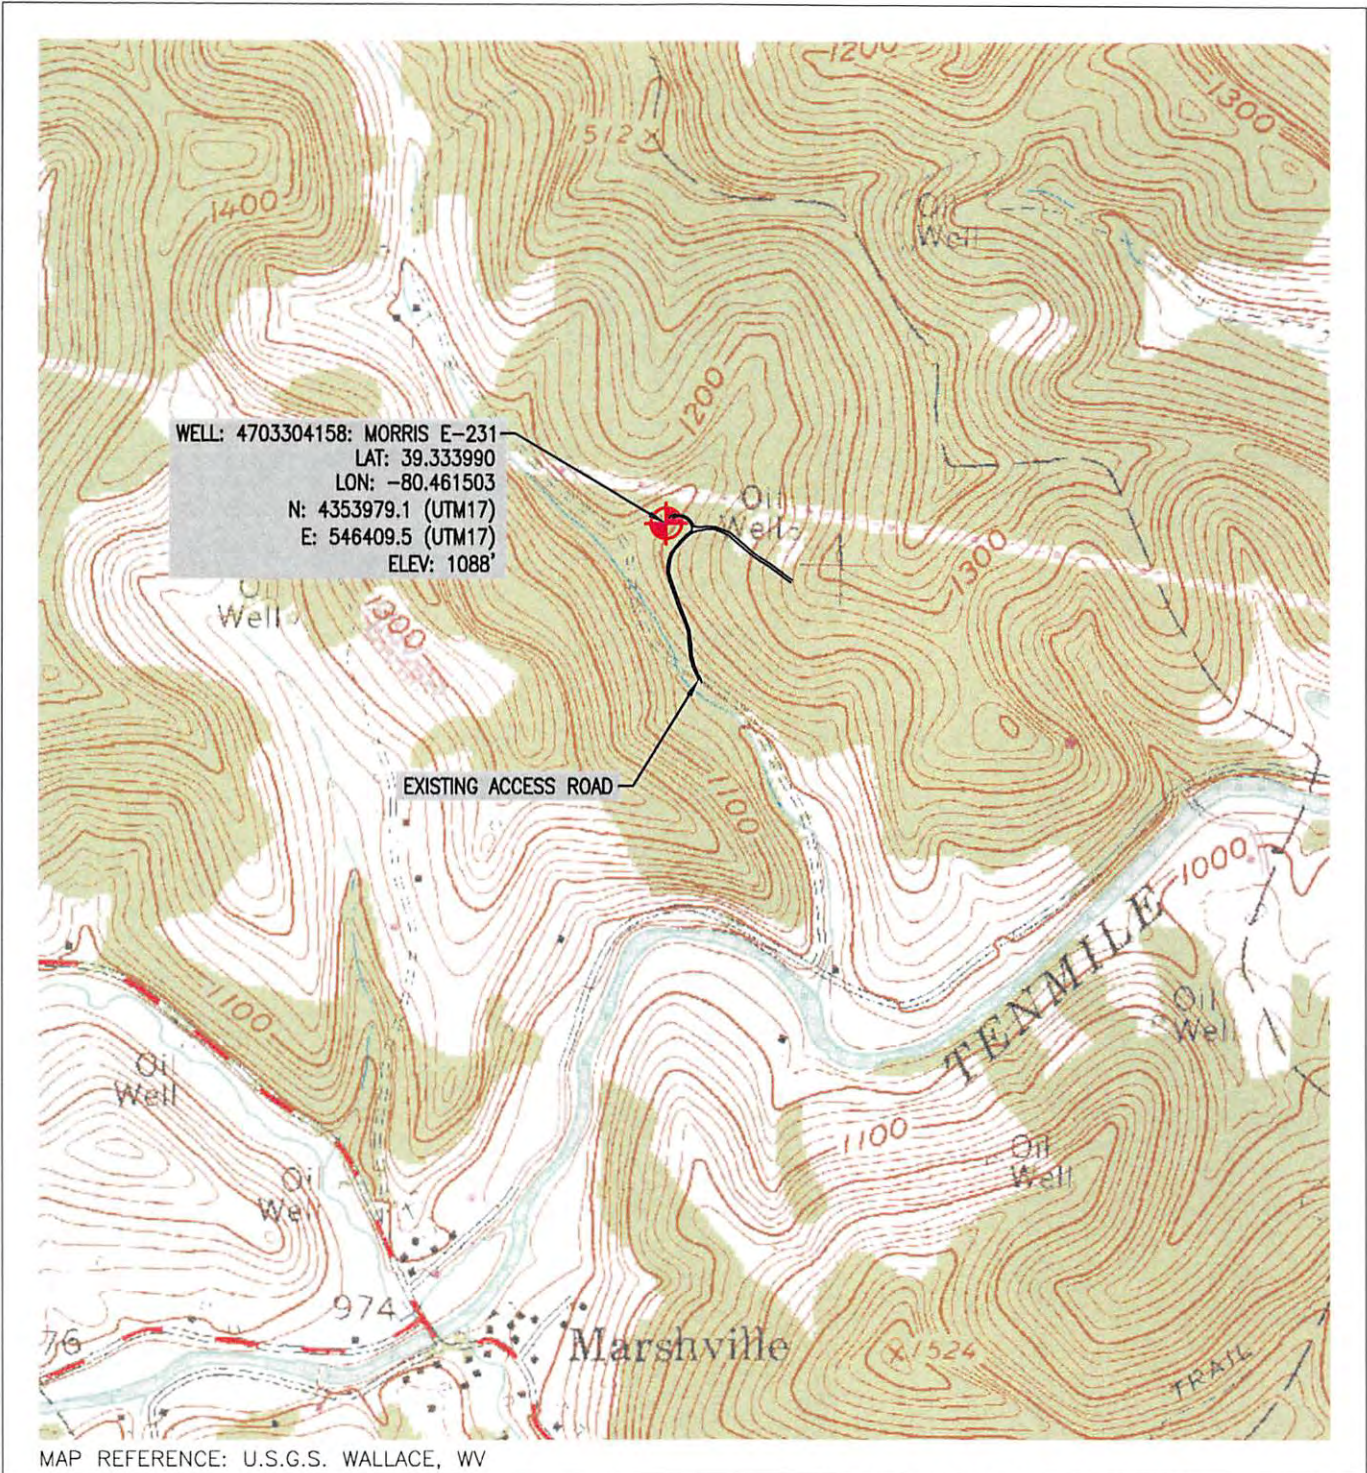


WELL: 4703304158: MORRIS E-231
 LAT: 39.333990
 LON: -80.461503
 N: 4353979.1 (UTM17)
 E: 546409.5 (UTM17)
 ELEV: 1088'

MAP REFERENCE: U.S.G.S. WALLACE, WV



810 HOUSTON STREET
 FORT WORTH, TX 76102

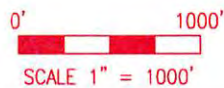

Voice: (724) 635-0210

TRI-COUNTY ENGINEERING, LLC

An ENERCON Company
 319 Paintersville Road
 Hunker, PA 15639
 www.tricountyeng.com

Fax: (724) 635-0676



Excellence-Every project. Every day.

LOCATION MAP	
MORRIS E-231 WELL PLUG	
DRAWN BY: BMK	TENMILE DISTRICT, HARRISON COUNTY, WEST VIRGINIA
DATE: 7/13/15	SHEET: FILE NO.
SCALE: AS NOTED	1 OF 1 OG61-03

11/27/2015
 Received
 Office of Oil & Gas
 NOV 06 2015