

LONGITUDE 80° 27' 30"
Latitude - 39° 16' 58.8"
3,150'

No. 108
UTM Coordinates
(NAD83)
Meters
N - 4,348,315
E - 543,647

PLAT NOTES

- The drawing shown hereon is from the original drilling permit plat dated 6/27/2007.
- This plat has been updated to show current surface ownership and as-drilled Latitude & Longitude.


| CALL TABLE | |
|-----------------------|-----------------------|
| (A) N75° 14'E 606.06' | (B) N4° 09'W 375.89' |
| (C) N80° 40'E 1020.5' | (D) S89° 25'E 264.00' |
| (E) S57° 17'E 379.92' | (F) S80° 00'E 483.21' |
| (G) N80° 31'E 260.33' | (H) S84° 57'E 98.02' |
| (I) S73° 48'E 138.43' | (J) S89° 39'E 266.94' |
| (K) S15° 59'E 58.69' | (L) N28° 30'E 66.00' |
| (M) N56° 30'E 107.25' | (N) S40° 00'W 99.00' |

⊕ DENOTES LOCATION OF WELL ON UNITED STATES TOPOGRAPHIC MAPS.

FILE NO. _____
 MAP NO. _____ N _____ S _____ E _____ W _____
 SCALE _____ 1" = 1000'
 MINIMUM DEGREE OF ACCURACY _____ Sub-Meter DGPS
 PROVEN SOURCE OF ELEVATION _____ DGPS Survey

I THE UNDERSIGNED, HEREBY CERTIFY THAT THIS PLAT IS CORRECT TO THE BEST OF MY KNOWLEDGE AND BELIEF AND SHOWS ALL THE INFORMATION REQUIRED BY LAW AND THE REGULATIONS ISSUED AND PRESCRIBED BY THE DEPARTMENT OF MINES.

(SIGNED) *[Signature]*
 TIMOTHY P. ROUSH PS 793

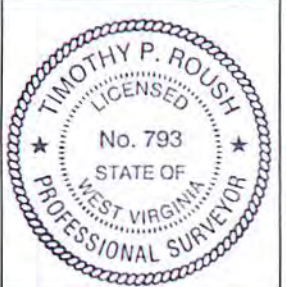

WEST VIRGINIA
 Division of Environmental Protection
 Office of Oil and Gas
 601 57th Street
 Charleston, West Virginia 25304



DATE February 19, 2015
 FARM Hiram Lynch No. 108
 API WELL NO. 47 - 033 - 04905


WELL TYPE: OIL _____ GAS _____ LIQUID INJECTION WASTE DISPOSAL _____ CORE _____
 (IF "GAS") PRODUCTION _____ STORAGE _____ DEEP _____ SHALLOW _____
 LOCATION: ELEVATION 1,188' WATERSHED Wizardism Run
 DISTRICT Ten Mile COUNTY Harrison
 QUADRANGLE Wolf Summit 7.5'
 SURFACE OWNER Kenneth & Deborah Gaskins ACREAGE 83.5 Ac.
 OIL & GAS ROYALTY OWNER Anne Farr et al. LEASE ACREAGE 568 Ac.
 LEASE NO. 31378-50
 PROPOSED WORK: DRILL _____ CONVERT _____ DRILL DEEPER _____ REDRILL _____ FRACTURE OR STIMULATE PLUG OFF OLD FORMATION _____ PERFORATE NEW FORMATION _____ OTHER PHYSICAL CHANGE IN WELL (SPECIFY) _____
 PLUG AND ABANDON _____ CLEAN OUT AND REPLUG _____
 TARGET FORMATION Fifth Sand ESTIMATED DEPTH 2,960'
 WELL OPERATOR HG Energy LLC. DESIGNATED AGENT Diane White
 ADDRESS 5260 DuPont Road Parkersburg, WV 26101 ADDRESS 5260 DuPont Road Parkersburg, WV 26101

05/08/2015

FORM IV-6

3304905sw

SUBJECT WELL
Hiram Lynch No.108
47-033-4905

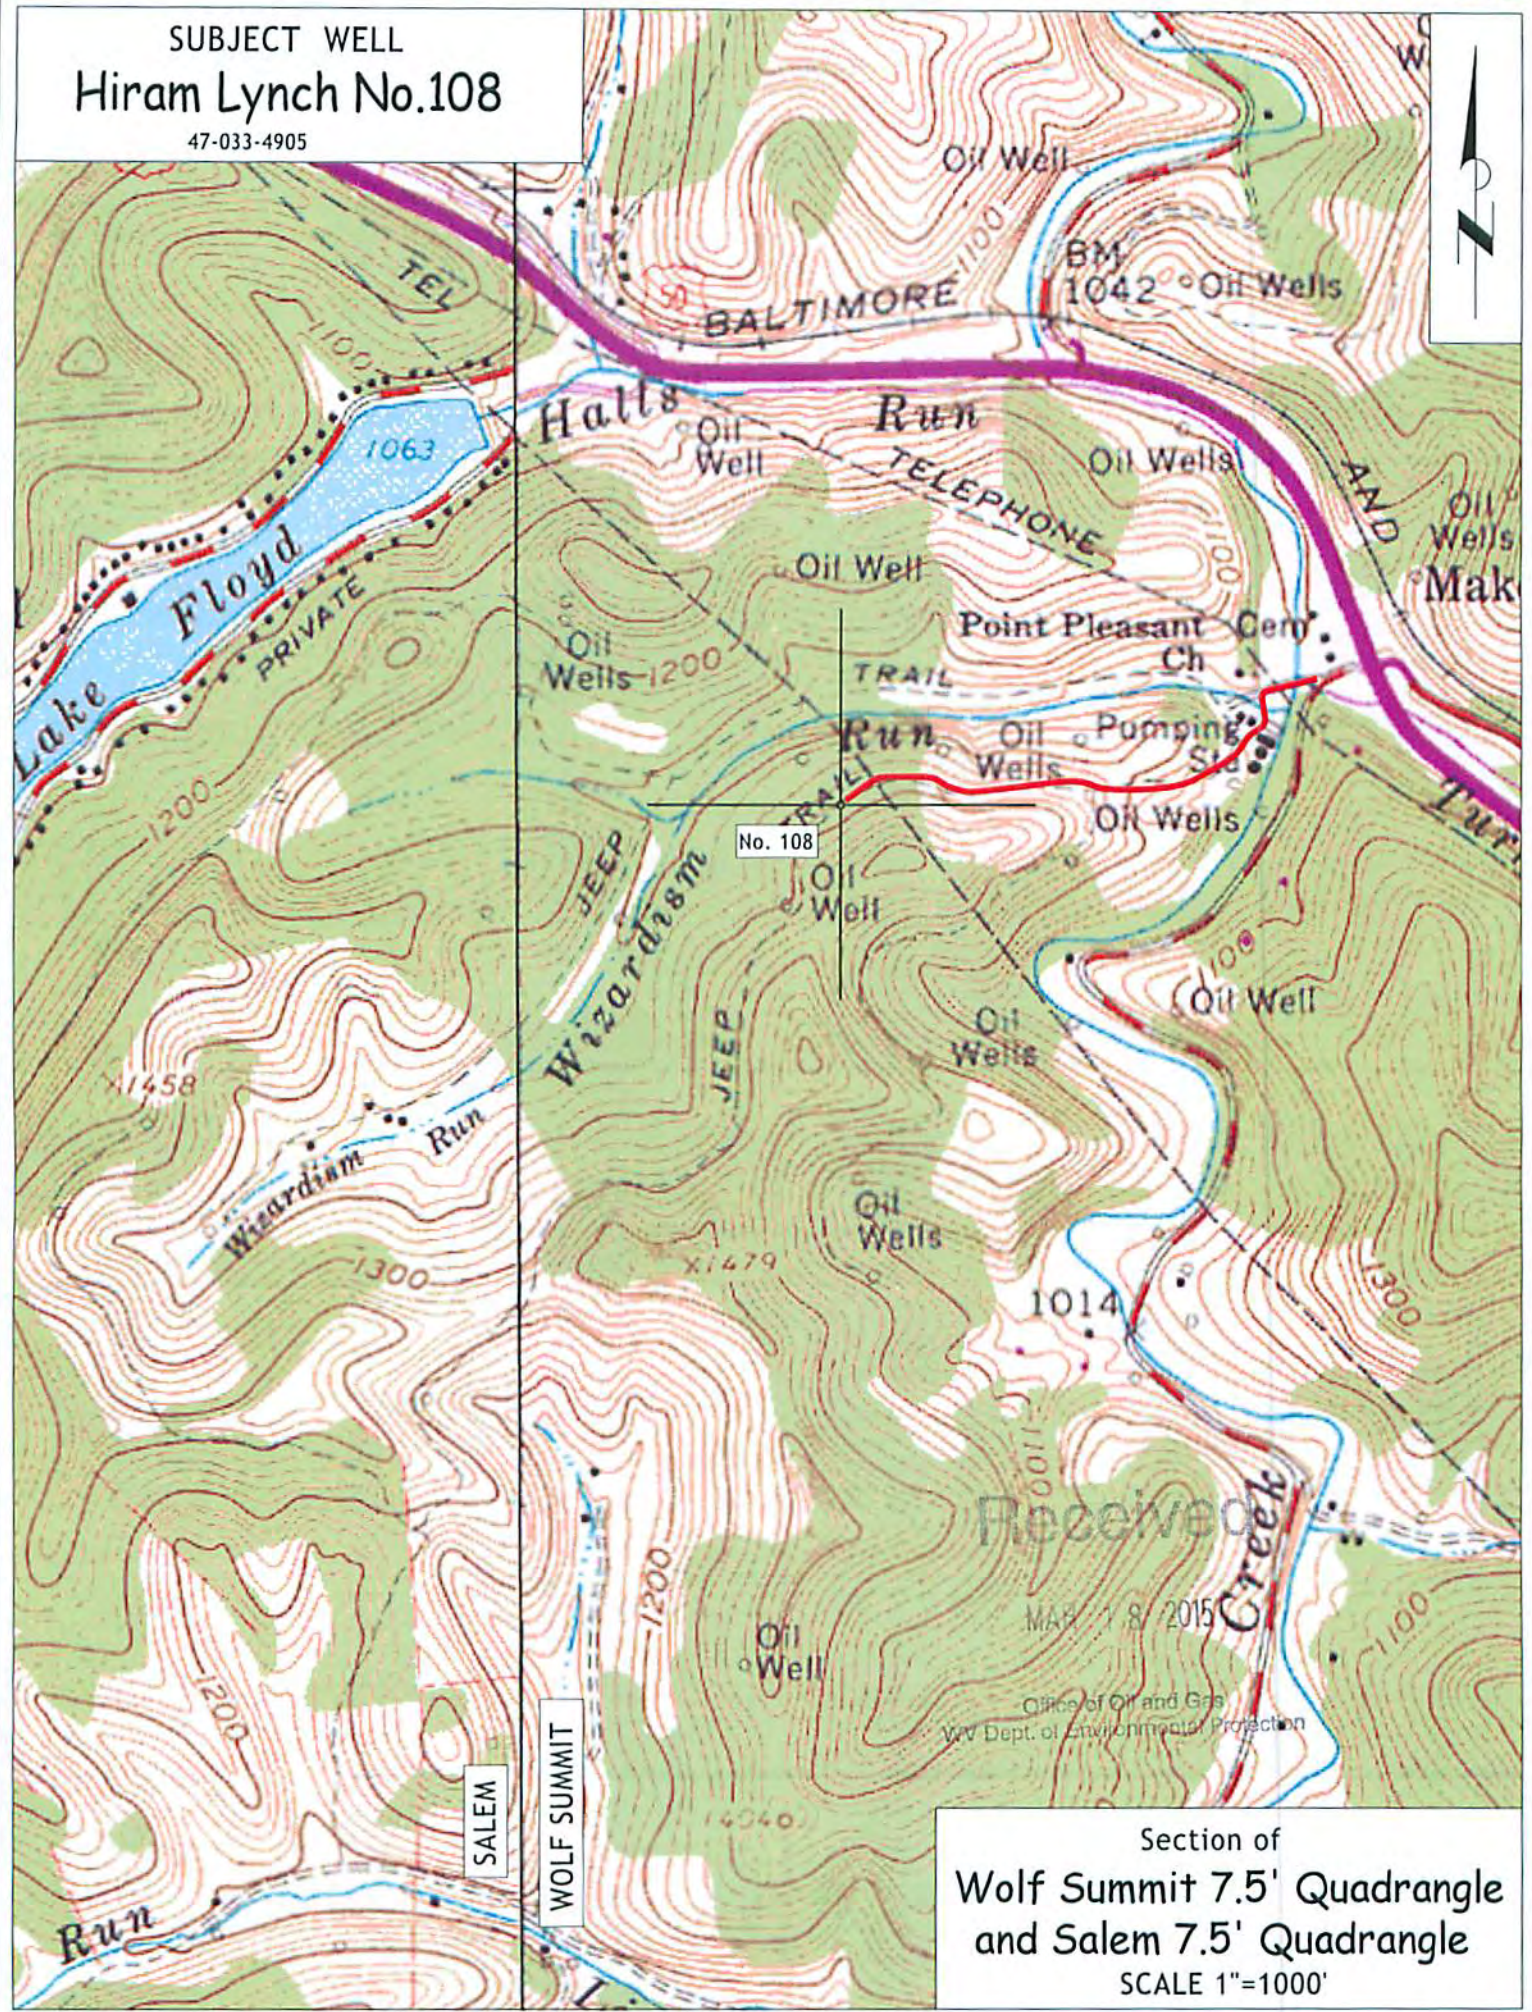

MAR 18 2015
Office of Oil and Gas
WV Dept. of Environmental Protection

Section of
Wolf Summit 7.5' Quadrangle
and Salem 7.5' Quadrangle
SCALE 1"=1000'

SALEM

WOLF SUMMIT